


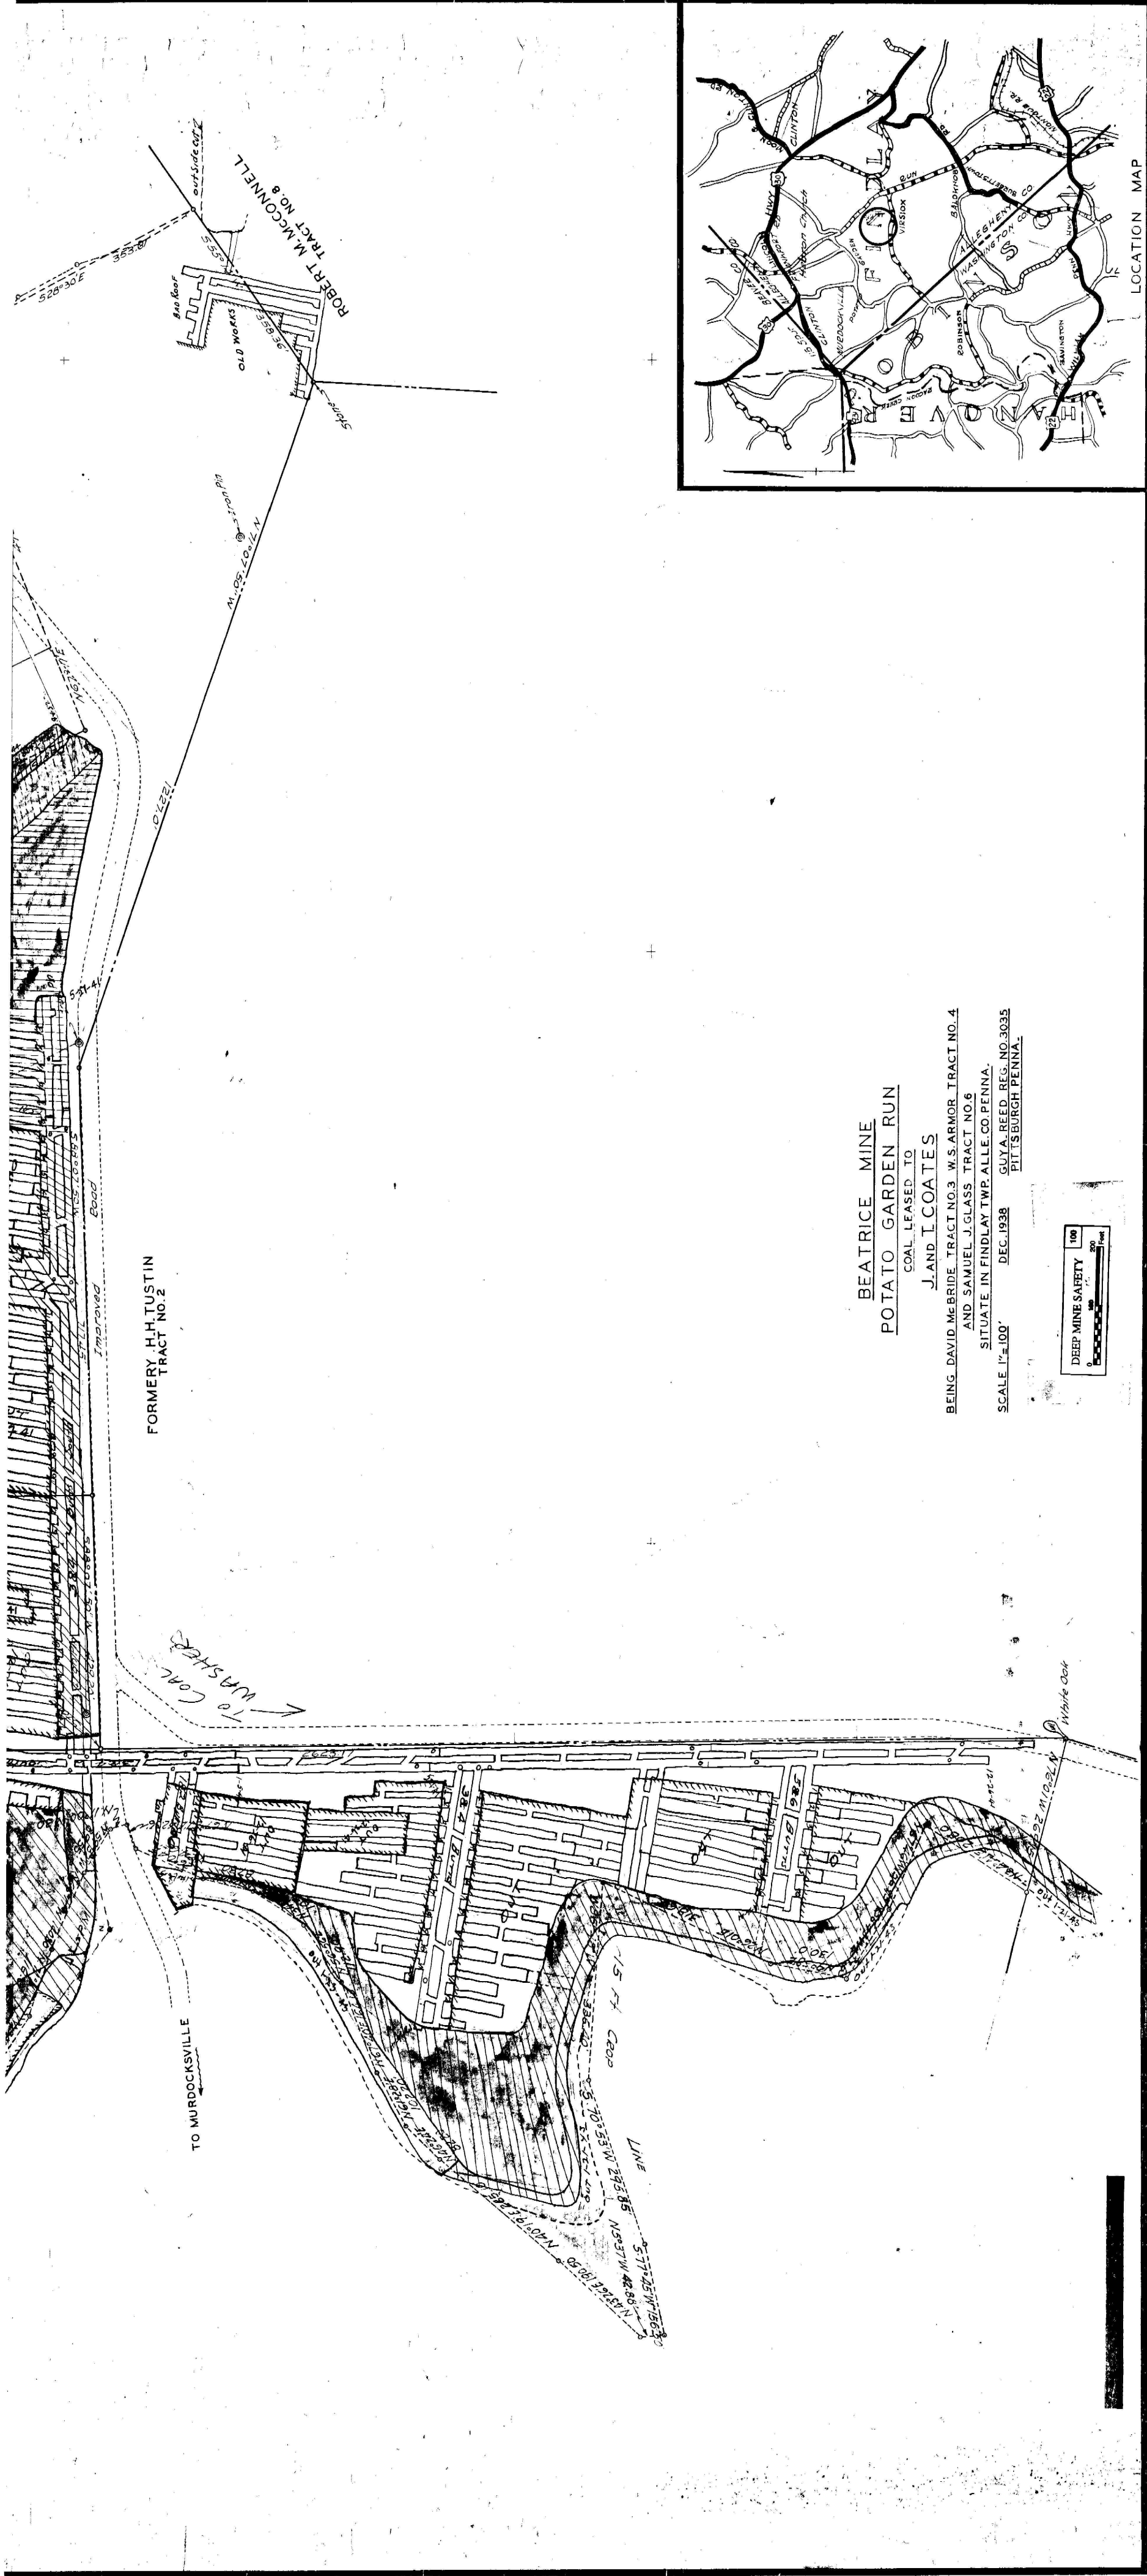

BEATRICE MINE
POTATO GARDEN RUN

COAL LEASED TO
J. AND I. COATES

BING DAVID McBRIDE TRACT NO. 3 W.S. ARMOR TRACT NO. 4
AND SAMUEL J. GLASS TRACT NO. 6

SITUATE IN FINDLAY TWP. ALLE CO. PENNA.

SCALE 1"=100' DEC. 1938

GUYA REED REG. NO. 3035
PITTSBURGH PENNA.

