


"A"	is for survey of July 23, 1924
"B"	" " " " " " " " Aug. 29, 1924
"C"	" " " " " " " " Dec. 16, 1924
"D"	" " " " " " " " April 13, 1925
"E"	" " " " " " " " July 7, 1925
"F"	" " " " " " " " Sept. 26, 1925
"G"	" " " " " " " " Dec. 23, 1925
"H"	" " " " " " " " Apr. 9, 1926
"I"	" " " " " " " " July 8, 1926
"J"	" " " " " " " " Oct. 29, 1926
"K"	" " " " " " " " Jan. 21, 1927
"L"	" " " " " " " " May 12, 1927
"M"	" " " " " " " " Aug. 27, 1927
"N"	" " " " " " " " Dec. 9, 1927
"O"	" " " " " " " " June 26, 1928
"P"	" " " " " " " " Jan. 13, 1929
"Q"	" " " " " " " " July 21, 1929
"R"	" " " " " " " " Dec. 21, 1929
"S"	" " " " " " " " June 25, 1930
"T"	" " " " " " " " Nov. 26, 1930
"U"	" " " " " " " " June 29, 1931
	FINIS.

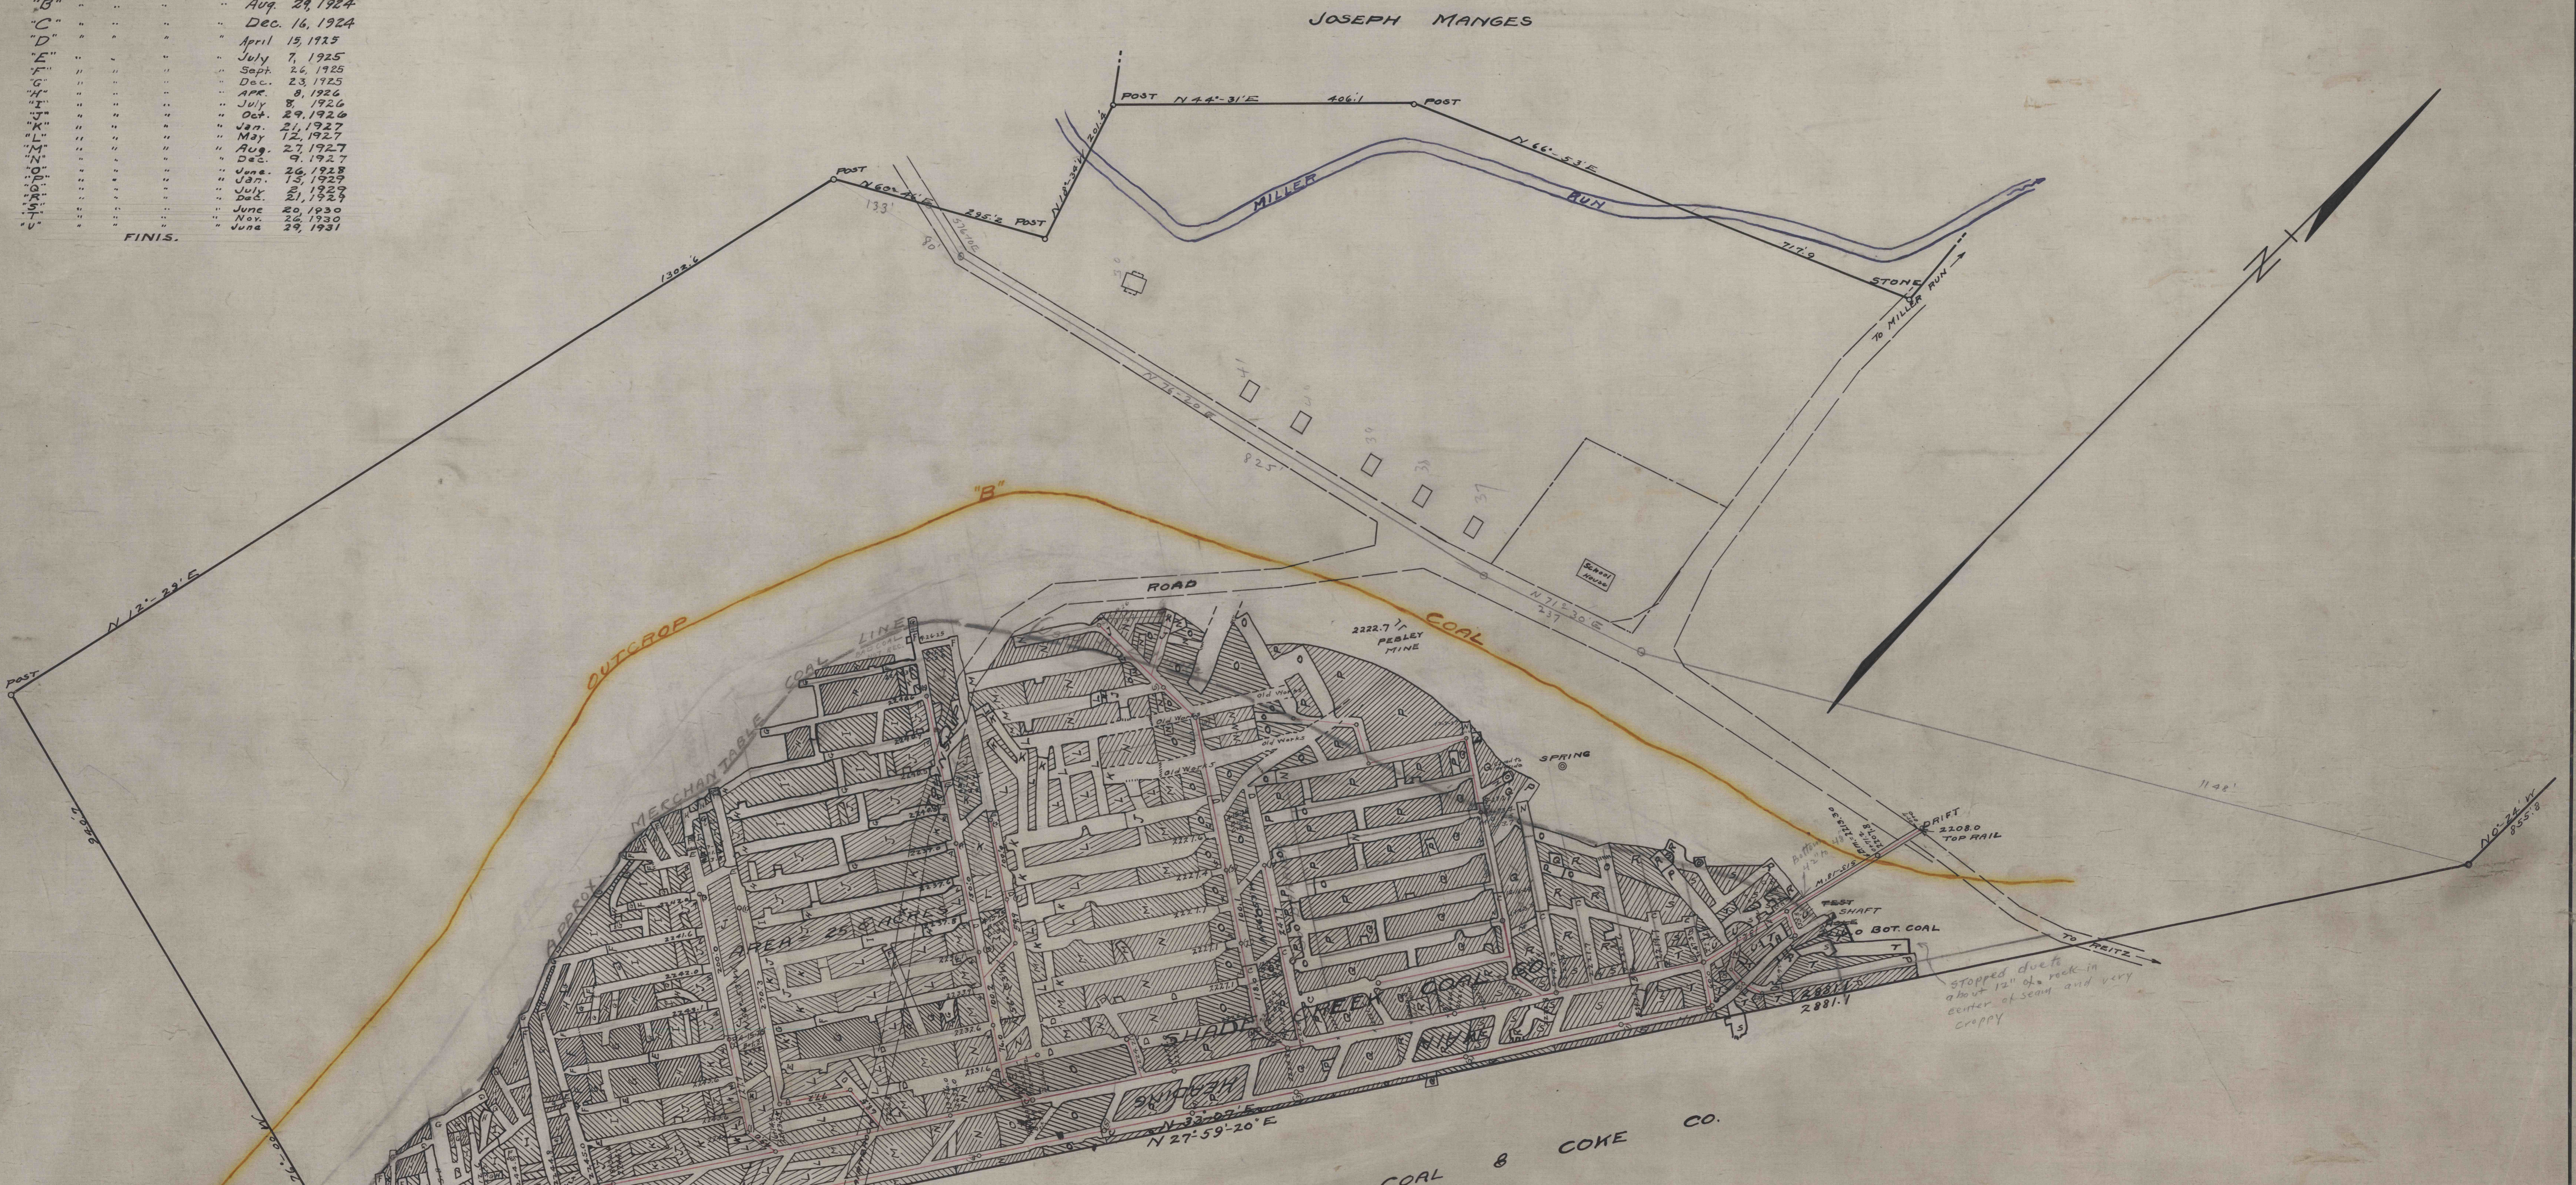

**MAP**  
 SHOWING PROPERTY AND MINING OPERATIONS  
 OF THE  
**SHADE CREEK COAL CO.**  
 (PEBLEY TRACT)  
 SITUATE IN  
 SHADE TWP. SOMERSET CO. PA.  
 AUG. 9, 1916      SCALE: 1"=100'  
 FETTERMAN ENG. CO.