


C.F. MCGOWAN  


Remains of Workings  
Shown on Dory Map


ELLIOT SHAFER  

W.E. SHARER

15 AC. RES.

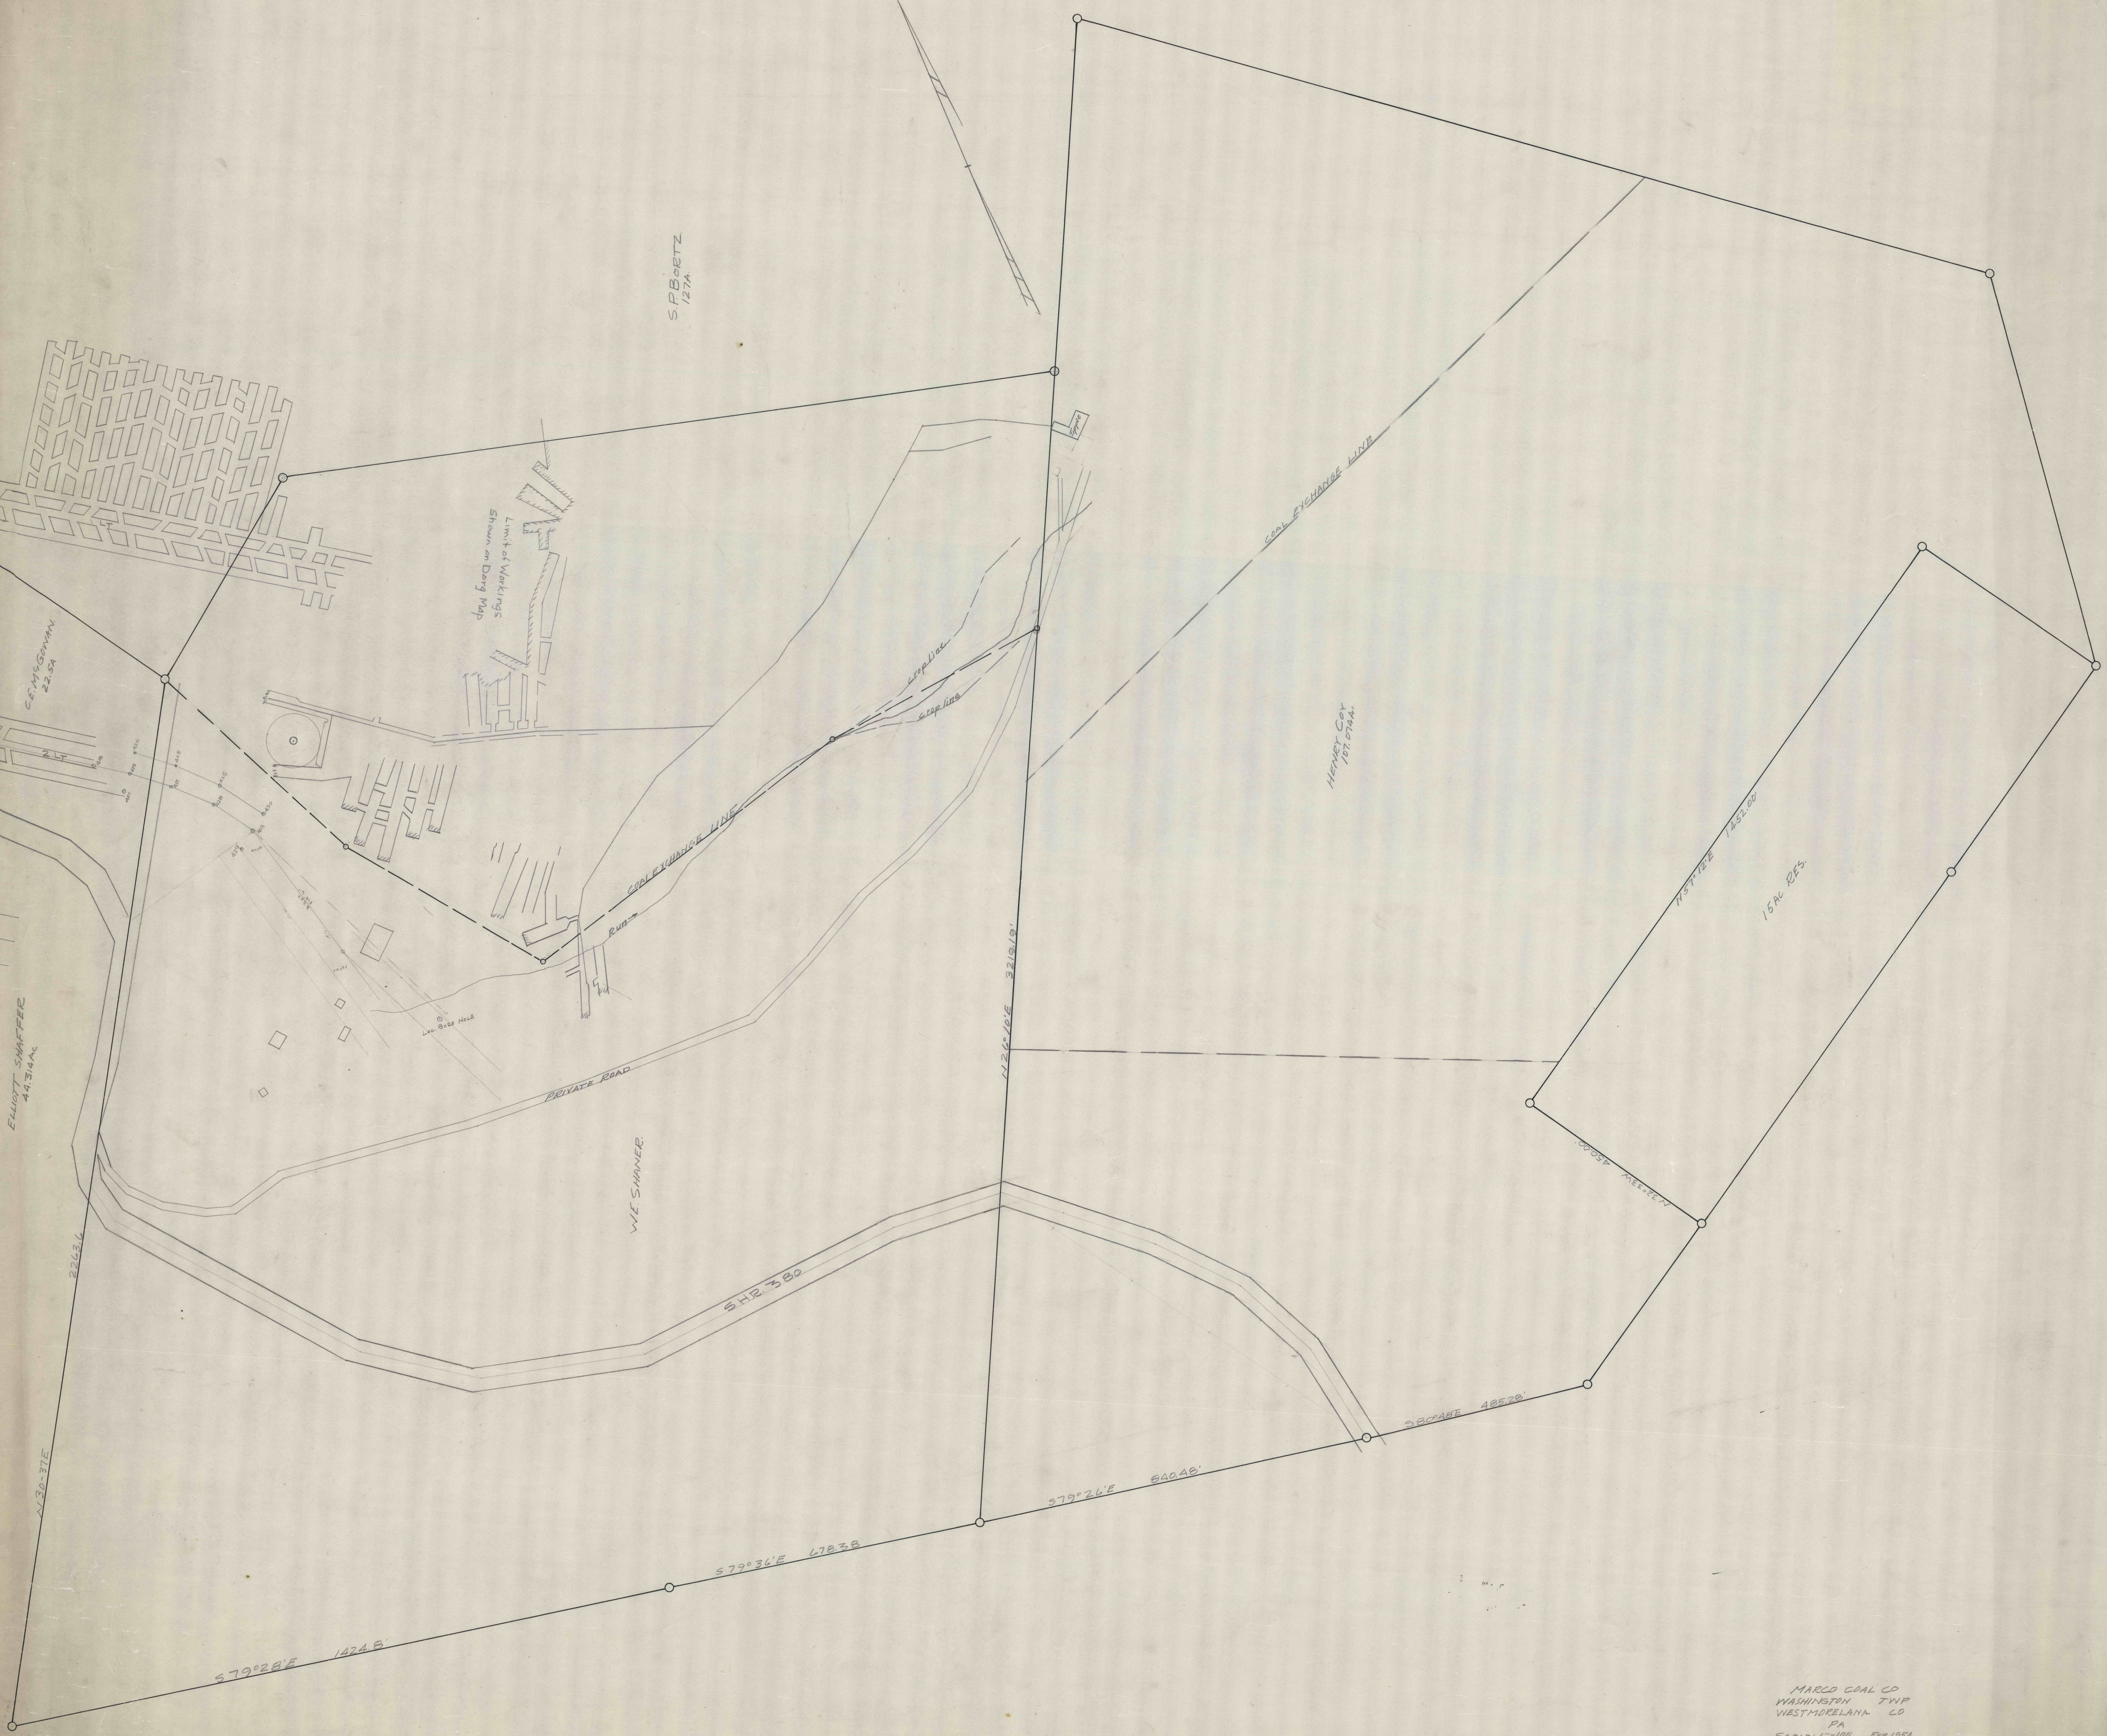

MARCO COAL CO  
 WASHINGTON TWP  
 WESTMORELAND CO  
 PA  
 SCALE 1"=100' FEB 1954