


Last Mining: 3-15-99 FINAL MAP

FEB 01 2001

19.5 Six Month Projection Map

SOLAR N° 10 MINE  
 QUEMAHONING TWP SOMERSET CO.  
 UPPER KITTANNING - C SEAM


SOLAR FUEL COMPANY  
 BOX 488  
 SOMERSET, PENNA. 15501

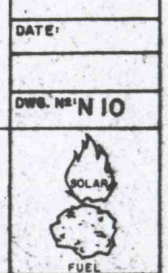

SHEET INDEX

87	88	89	90	91	92	93	94	95	96	97	98	99	100

RECEIVED  
 FEB 05 2001  
 Dept. of Environmental Protection  
 McMurray District Office

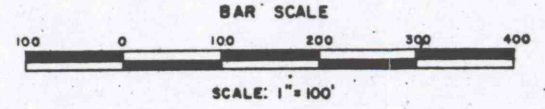

THIS PLANIMETRIC MAP PREPARED BY L. ROBERT KIMBALL & ASSOCIATES Consulting Engineers & Architects EBENSBURG, PENNSYLVANIA, BY PHOTOGRAMMETRIC METHODS FROM AERIAL PHOTOGRAPHY DATED DECEMBER 4, 1979