


RECEIVED
FEB 05 2001

Dept. of Environmental Protection
McMurray District Office

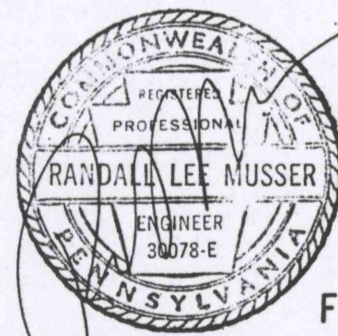

FEB 01 2001

FINAL MAP Last Mining: 3-15-99
19.5 Six Month Projection Map

PIERPONT NO.10 MINE
QUEMAHONING TOWNSHIP SOMERSET COUNTY
UPPER KITTANNING - C' SEAM

CONTRACT OPERATOR
PIERPONT MINING, INC.
P.O. BOX 288
SOMERSET, PA. 15501

SOLAR NO.10 MINE
QUEMAHONING TOWNSHIP SOMERSET COUNTY
UPPER KITTANNING - C' SEAM


SOLAR FUEL COMPANY
BOX 488
SOMERSET, PA. 15501

SHEET INDEX

M16	N13	N14
M20	N17	N18
RB	S5	S6

LEGEND

- MINE ACTIVITY PERMIT NO.56841318
- BOUNDARY OF SUBSIDENCE PERMIT.
 - PROTECTED STRUCTURES. 2
 - OTHER STRUCTURES. 2A,2B
 - DENOTES BUILT AFTER THE ACT. AA
 - OCCUPANT - NOT OWNER. 3L
 - CONTEMPLATED MINING _____ TO _____
 - SUPPORT AREA.
 - PAST SIX MONTH MINING.
 - WELL
 - SPRING
 - C PRIME - UPPER KITTANNING

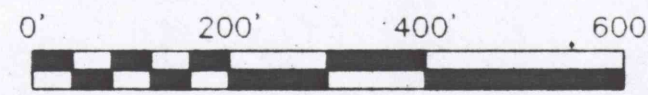

MATCH LINE MAP M20

N17