

N 285,000
N 284,000
N 283,000
N 282,000
N 281,000

E1,654,000 E1,655,000 E1,656,000 E1,657,000 E1,658,000

JOHN EUGENE GREBECK
Coal - HERMAN BERKEY
D 77


C/O RUTH D. EGLER
FREDERICK N. & RUTH D. EGLER
Coal - EMMA OBER
D 11

RUTH D. EGLER
Coal - GOTTLIEB STRAUB
D 10

FLOYD L. & JOANN CASSIDY
Coal - ANNIE K. SHAFFER
D 12

JAMES E. STERN
Coal - ANNIE K. SHAFFER
D 12

CLARENCE G. McVICKER
Coal - JACOB ZIMMERMAN
D 19

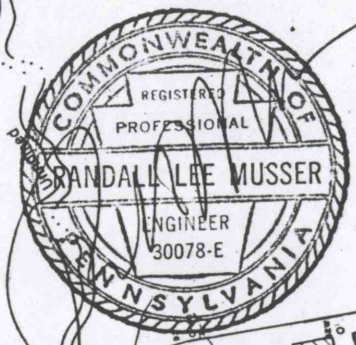

FEB 01 2001

FINAL MAP Last Mining: 3-15-99
19.5 Six Month Projection Map


SOLAR No 10 MINE
QUEMAMONING TWP. SOMERSET CO.
UPPER KITTANNING - C' SEAM
DWS. No M12
SOLAR FUEL COMPANY
BOX 488
SOMERSET, PENNA. 15501

SHEET INDEX

07	08	09	10	11	12	13	14
01	02	03	04	05	06	07	08
15	16	17	18	19	20	21	22
23	24	25	26	27	28	29	30
31	32	33	34	35	36	37	38
39	40	41	42	43	44	45	46
47	48	49	50	51	52	53	54
55	56	57	58	59	60	61	62
63	64	65	66	67	68	69	70
71	72	73	74	75	76	77	78
79	80	81	82	83	84	85	86
87	88	89	90	91	92	93	94
95	96	97	98	99	00	01	02

RECEIVED
FEB 5 2001
Dept. of Environmental Protection
McMurray District Office

THIS PLANIMETRIC MAP PREPARED BY L. ROBERT KIMBALL & ASSOCIATES Consulting Engineers & Architects EBENSBURG, PENNSYLVANIA, BY PHOTOGAMMETRIC METHODS FROM AERIAL PHOTOGRAPHY DATED DECEMBER 4, 1979

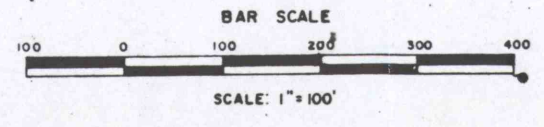

M12