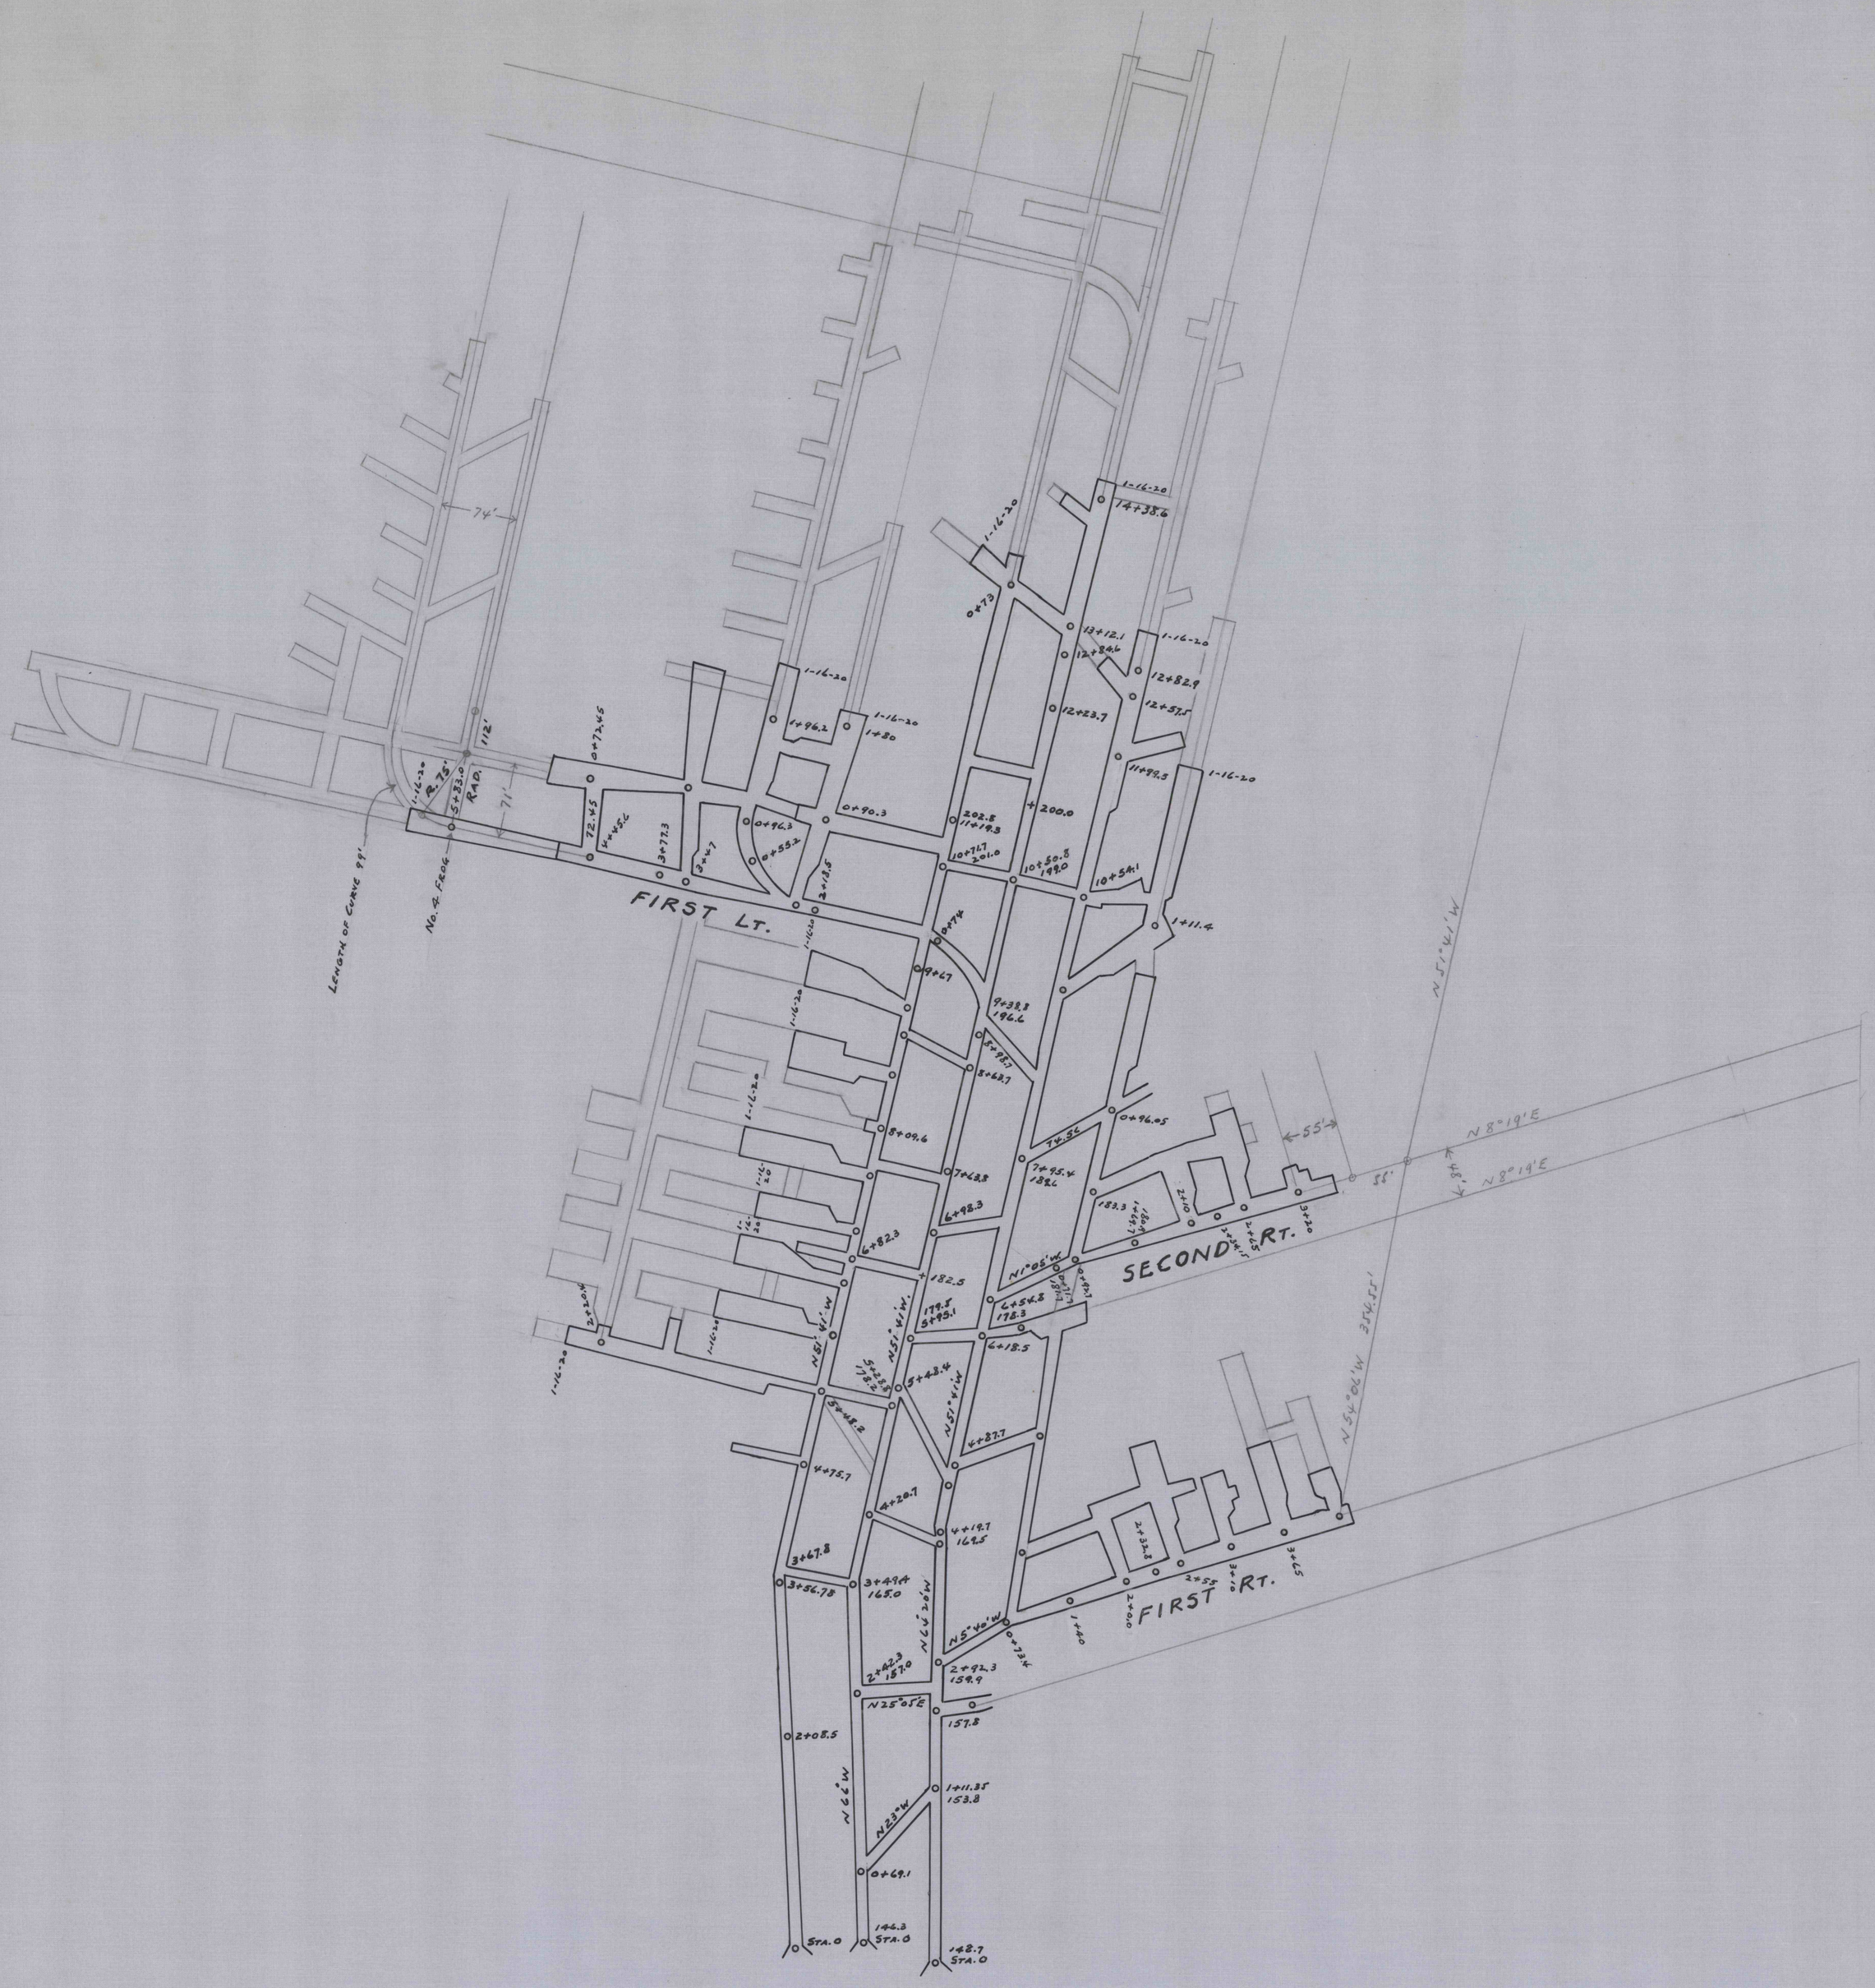
74'
R.75'
5+33.0
RAD.
112'
71'
LENGTH OF CURVE 99'
No. 4 FROG
FIRST LT.
SECOND RT.
FIRST RT.
55'
N 8°19'E
N 51°W
N 54°06'E
N 25°05'E
N 23°W
N 1°05'W
N 51°41'W
N 51°W
N 8°19'E
1-16-20
0+73
13+12.1
12+84.6
12+82.9
12+57.5
12+23.7
11+99.5
1+96.2
1+80
0+73.45
0+90.3
0+96.3
0+55.2
3+77.3
3+47
2+18.5
72.1+45
4+45.6
202.8
11+19.3
10+71.7
201.0
10+50.8
199.0
10+54.1
+200.0
1+11.4
0+74
9+67
9+38.8
196.6
8+98.7
8+62.7
8+09.6
7+62.8
6+98.3
6+82.3
182.5
179.5
5+95.1
5+43.4
5+22.5
178.2
5+48.2
4+87.7
4+75.7
4+20.7
4+19.7
169.5
3+67.8
3+56.78
3+49.4
165.0
2+42.3
157.0
2+08.5
2+92.3
159.9
157.8
1+11.35
153.8
0+69.1
146.3
STA. 0
142.7
STA. 0
0+96.05
7+95.4
188.2
7+54.2
183.3
7+50.1
2+40
2+32.8
2+0.0
1+40
0+73.4
2+55
3+10
3+65