


Robena 498

Fit To 475

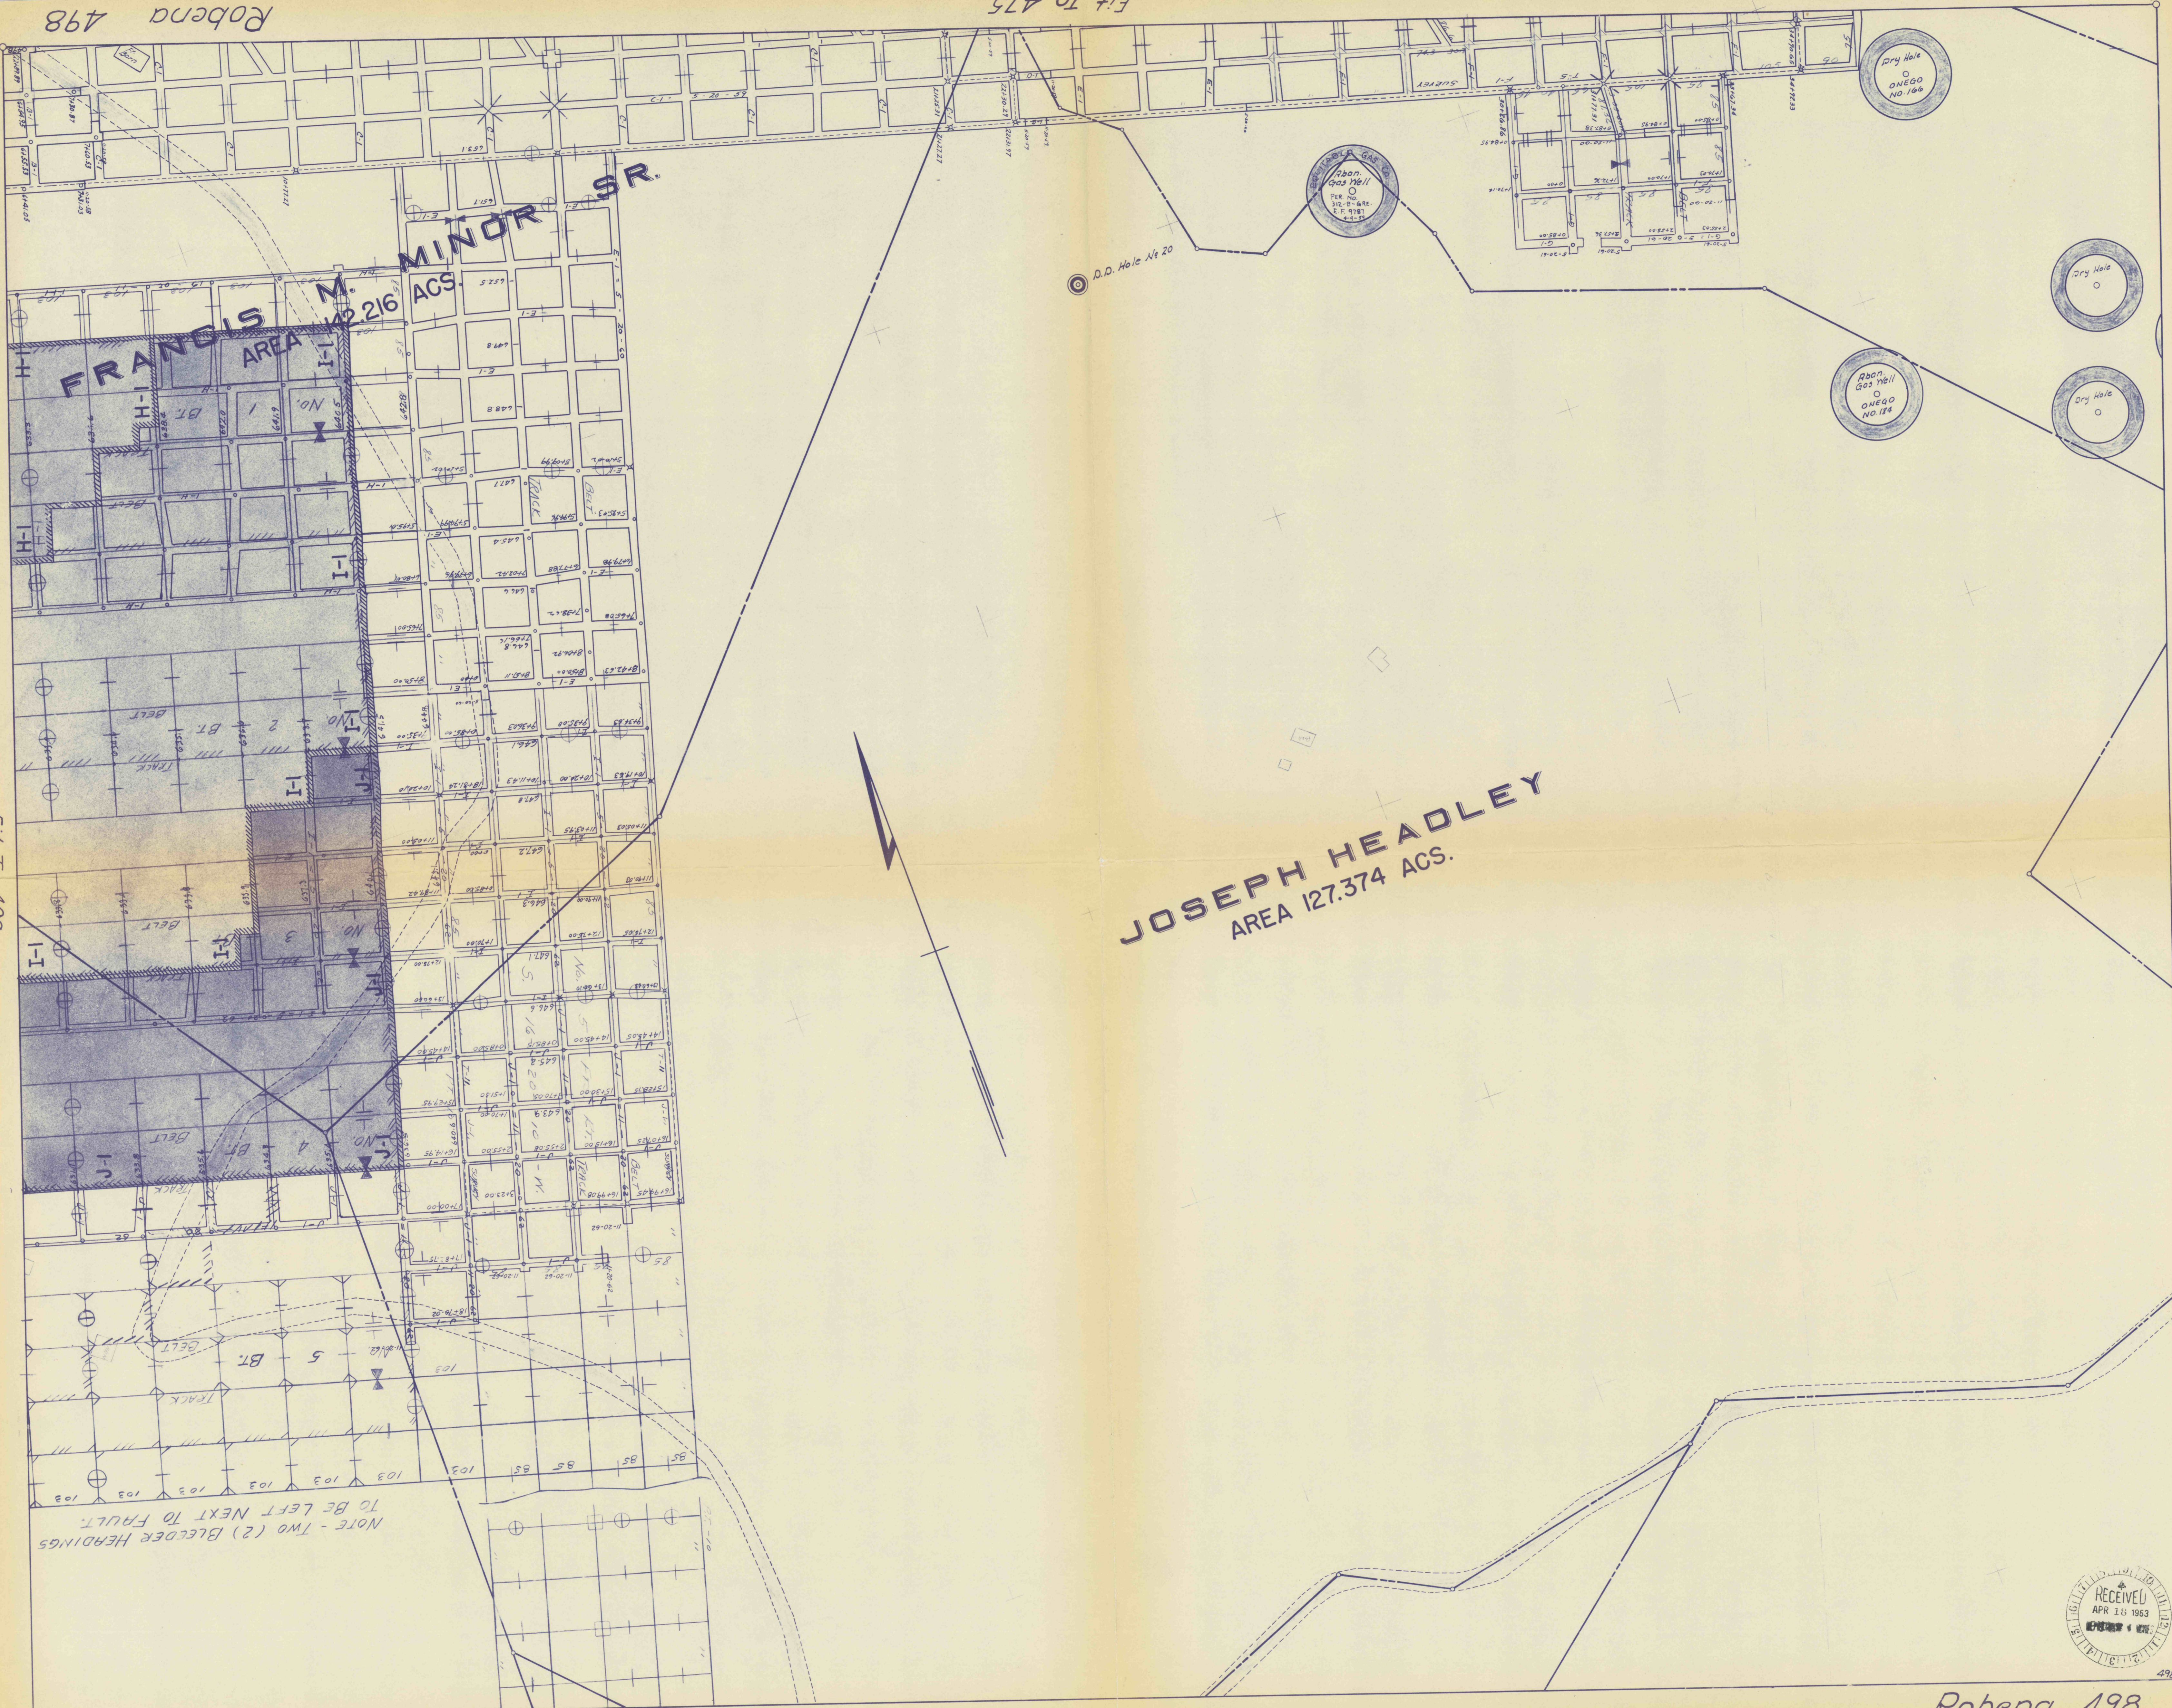

Fit To 499

Fit To 497

JOSEPH HEADLEY  
AREA 127.374 ACS.

NOTE - TWO (2) BLEEDER HEADINGS  
TO BE LEFT NEXT TO FAULT.

Fit To 522

Robena 498

