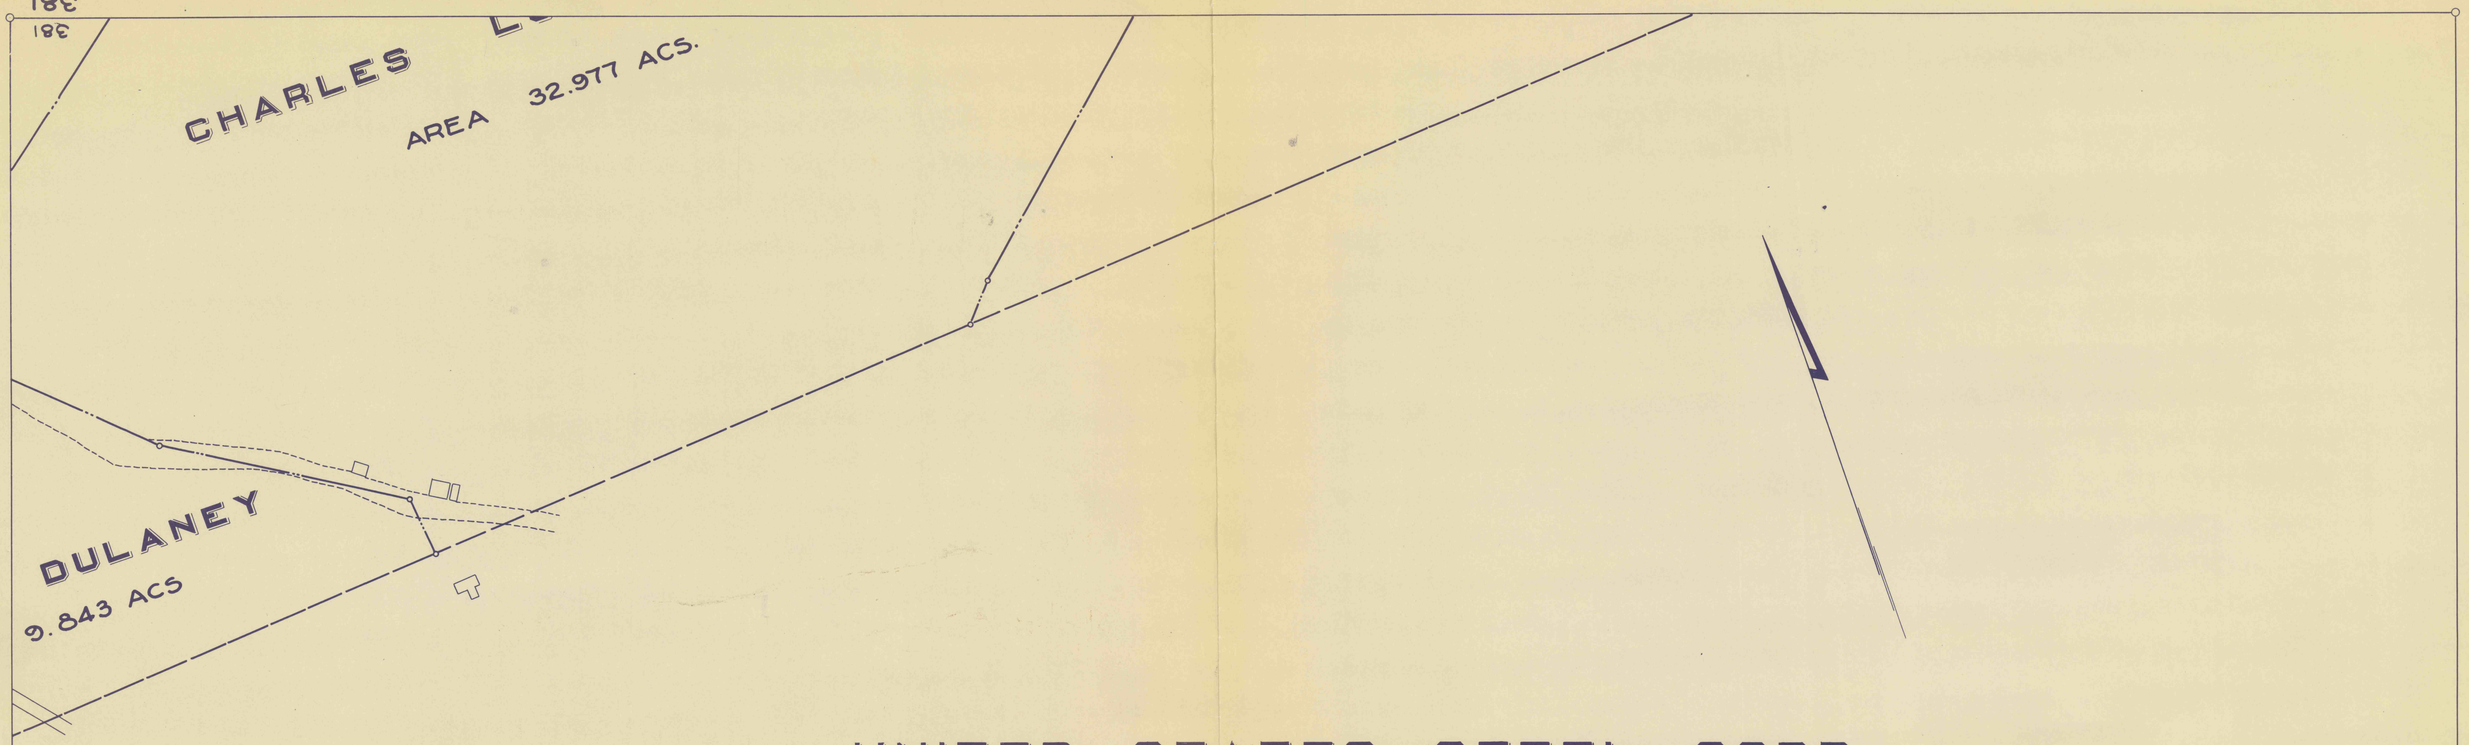

UNITED STATES STEEL CORP.

ROBENA MINE

GREENE COUNTY – PENNSYLVANIA

DATUM OF LEVELS
BASED ON U.S. GEOLOGICAL SURVEY

SCALE 1"=100' T.W.R.C. **MAY 28, 1941**

Note
All previous surveys considered development from Ronco Mine

Date Of Last Survey

Date of Survey	Survey Letter	Plotted By	Traced By
5-20-45	A	L.R.E.	L.R.E.
11-20-45	B	L.R.E.	T.W.R.C.
5-20-46	C	L.R.E.	L.R.E.
11-20-46	D	N.H.E.	N.H.E.
5-20-47	E	N.H.E.	A.M.M.
11-20-47	F	N.H.E.	W.D.W.
5-20-48	G	N.H.E.	N.H.E.
11-20-48	H	N.H.E.	W.D.W.
5-20-49	I	N.H.E.	N.H.E.
11-20-49	J	N.H.E.	N.H.E.
5-20-50	K	N.H.E.	N.H.E.
11-20-50	L	N.H.E.	N.H.E.
5-20-51	M	N.H.E.	N.H.E.
11-20-51	N	N.H.E.	D.L.S.
5-20-52	O	N.H.E.	N.H.E.
11-20-52	P	N.H.E.	N.H.E.
5-20-53	Q	N.H.E.	D.L.S.
11-20-53	R	N.H.E.&AMM.	N.H.E.&AMM.
5-20-54	S	N.H.E.&AMM.	N.H.E.&AMM.
11-20-54	T	N.H.E.&AMM.	N.H.E.&AMM.
5-20-55	U	N.H.E.&AMM.	N.H.E.&AMM.
11-20-55	V	N.H.E.&AMM.	AMM.&J.F.S.
5-21-56	W	J.F.S.&D.L.S.	J.A.Y.
11-20-56	X	J.F.S.	J.A.Y.
5-20-57	Y	J.F.S., J.A.Y.	R.S.&J.A.Y.
11-20-57	Z	D.L.S.&J.A.Y.	J.A.Y.
5-20-58	A-1	D.L.S.	D.L.S.
11-20-58	B-1	D.L.S.&J.A.Y.	J.A.Y.
5-20-59	C-1	D.L.S.&J.A.Y.	M.O.W.-J.A.Y.
11-20-59	D-1	D.L.S.&J.A.Y.	J.A.Y.
5-20-60	E-1	D.L.S.&J.A.Y.	J.A.Y.
11-20-60	F-1	D.L.S.-A.M.	D.L.S.-A.M.
5-20-61	G-1	D.L.S.E.L.	E.L.W.L.
11-20-61	H-1	D.L.S.E.L.	W.L.
5-20-62	I-1	D.L.S.E.L.	W.L.

Date of Survey	Survey Letter	Plotted By	Traced By

Date of Survey	Survey Letter	Plotted By	Traced By

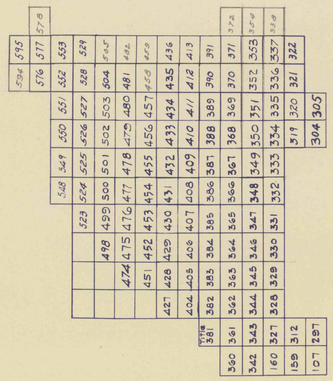

RECEIVED
APR 17 1963