

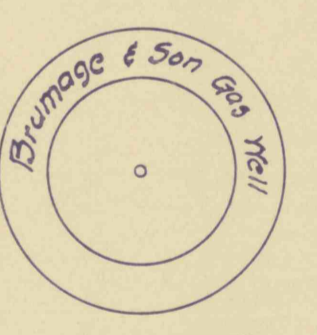


HATTIE R. BLAKER ET AL.
AREA 61.623 ACS.

FIT TO 353

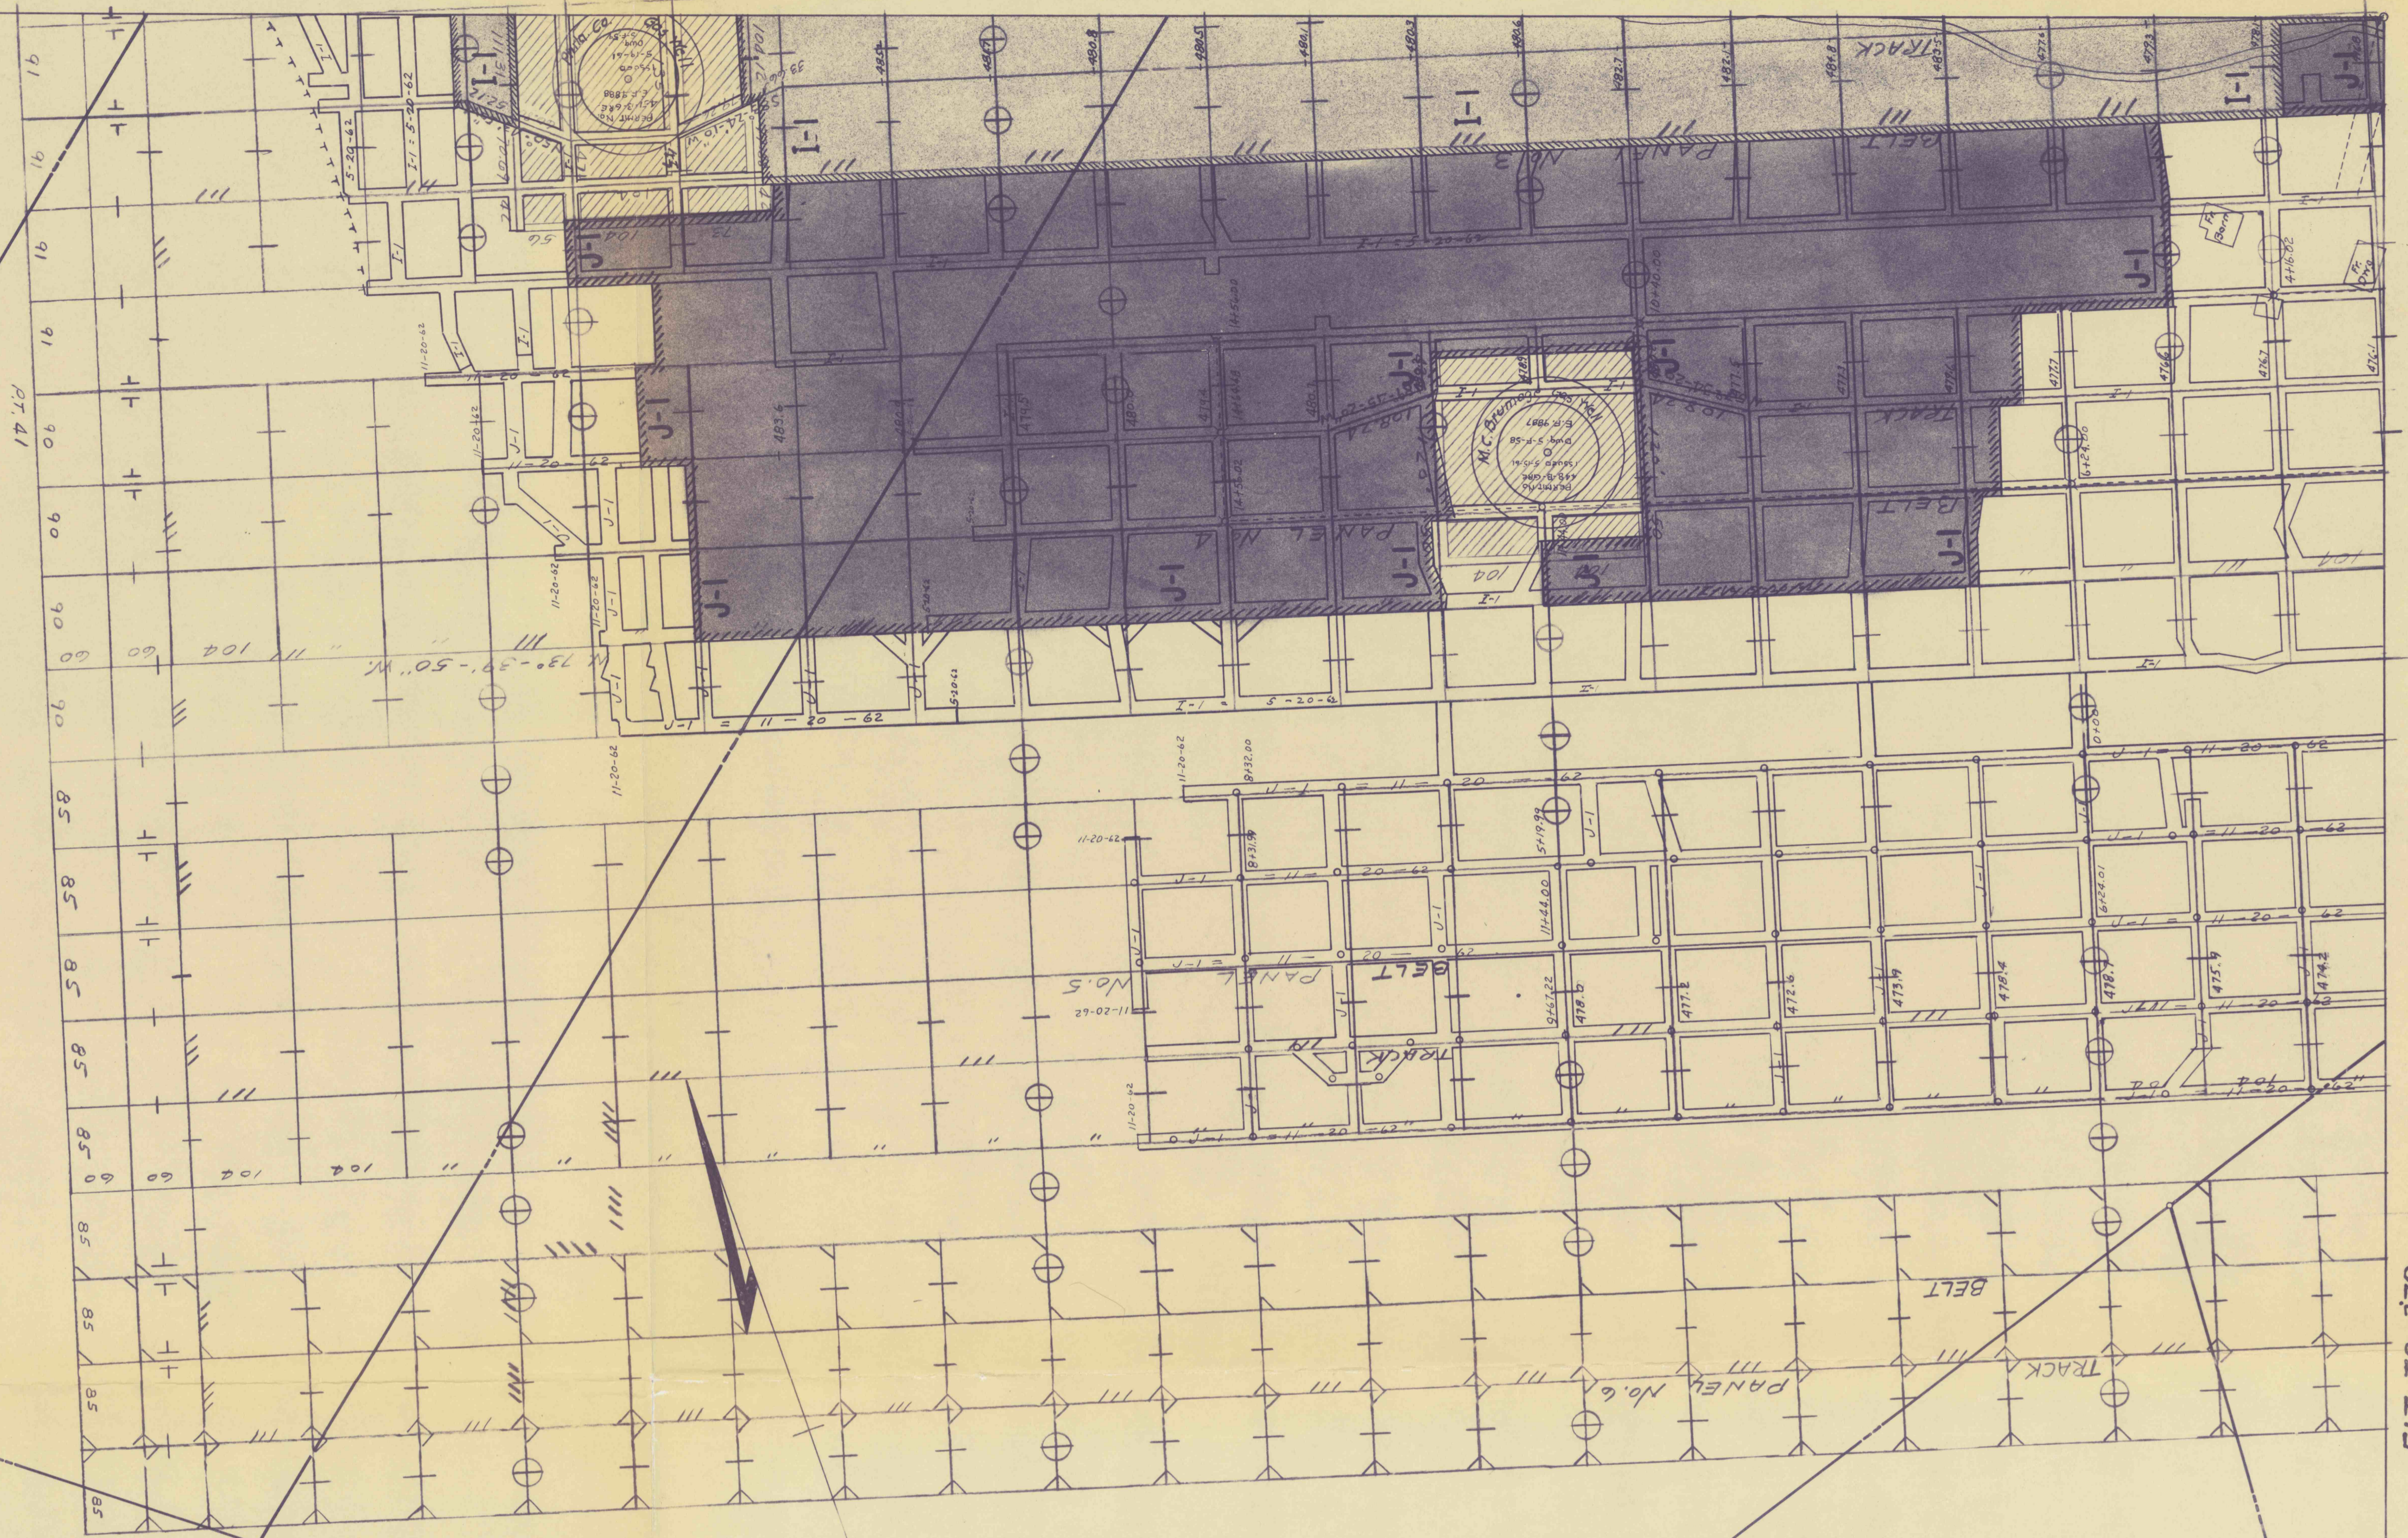

JOHN F. BLAKER
AREA 71.048 ACS.

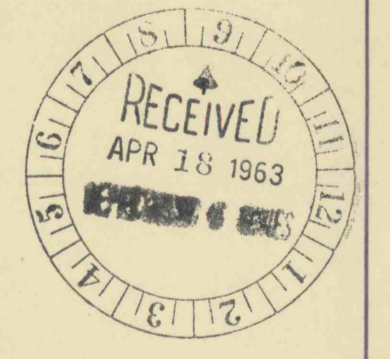

FIT TO 372

FIT TO 370