


FIT TO 367

FIT TO 365

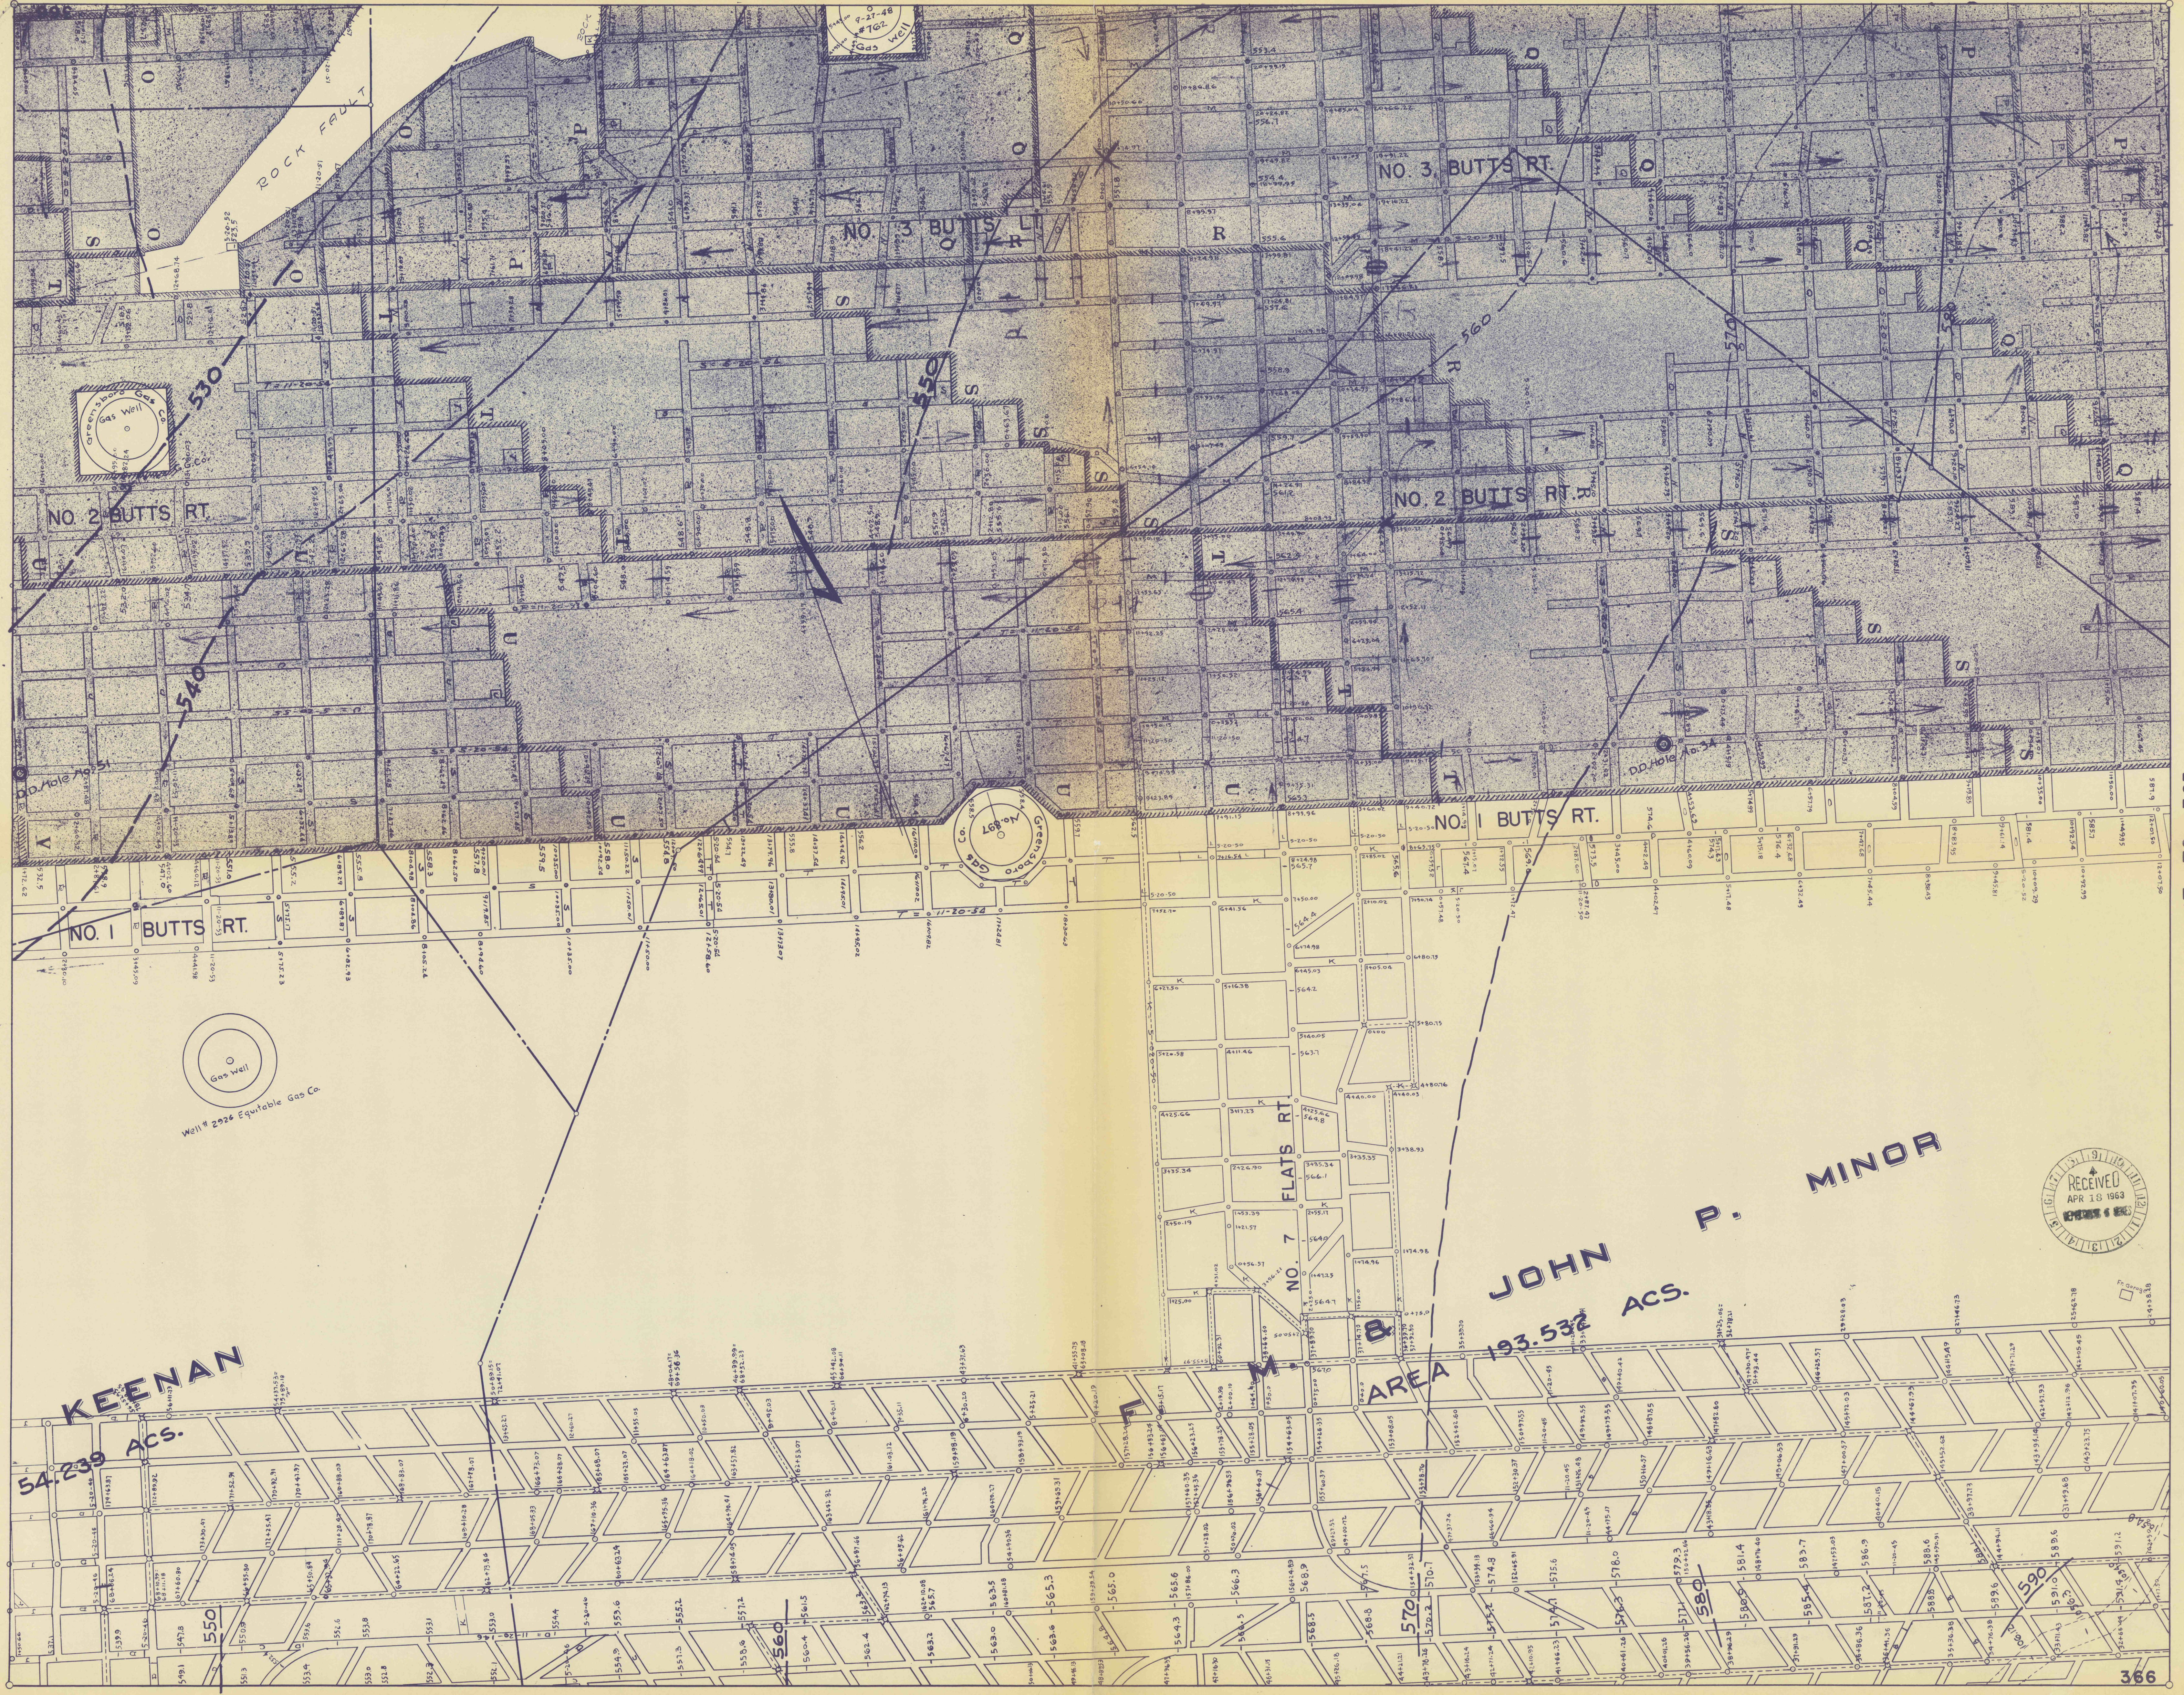

KEENAN
54.239 ACS.

JOHN P. MINOR
AREA 193.532 ACS.

