


FIT TO 333

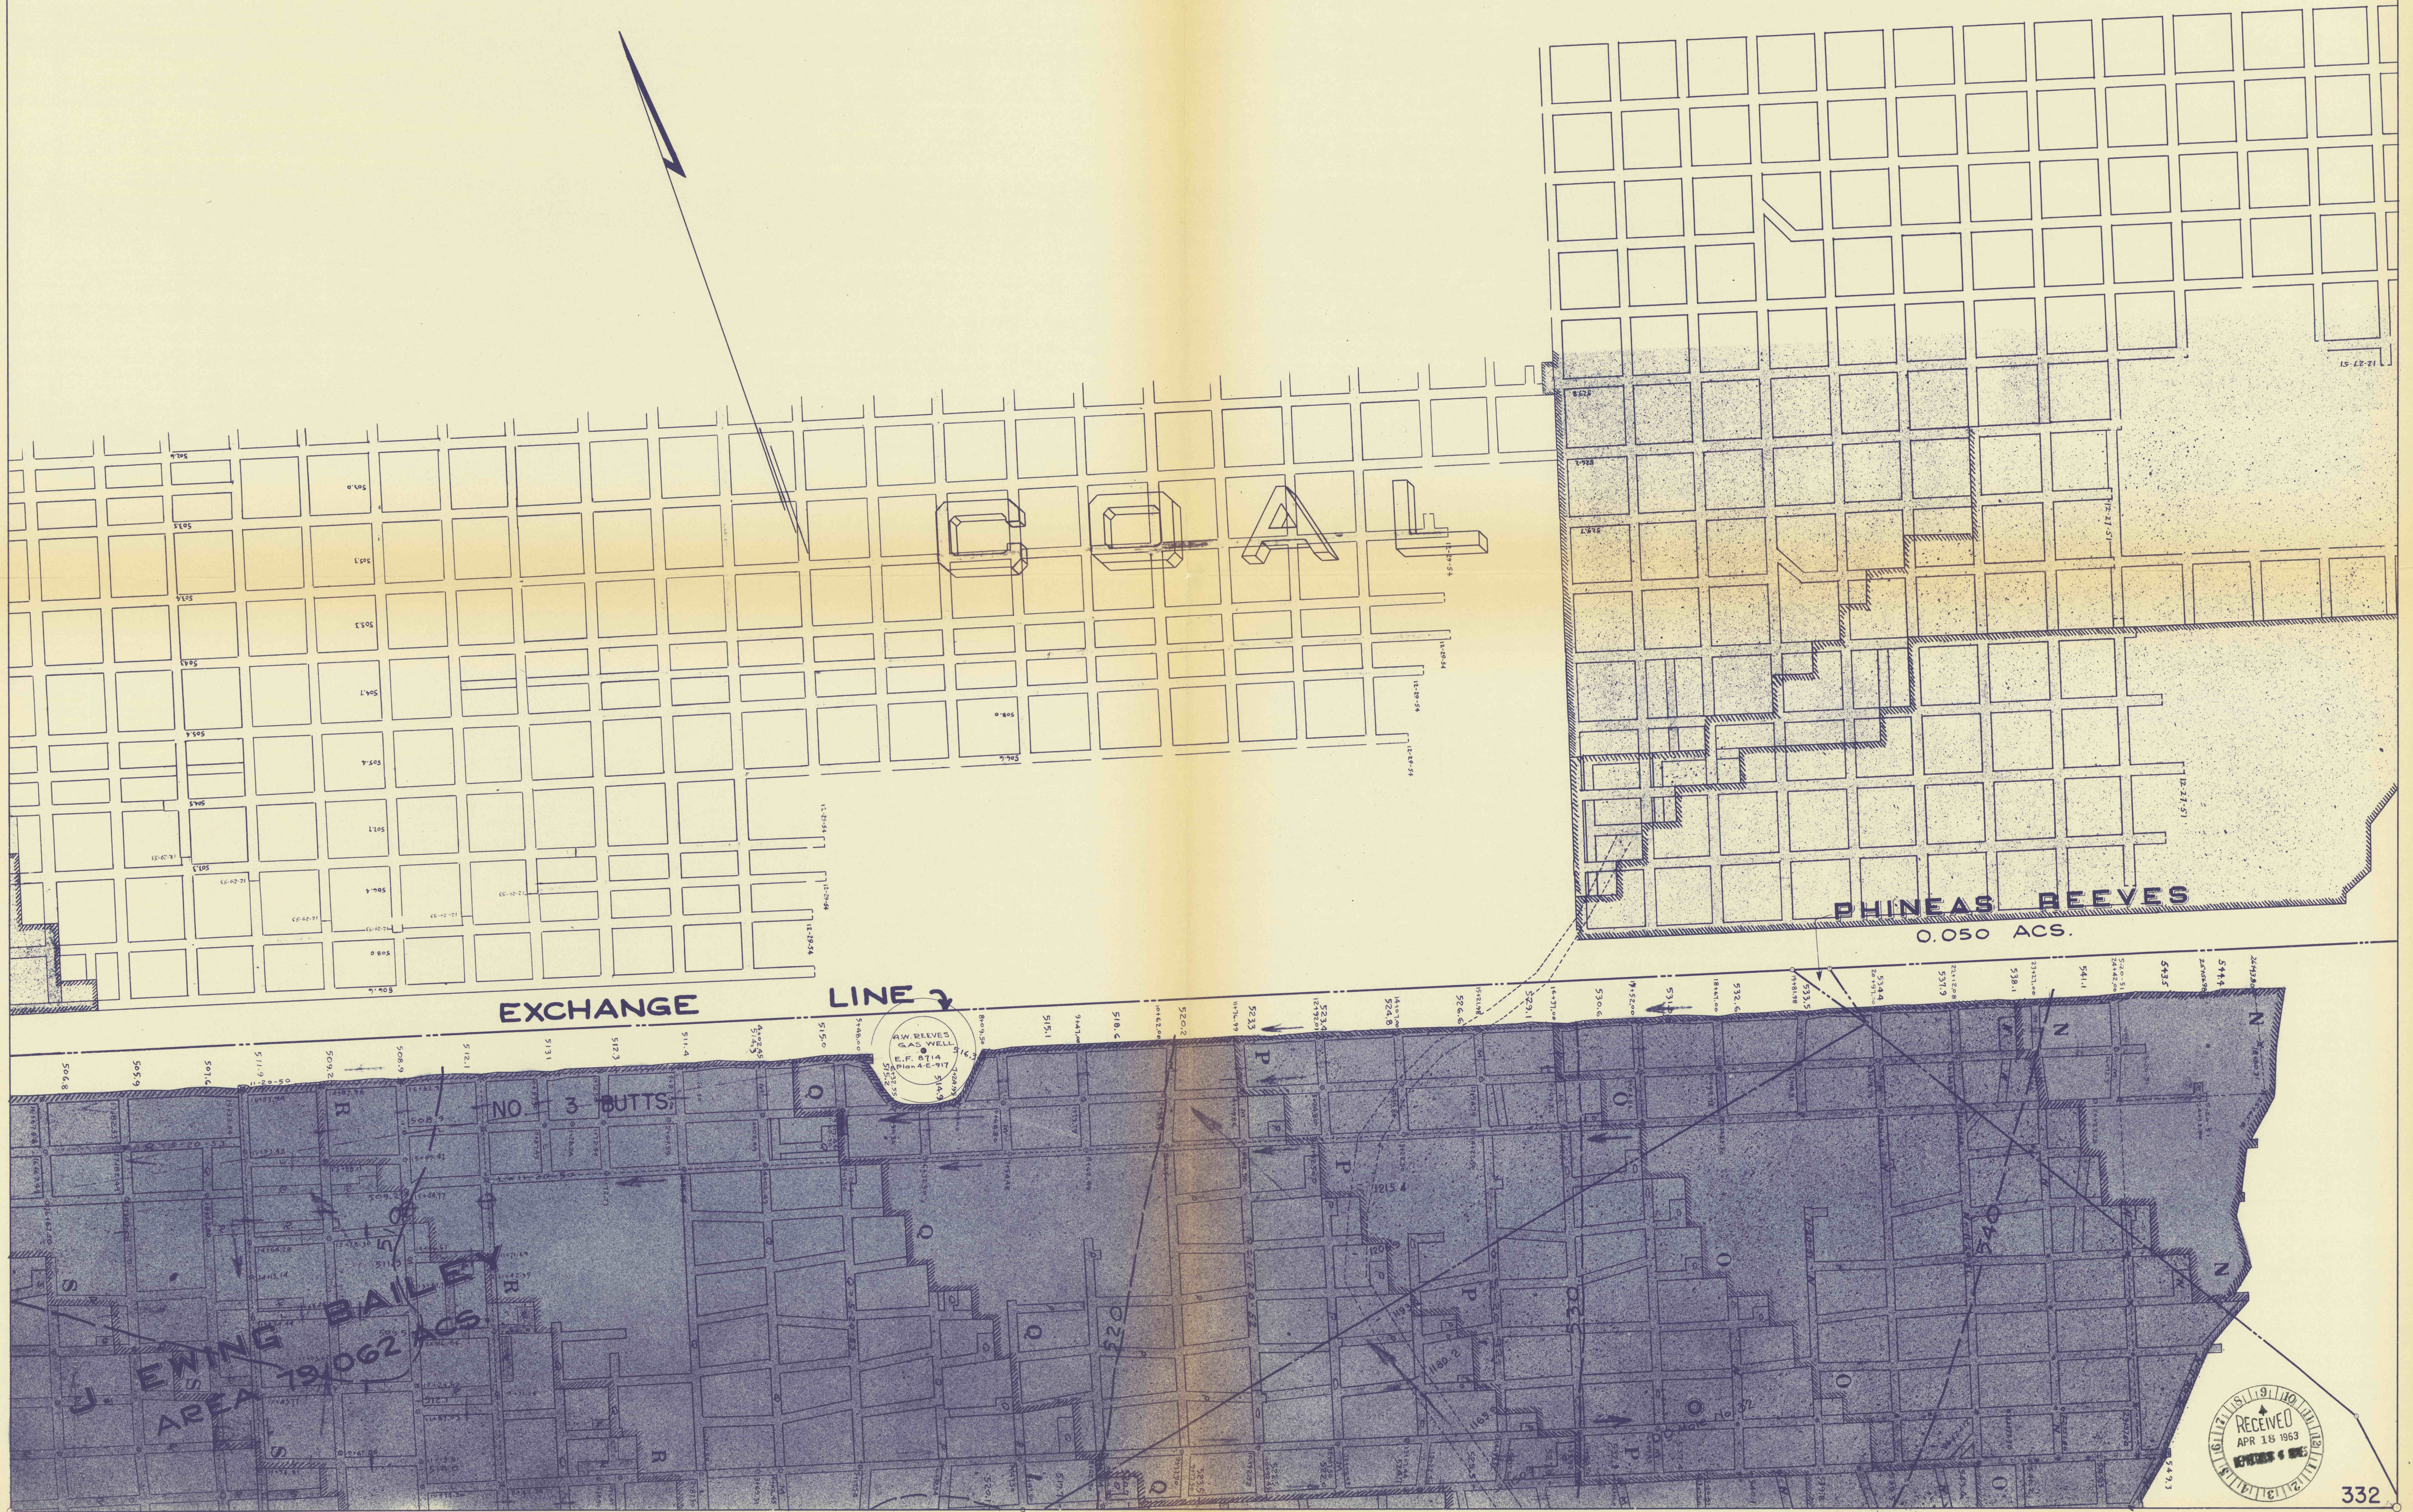

FIT TO 331

FIT TO 348