
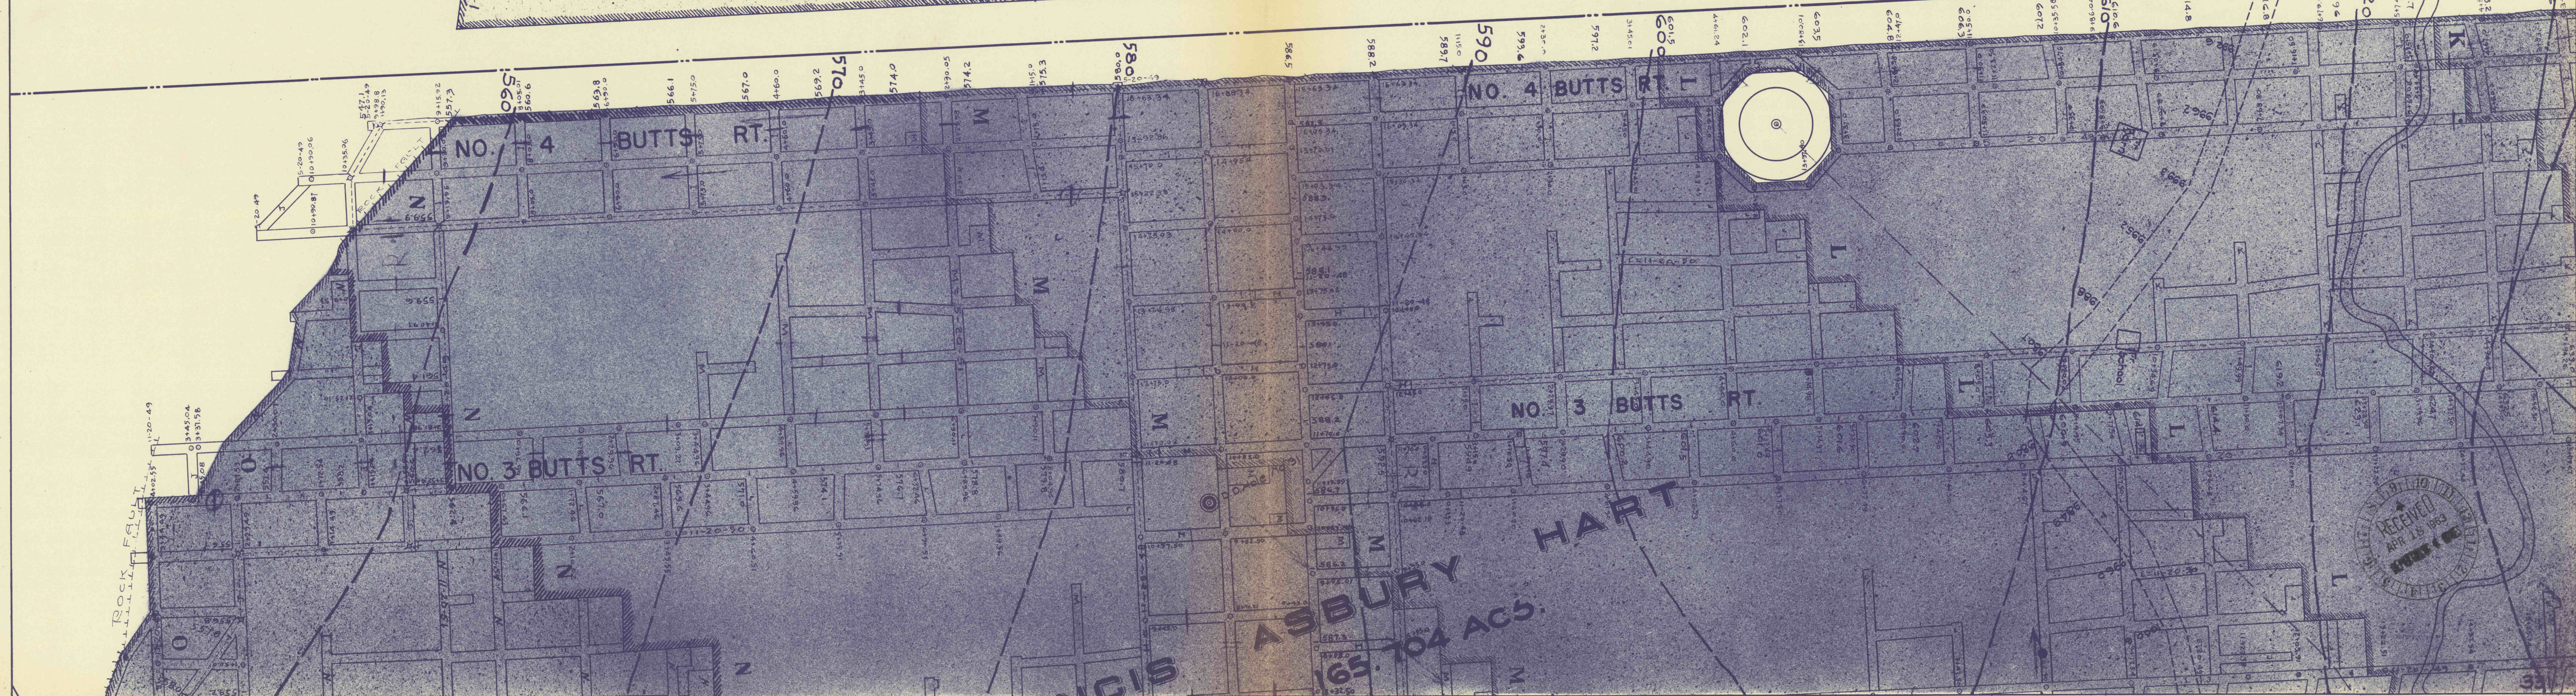


FIT TO 332

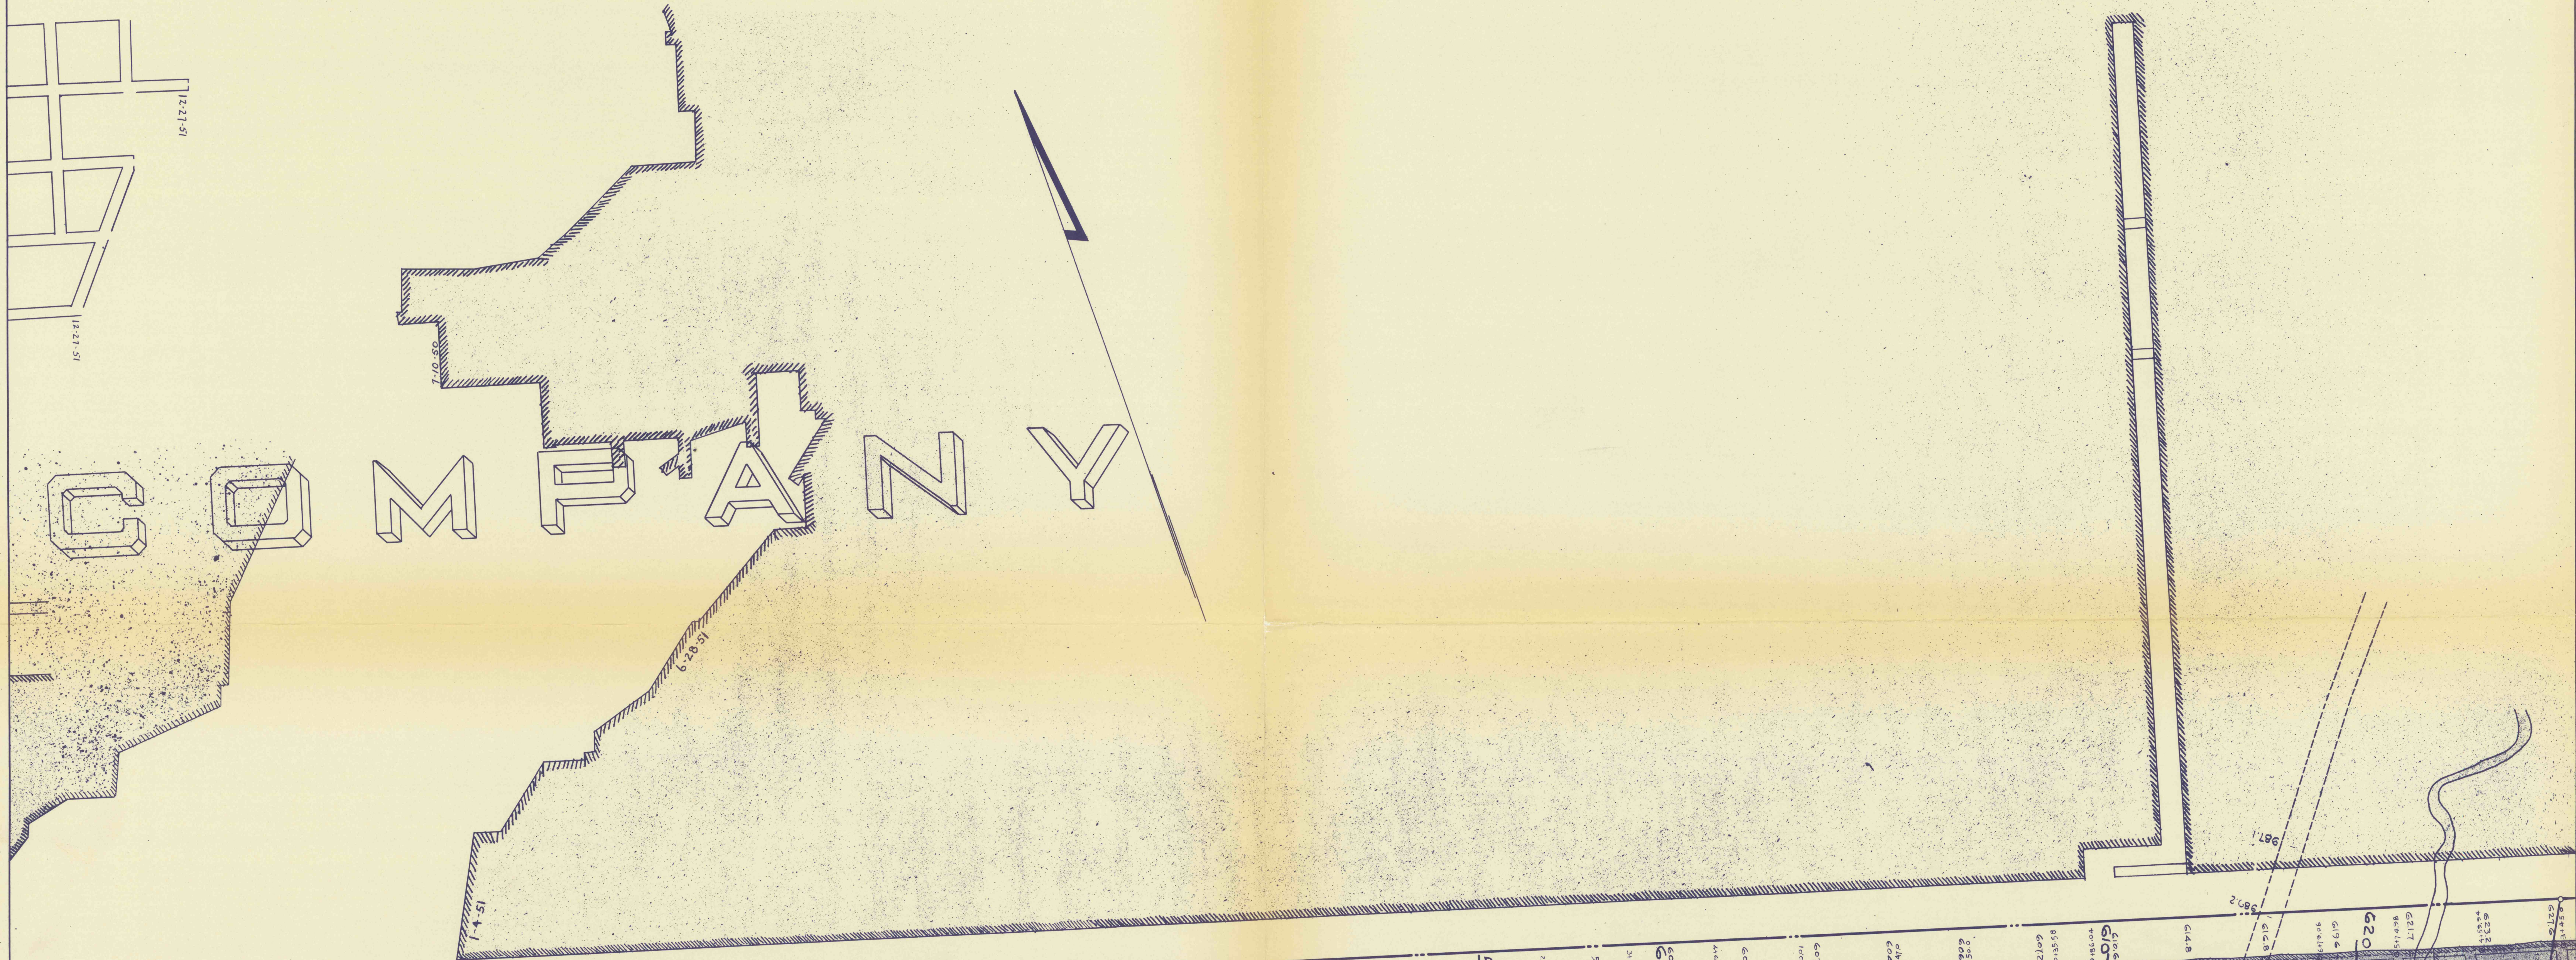

FIT TO 347

FIT TO 330