


BUCKEYE COAL

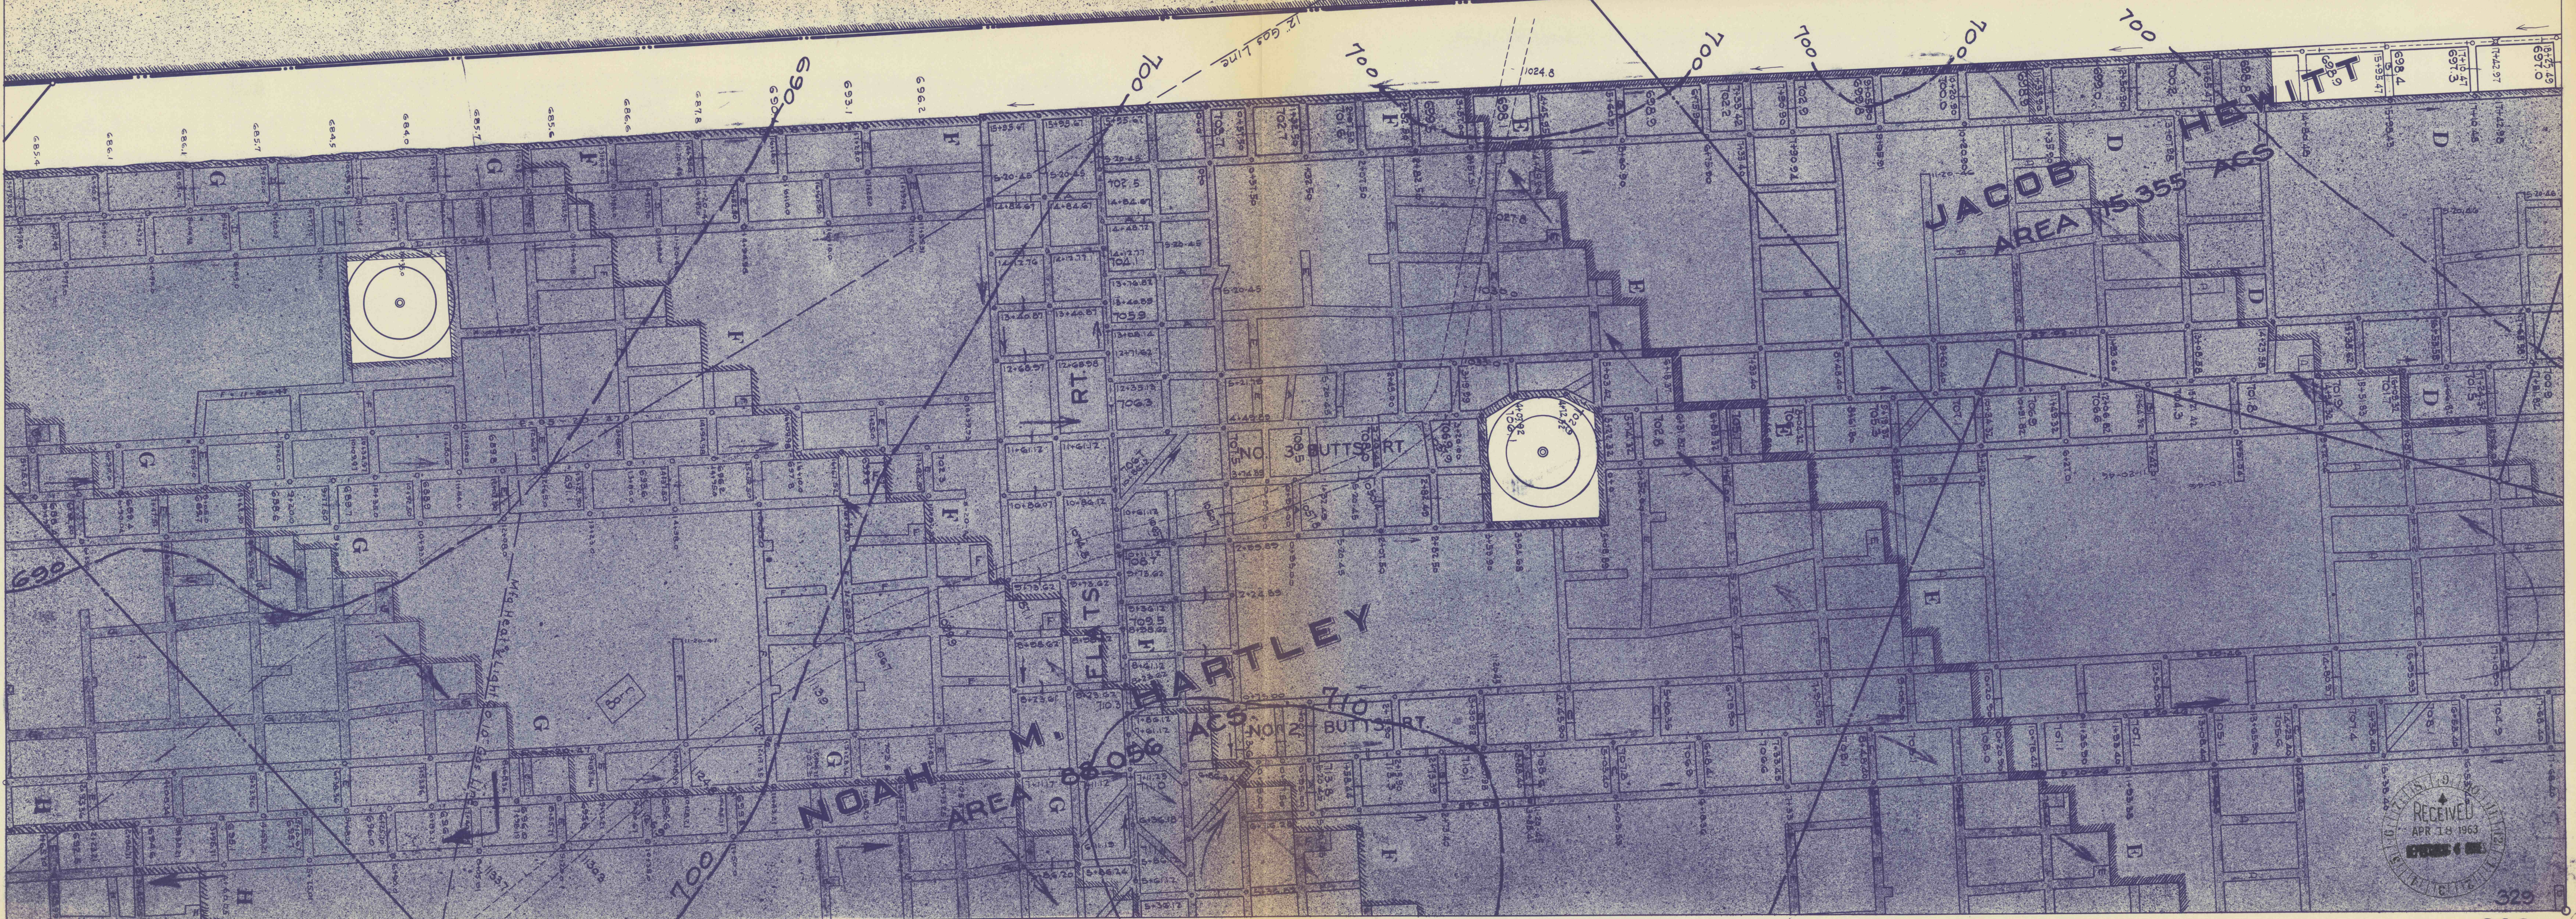

FIT TO 330

FIT TO 328

FIT TO 345

329
ROBENA



329
ROBENA