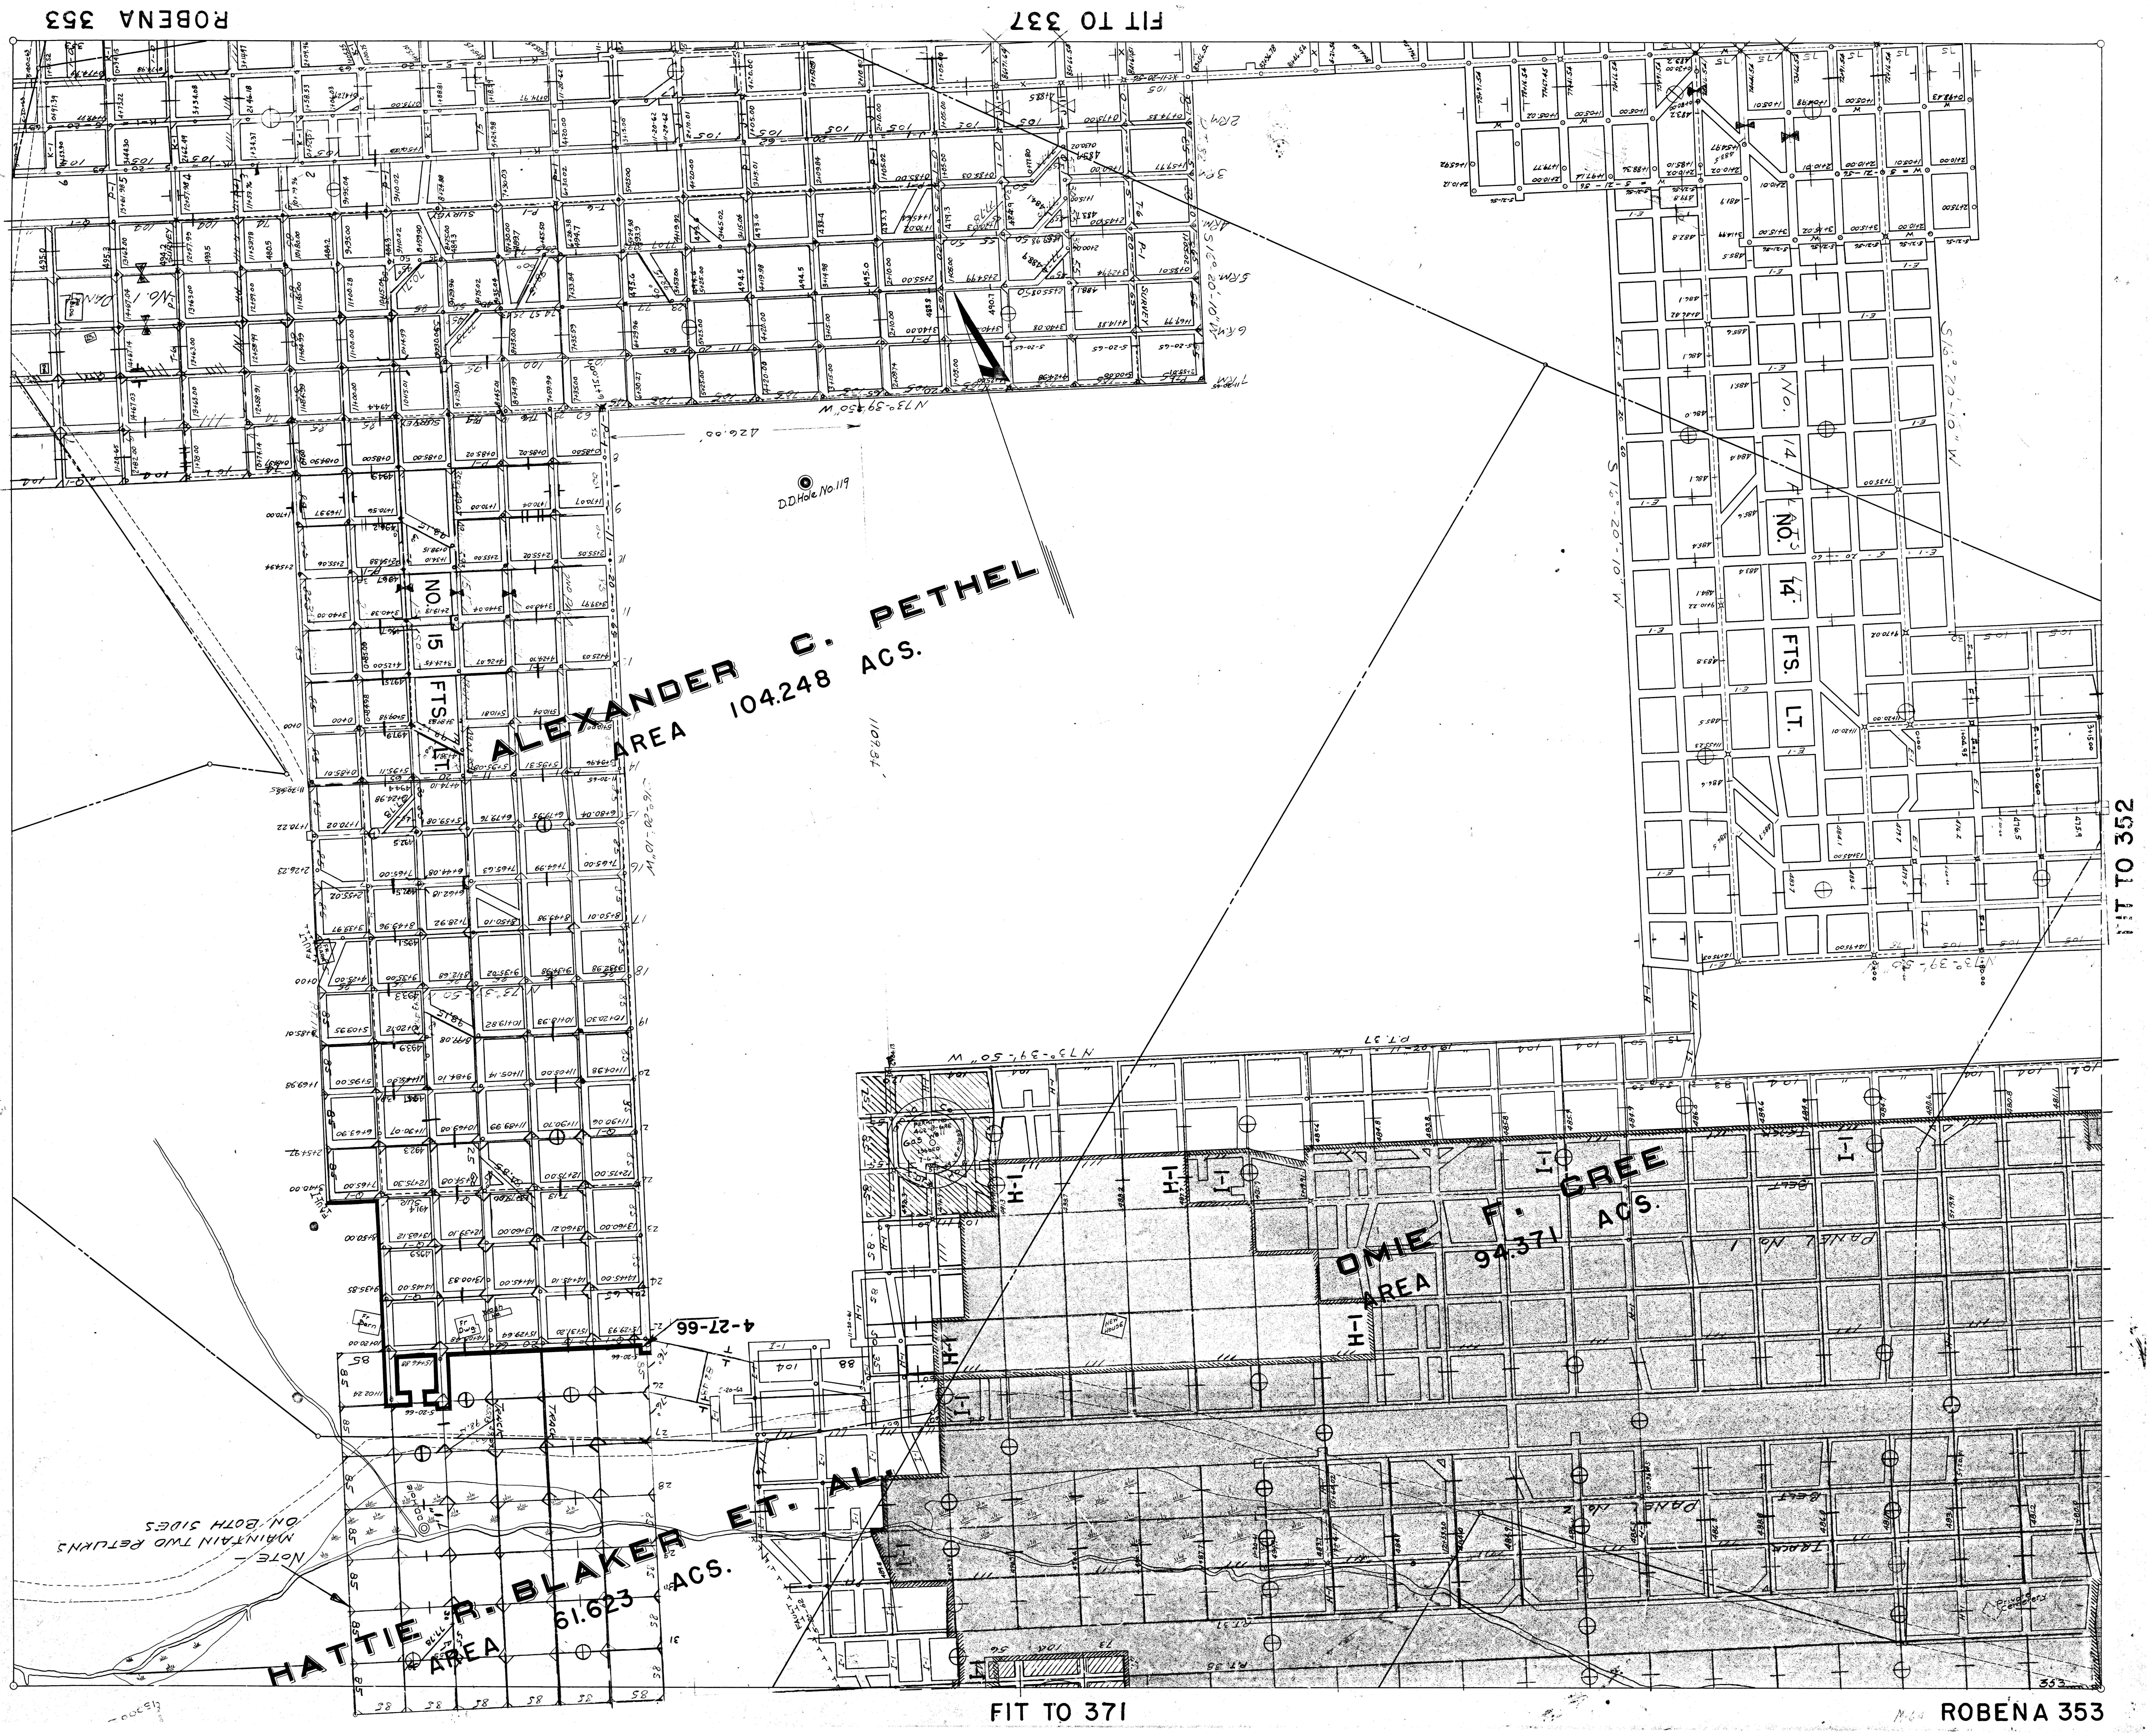
ROBENA 353
FIT TO 337
FIT TO 354
FIT TO 352
FIT TO 371
ALEXANDER C. PETHEL
AREA 104.248 ACS.
NO. 15 FTS. LT.
NO. 14 FTS. LT.
D.D. Hole No. 119
426.00
N73°-39'-50" W
SURVEY
No. 1 DANL
109.84
S 16°-20'-10" W
4-27-66
Fr Barn
Fr Dwg.
Wash Ho.
FAULT
OMIE F. CREE
AREA 94.371 ACS.
PERMIT NO. ALL-8-GRE GAS WELL ISSUED 7-6-61
NEW HOUSE
PANEL No 1
BELT
TRACK
Private Cemetery
HATTIE R. BLAKER ET. AL.
AREA 61.623 ACS.
NOTE — MAINTAIN TWO RETURNS ON BOTH SIDES
D.D. Hole
P.T. 37
P.T. 38
353

ROBENA 353