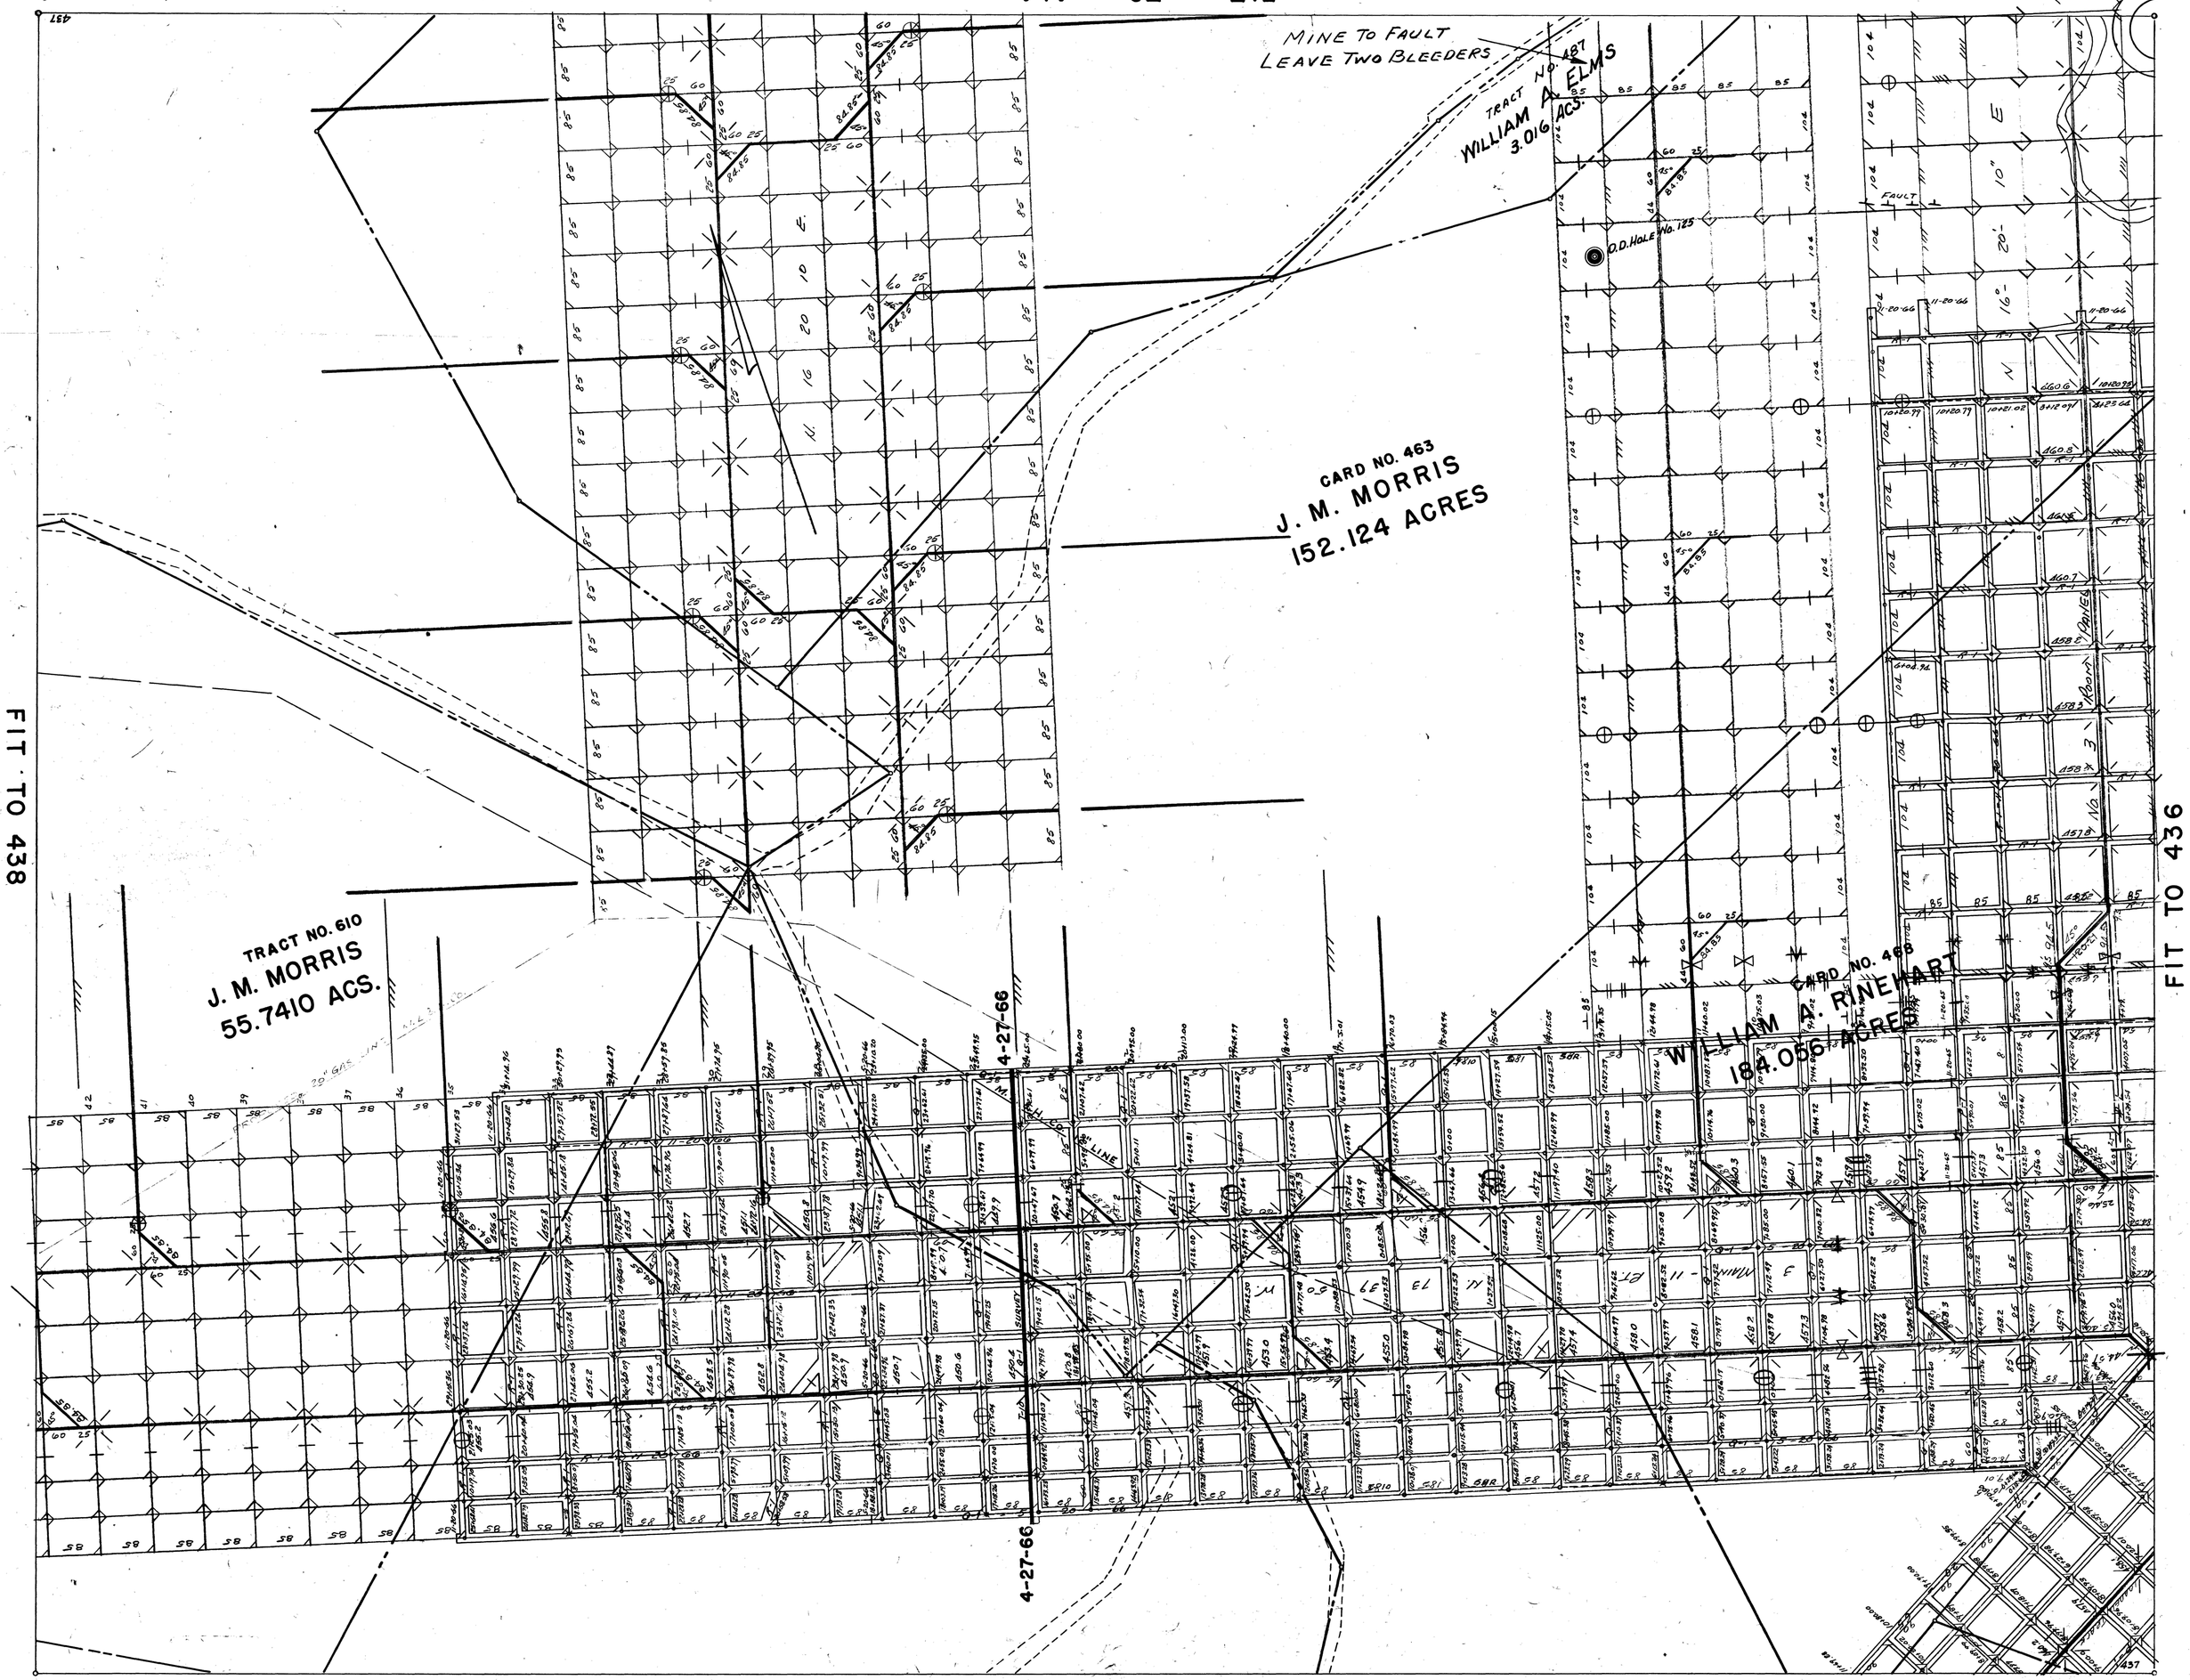
MINE TO FAULT
LEAVE TWO BLEEDERS
TRACT NO. 487
WILLIAM A. ELMS
3.016 ACS.
O.D. HOLE No. 125
FAULT
CARD NO. 463
J. M. MORRIS
152.124 ACRES
TRACT NO. 610
J. M. MORRIS
55.7410 ACS.
4-27-66
CARD NO. 466
WILLIAM A. RINEHART
184.056 ACRES
FIT TO 438
FIT TO 436
FIT TO 460
ROBENA 437