



ROBENA 460

FIT TO 437

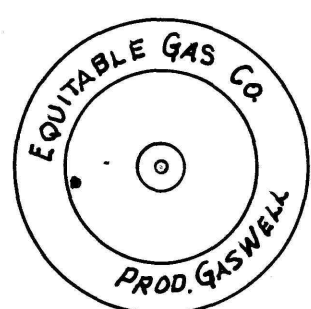

GARD 632
HENRY J. ZIMMERMAN
68.842 ACRES

GARD 479
J. HARVEY BURGE
65.631 ACRES

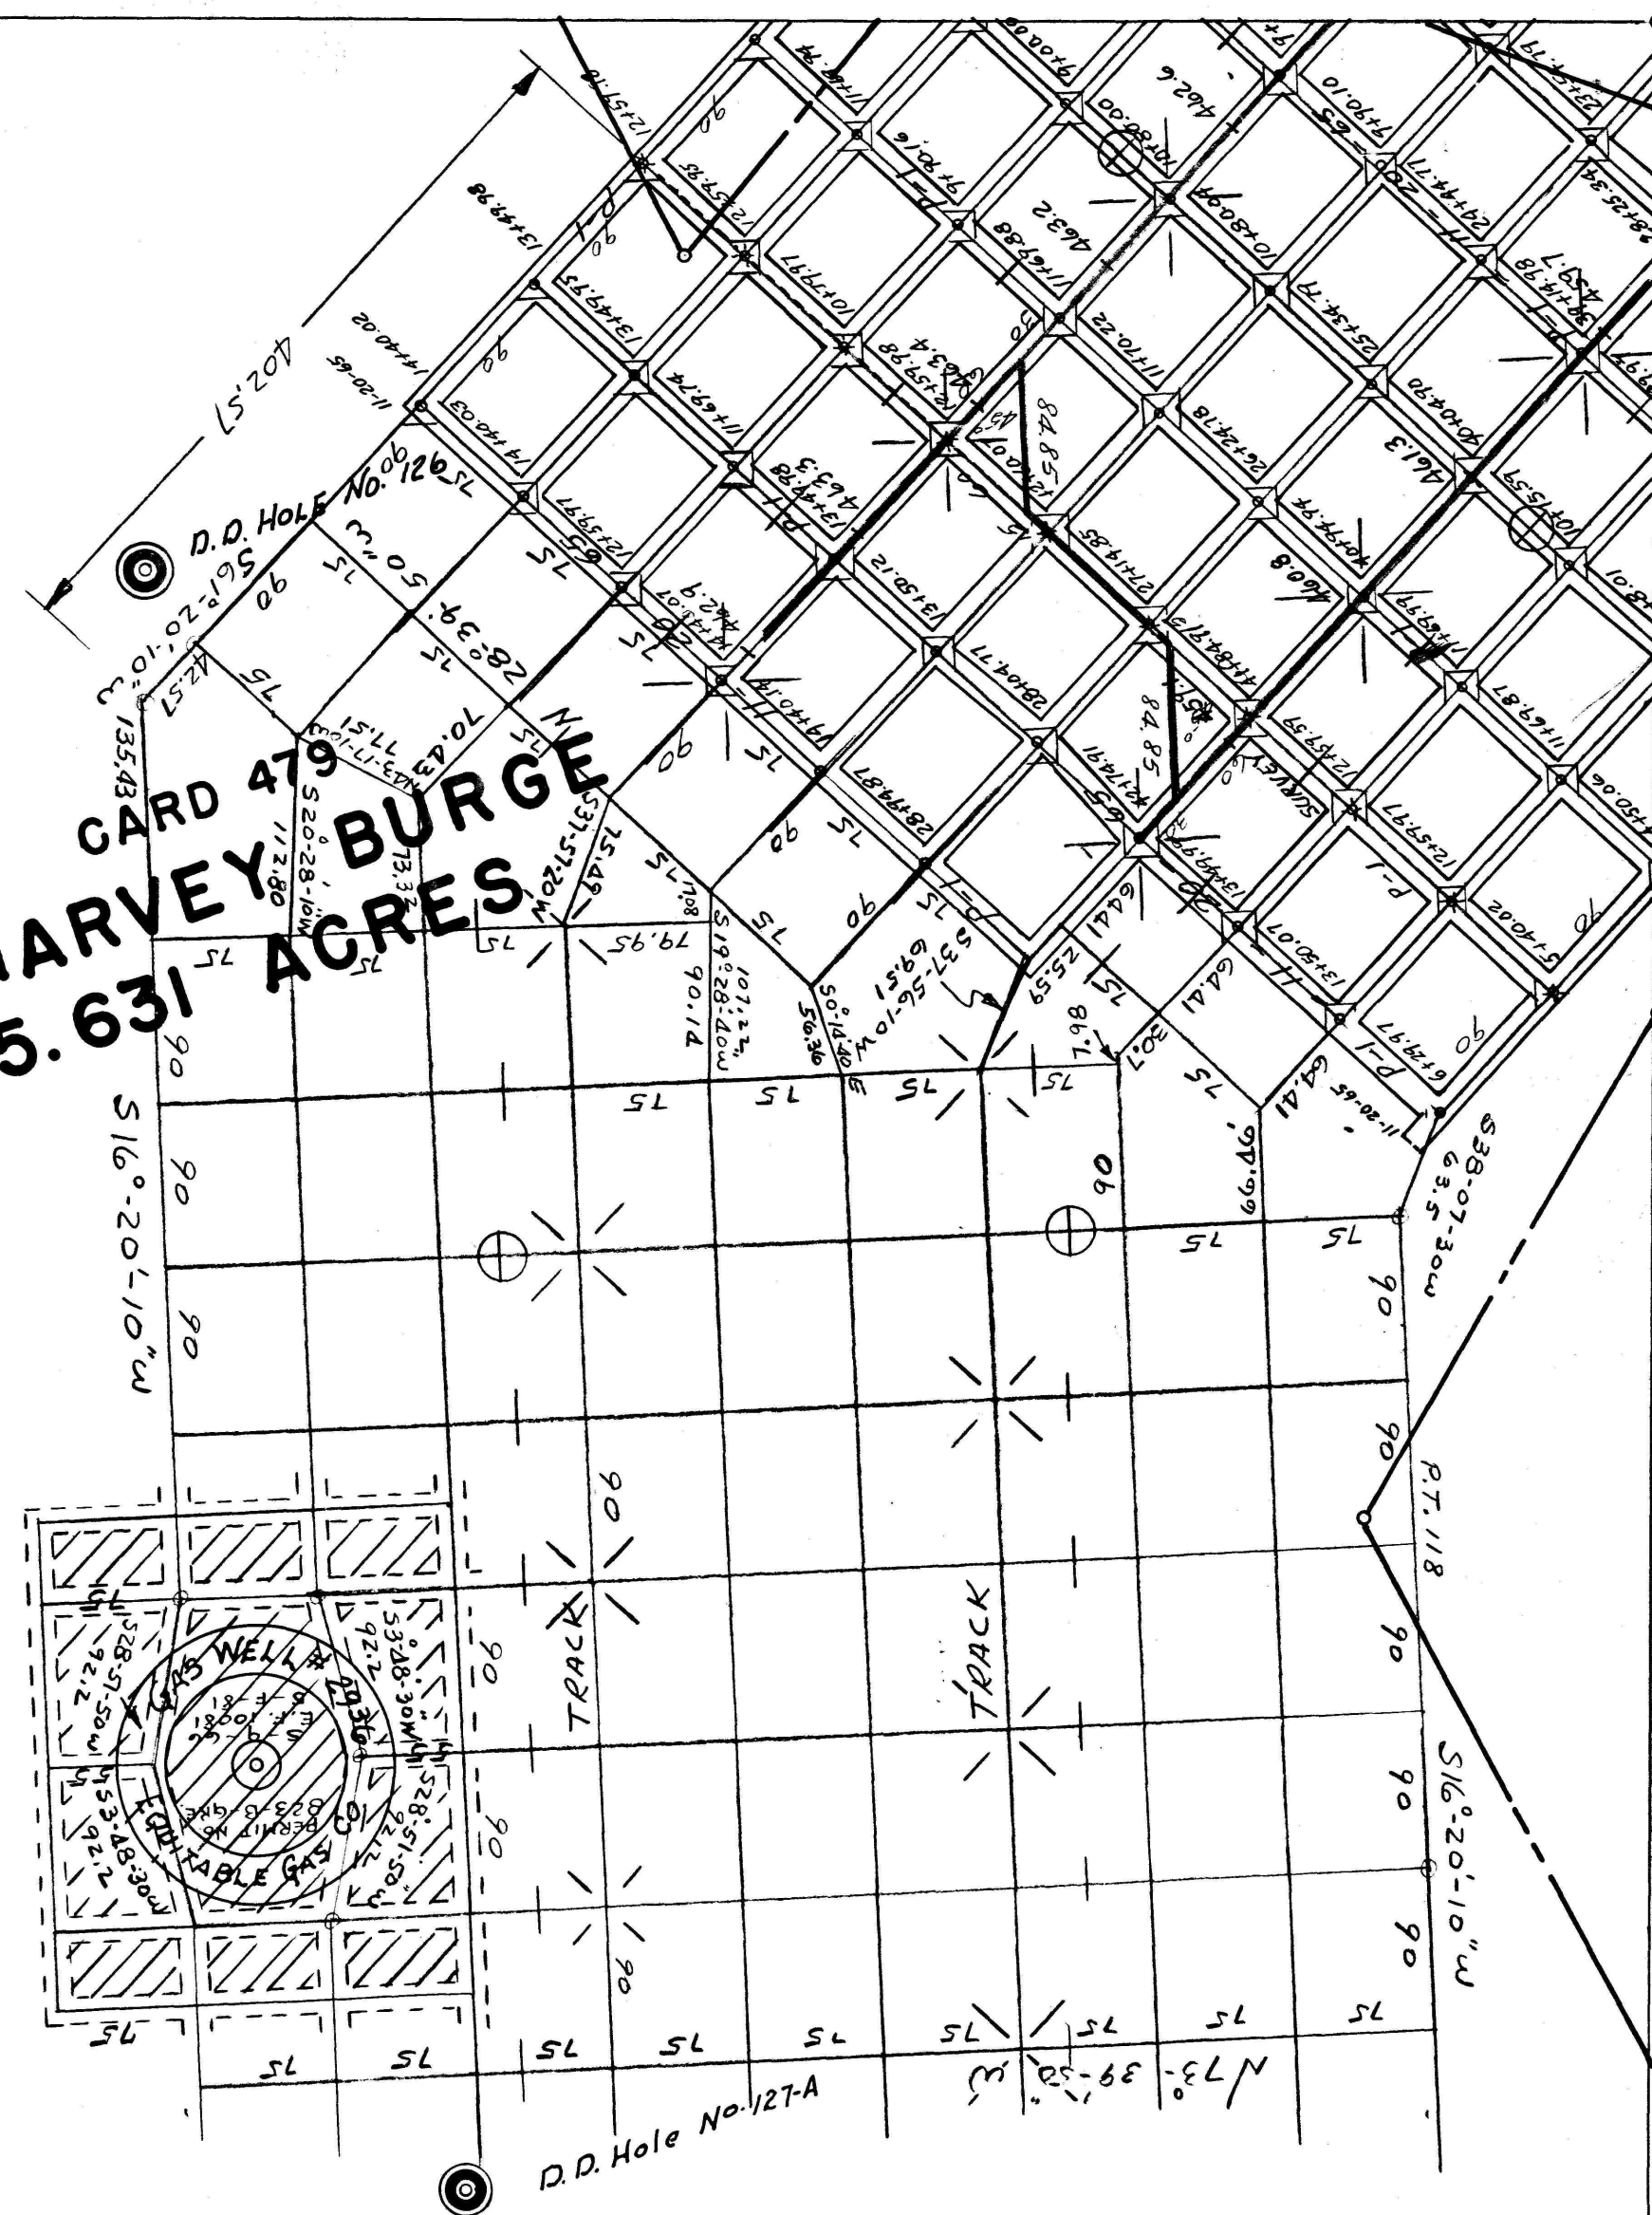

FIT TO 461

TRACT NO. 605
JOHN S. FULLER
AREA 547.325 ACS.

FIT TO 459

D.D. Hole No. 134

D.D. Hole No. 127

FIT TO 483

ROBENA 460