


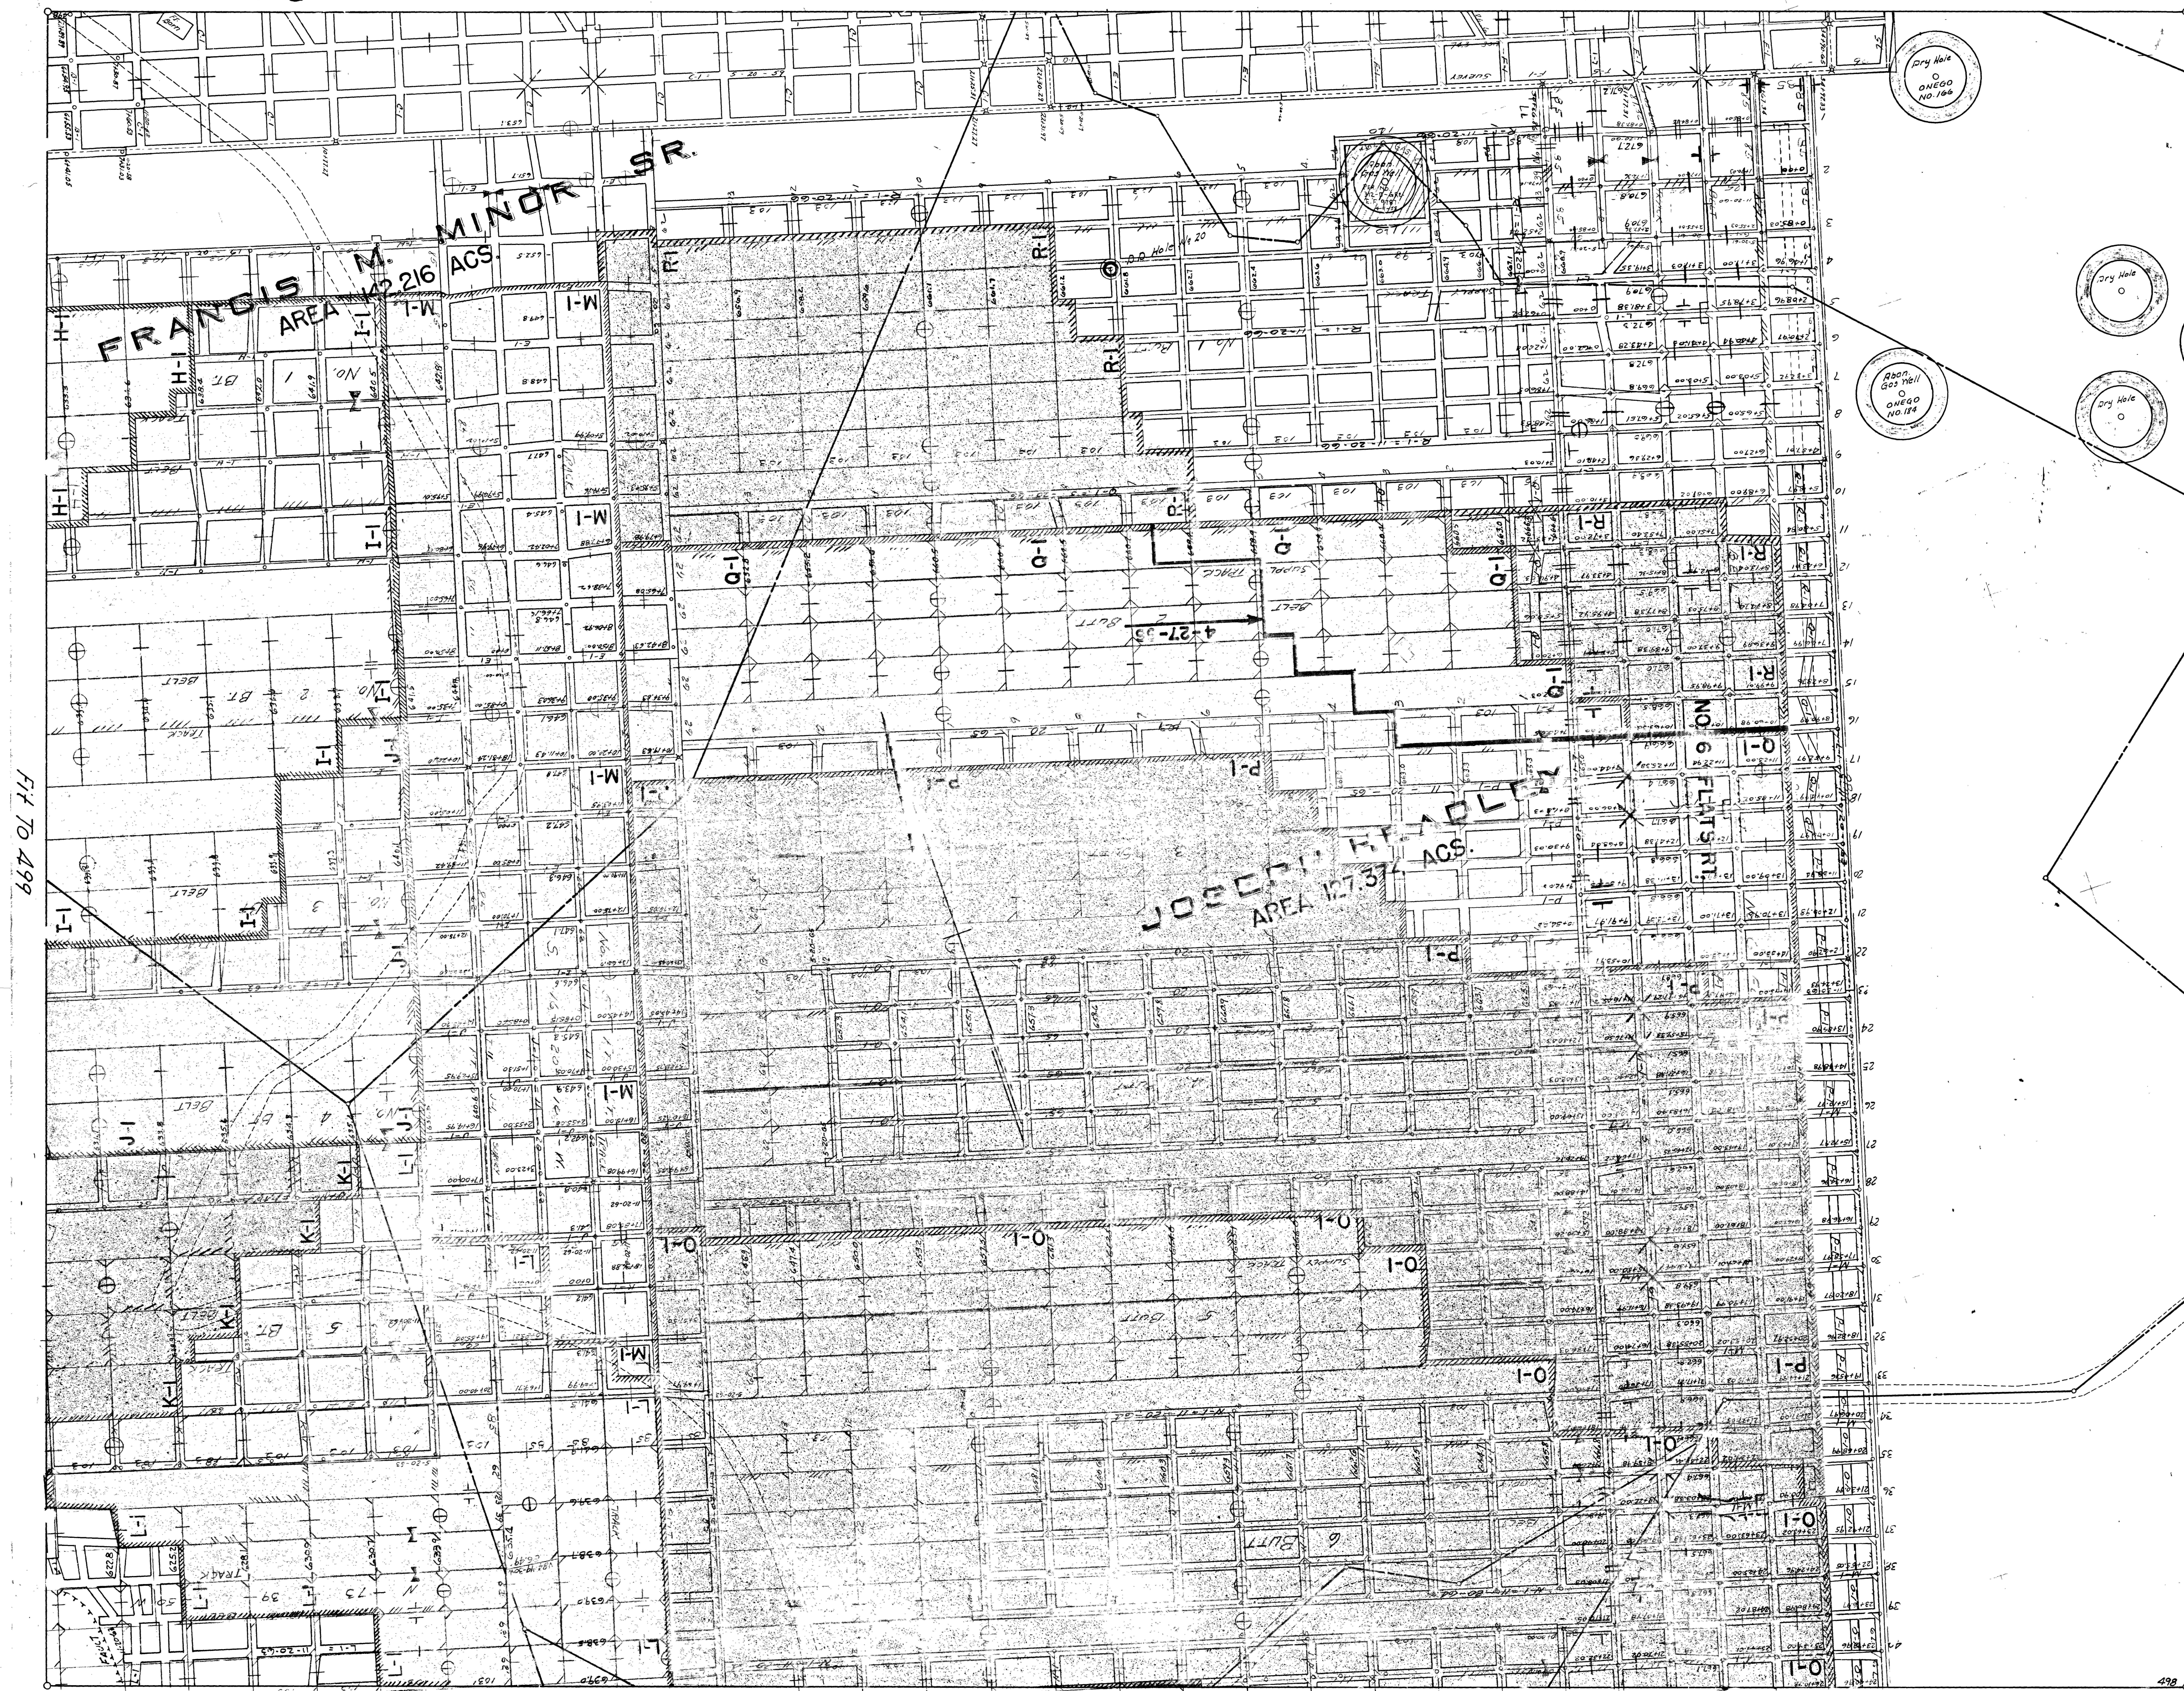

Fit To 499

Fit To 497

Fit To 522