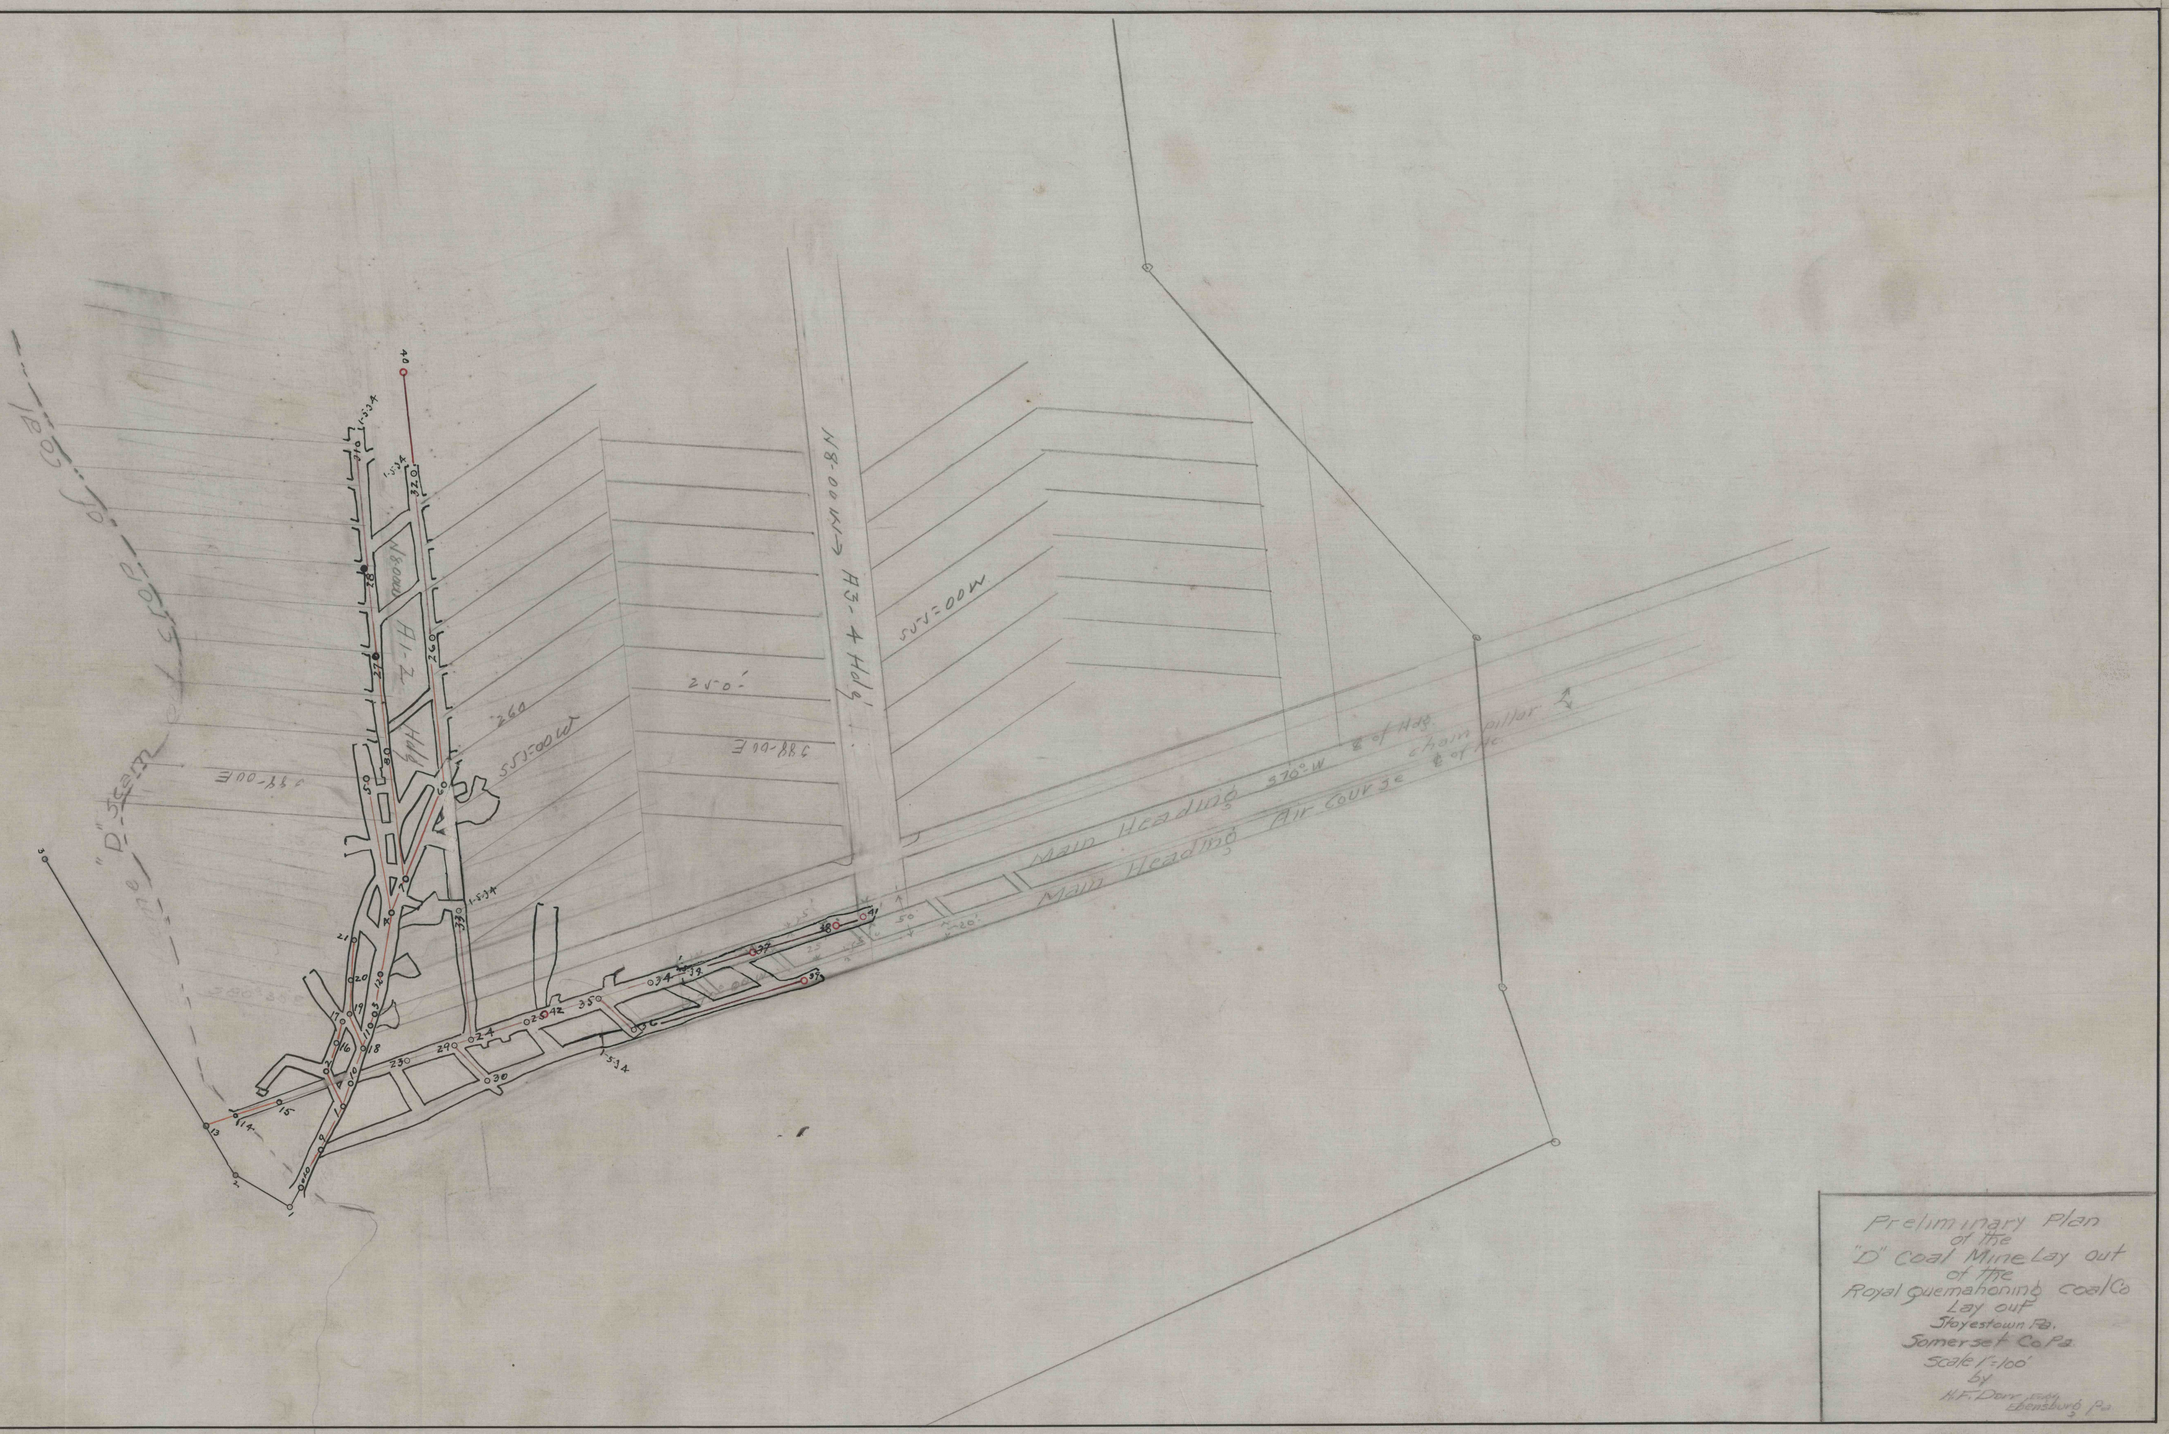



66E