


John B. Miller

Joseph Kantzy

Joseph Gray

F.A. FOX

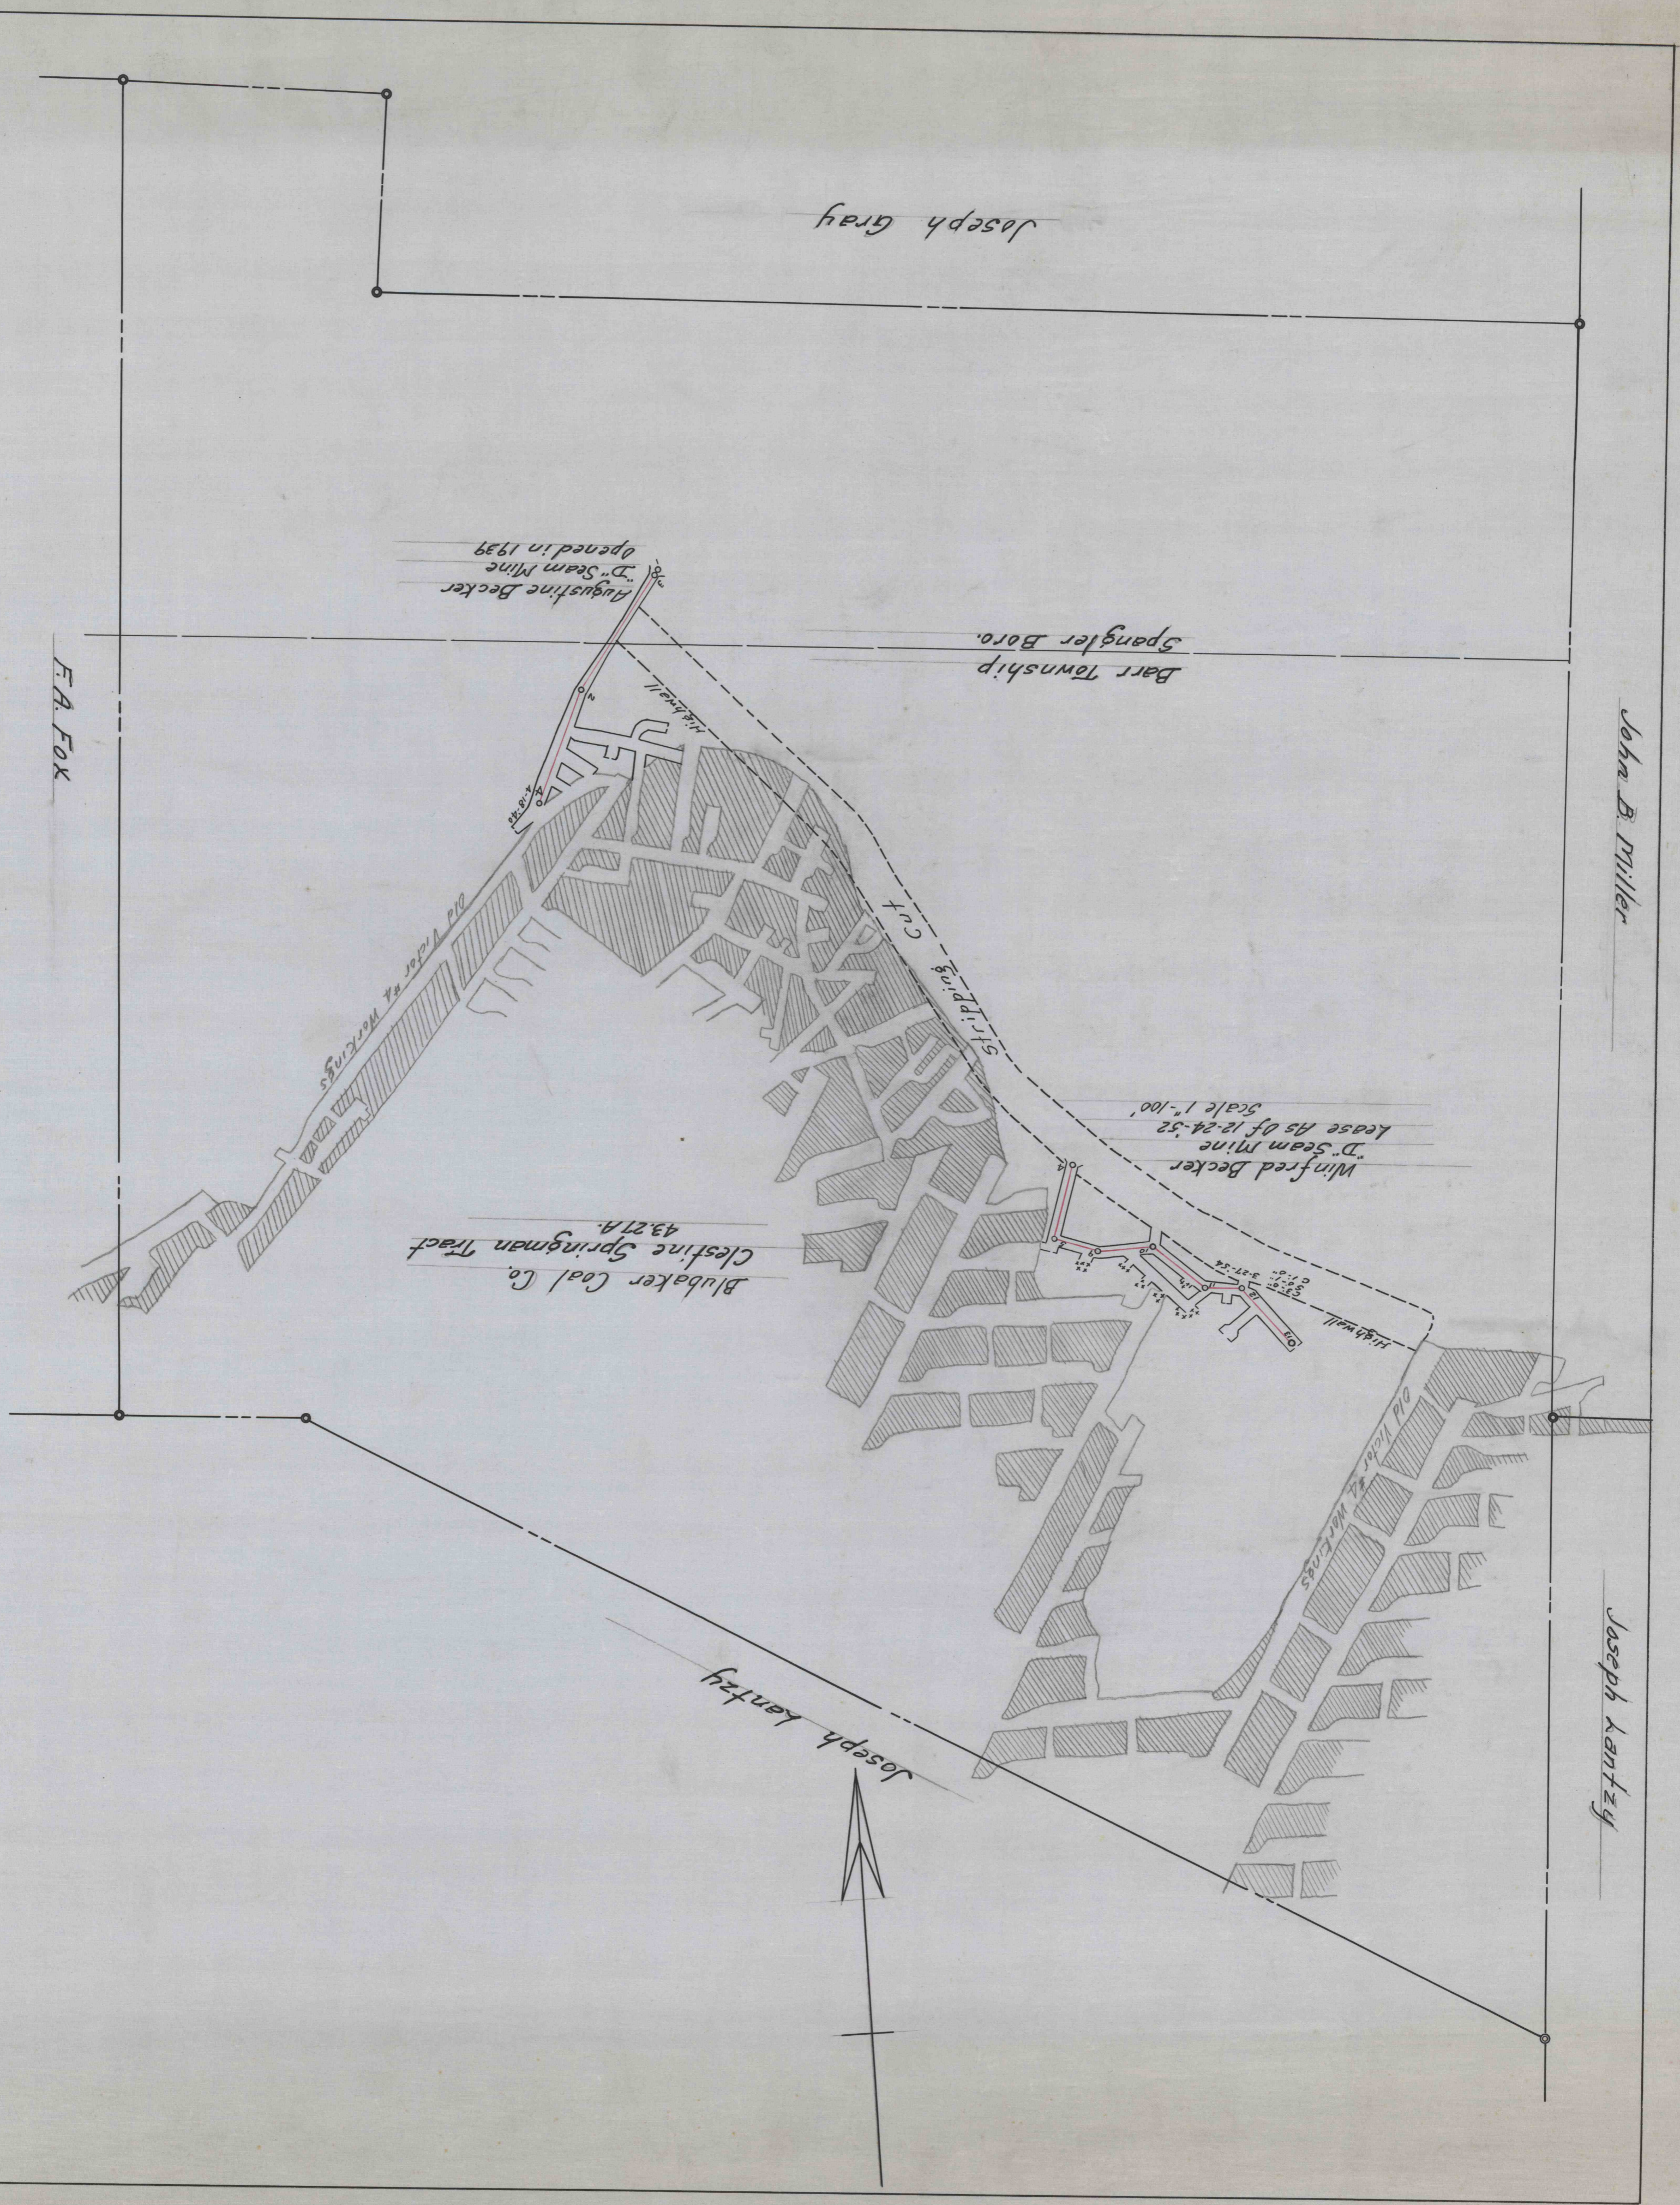

Blubaker Coal Co. Springman Tract