

part of Francis Yeager

Louis Burkhart

Chas. Baker

Part of Louis Burkhart
4.0 A

to Hastings

to St. Boniface

Francis Yeager


Michael Thomas

Map Showing
C. Prime Seam
Operated By
R. Becker
Elder Township Cambria Co. B. Noddy 1897
Scale 1"=100'

Reservation
538 acres N

John Entler
4189 A 7/81
200 A 7/2
4587 A Rev

No coal mine for 1917
residual transfer made 10-25-20

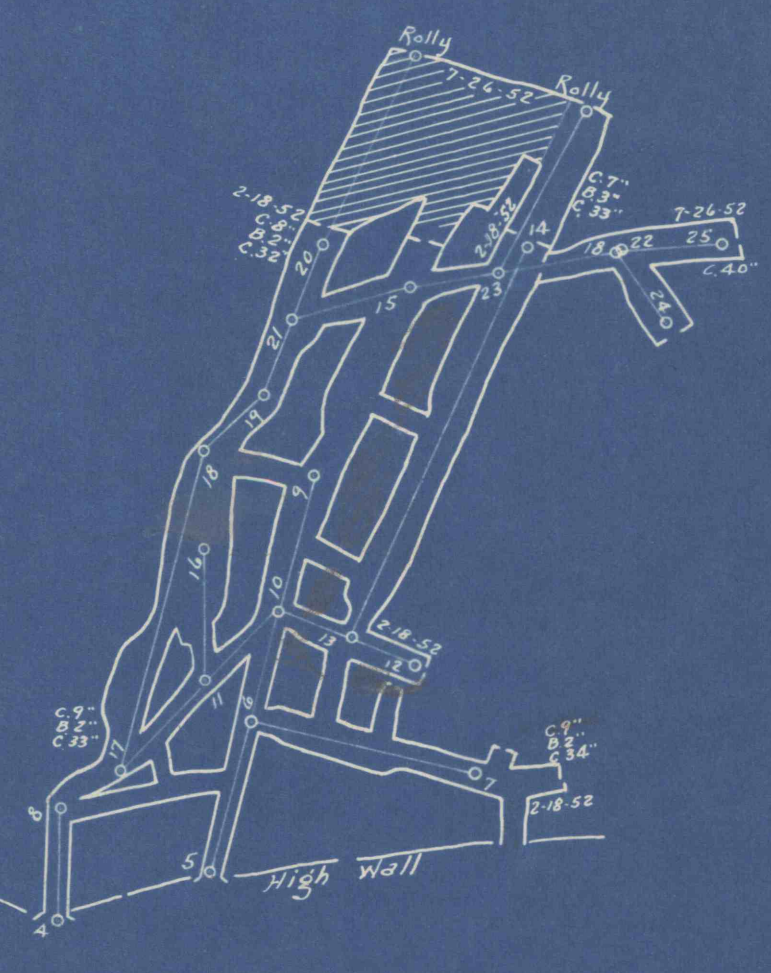

C. Prime Seam
Operated By
Edward Semelberger
Scale 1"=100'

Canad Yeager

Mined for 41/2 hrs
3050 N/1/2 hrs

Reservation 10A-50R
owned by FCC Corp.

Michael Thomas

Louis Entler