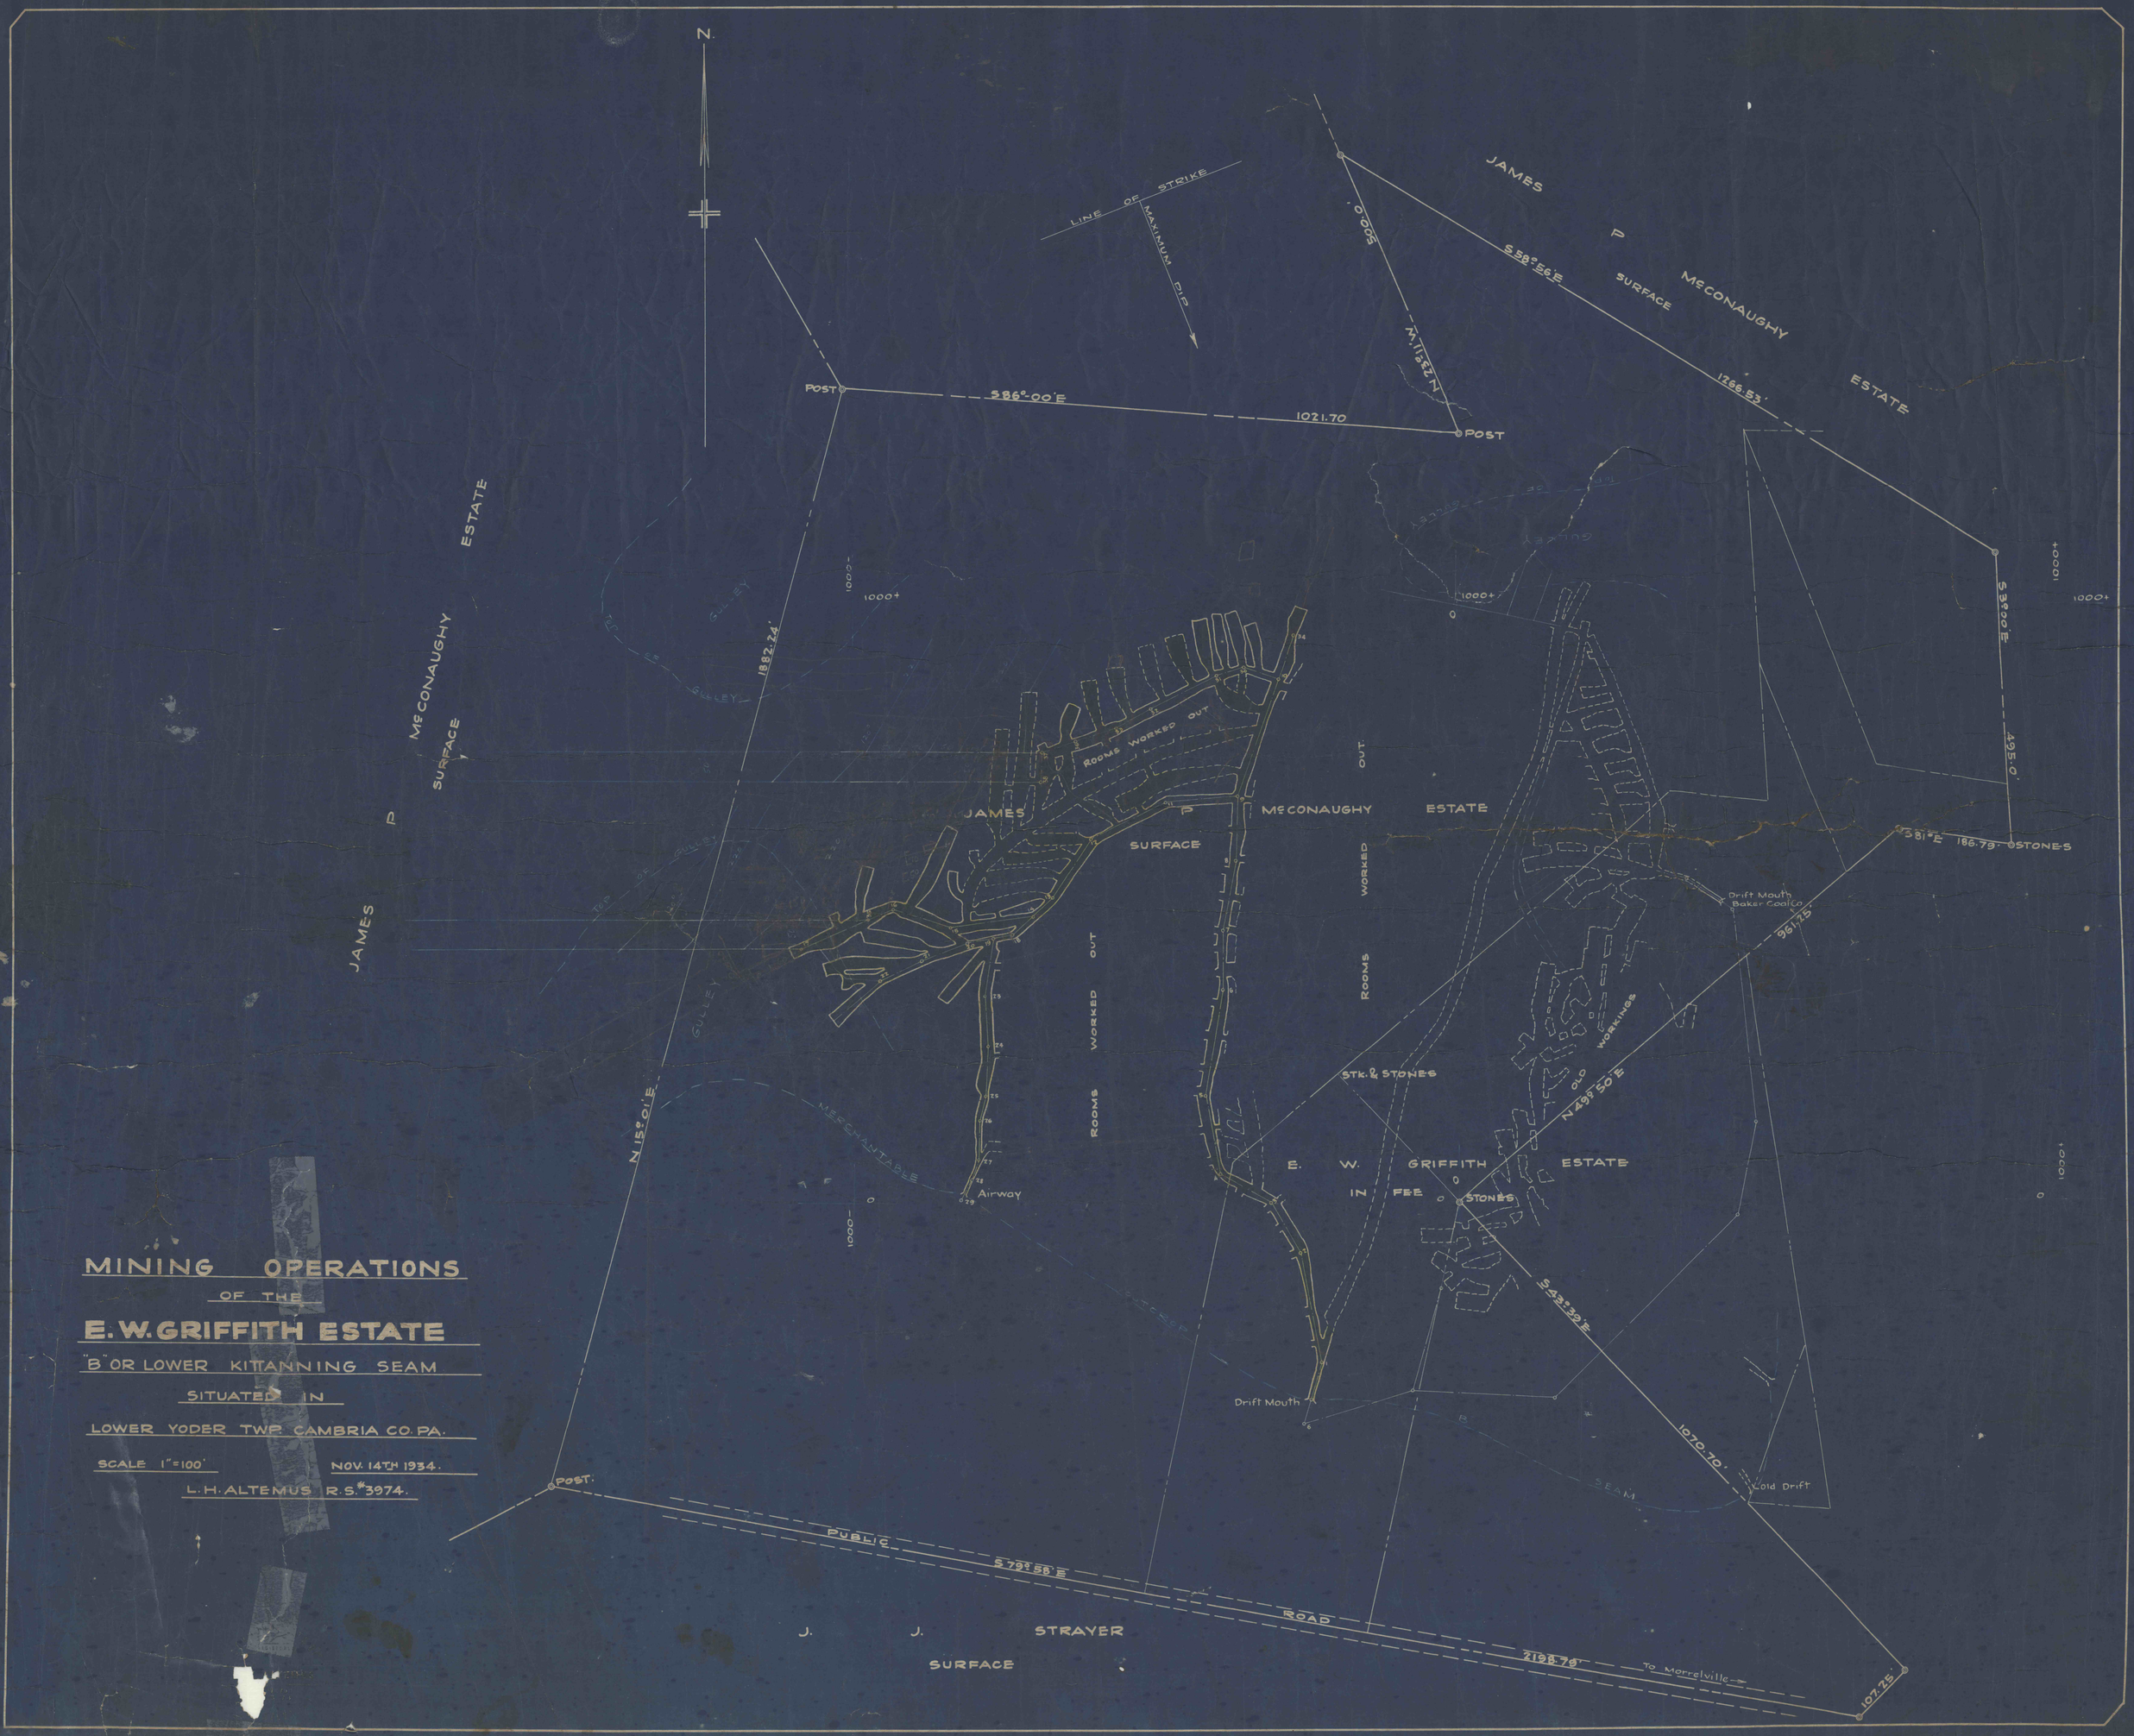
N.
LINE OF STRIKE
MAXIMUM DIP
JAMES P McCONAUGHY ESTATE
SURFACE
S58°56'E
1266.53'
500.0'
N23°11'W
POST
S86°00'E
1021.70
POST
1882.24'
1000+
1000-
GULLEY
TOP OF GULLEY
JAMES P McCONAUGHY ESTATE
SURFACE
ROOMS WORKED OUT
JAMES P McCONAUGHY ESTATE
SURFACE
ROOMS WORKED OUT
ROOMS WORKED OUT
S3°00'E
495.0'
S81°E 186.79' STONES
Drift Mouth Baker Coal Co.
961.25'
OLD WORKINGS
N49°50'E
STK. & STONES
N15°01'E
MERCHANTABLE
Airway
E. W. GRIFFITH ESTATE
IN FEE
STONES
S43°39'E
1070.70'
Drift Mouth
Cold Drift
SEAM
POST
PUBLIC ROAD
S79°58'E
2198.79'
To Morrelville
107.25'
J. J. STRAYER
SURFACE
MINING OPERATIONS
OF THE
E. W. GRIFFITH ESTATE
"B" OR LOWER KITTANNING SEAM
SITUATED IN
LOWER YODER TWP. CAMBRIA CO. PA.
SCALE 1"=100'
NOV. 14TH 1934.
L. H. ALTEMUS R.S. #3974.

1-A-58