

ROUTE No. 32013 - EAST WHEATFIELD TWP. - INDIANA CO. PA.

OWNER OF MINERAL:

DIAMOND SMOKELESS COAL CO.
JOHNSTOWN BANK & TRUST BLDG.,
JOHNSTOWN, PA.

OPERATING COMPANY:

IMPERIAL COAL CORPORATION
JOHNSTOWN BANK & TRUST BLDG.,
JOHNSTOWN, PA.
MINE OFFICE: BOLTZ, PA.

MINING ENGINEERS:

FETTERMAN ENG. CO.
JOHNSTOWN BANK & TRUST BLDG.,
JOHNSTOWN, PA.

SCALE: - 1" = 100'

MARKERS:

- ON TELEPHONE POLE
- ON STEEL PLATE

UNIMPROVED ROADS - YELLOW

IMPROVED ROADS - RED


LLEWELLYN

WILLIAMS

LESTER

MATTHEWS

DR. W. E. MATTHEWS

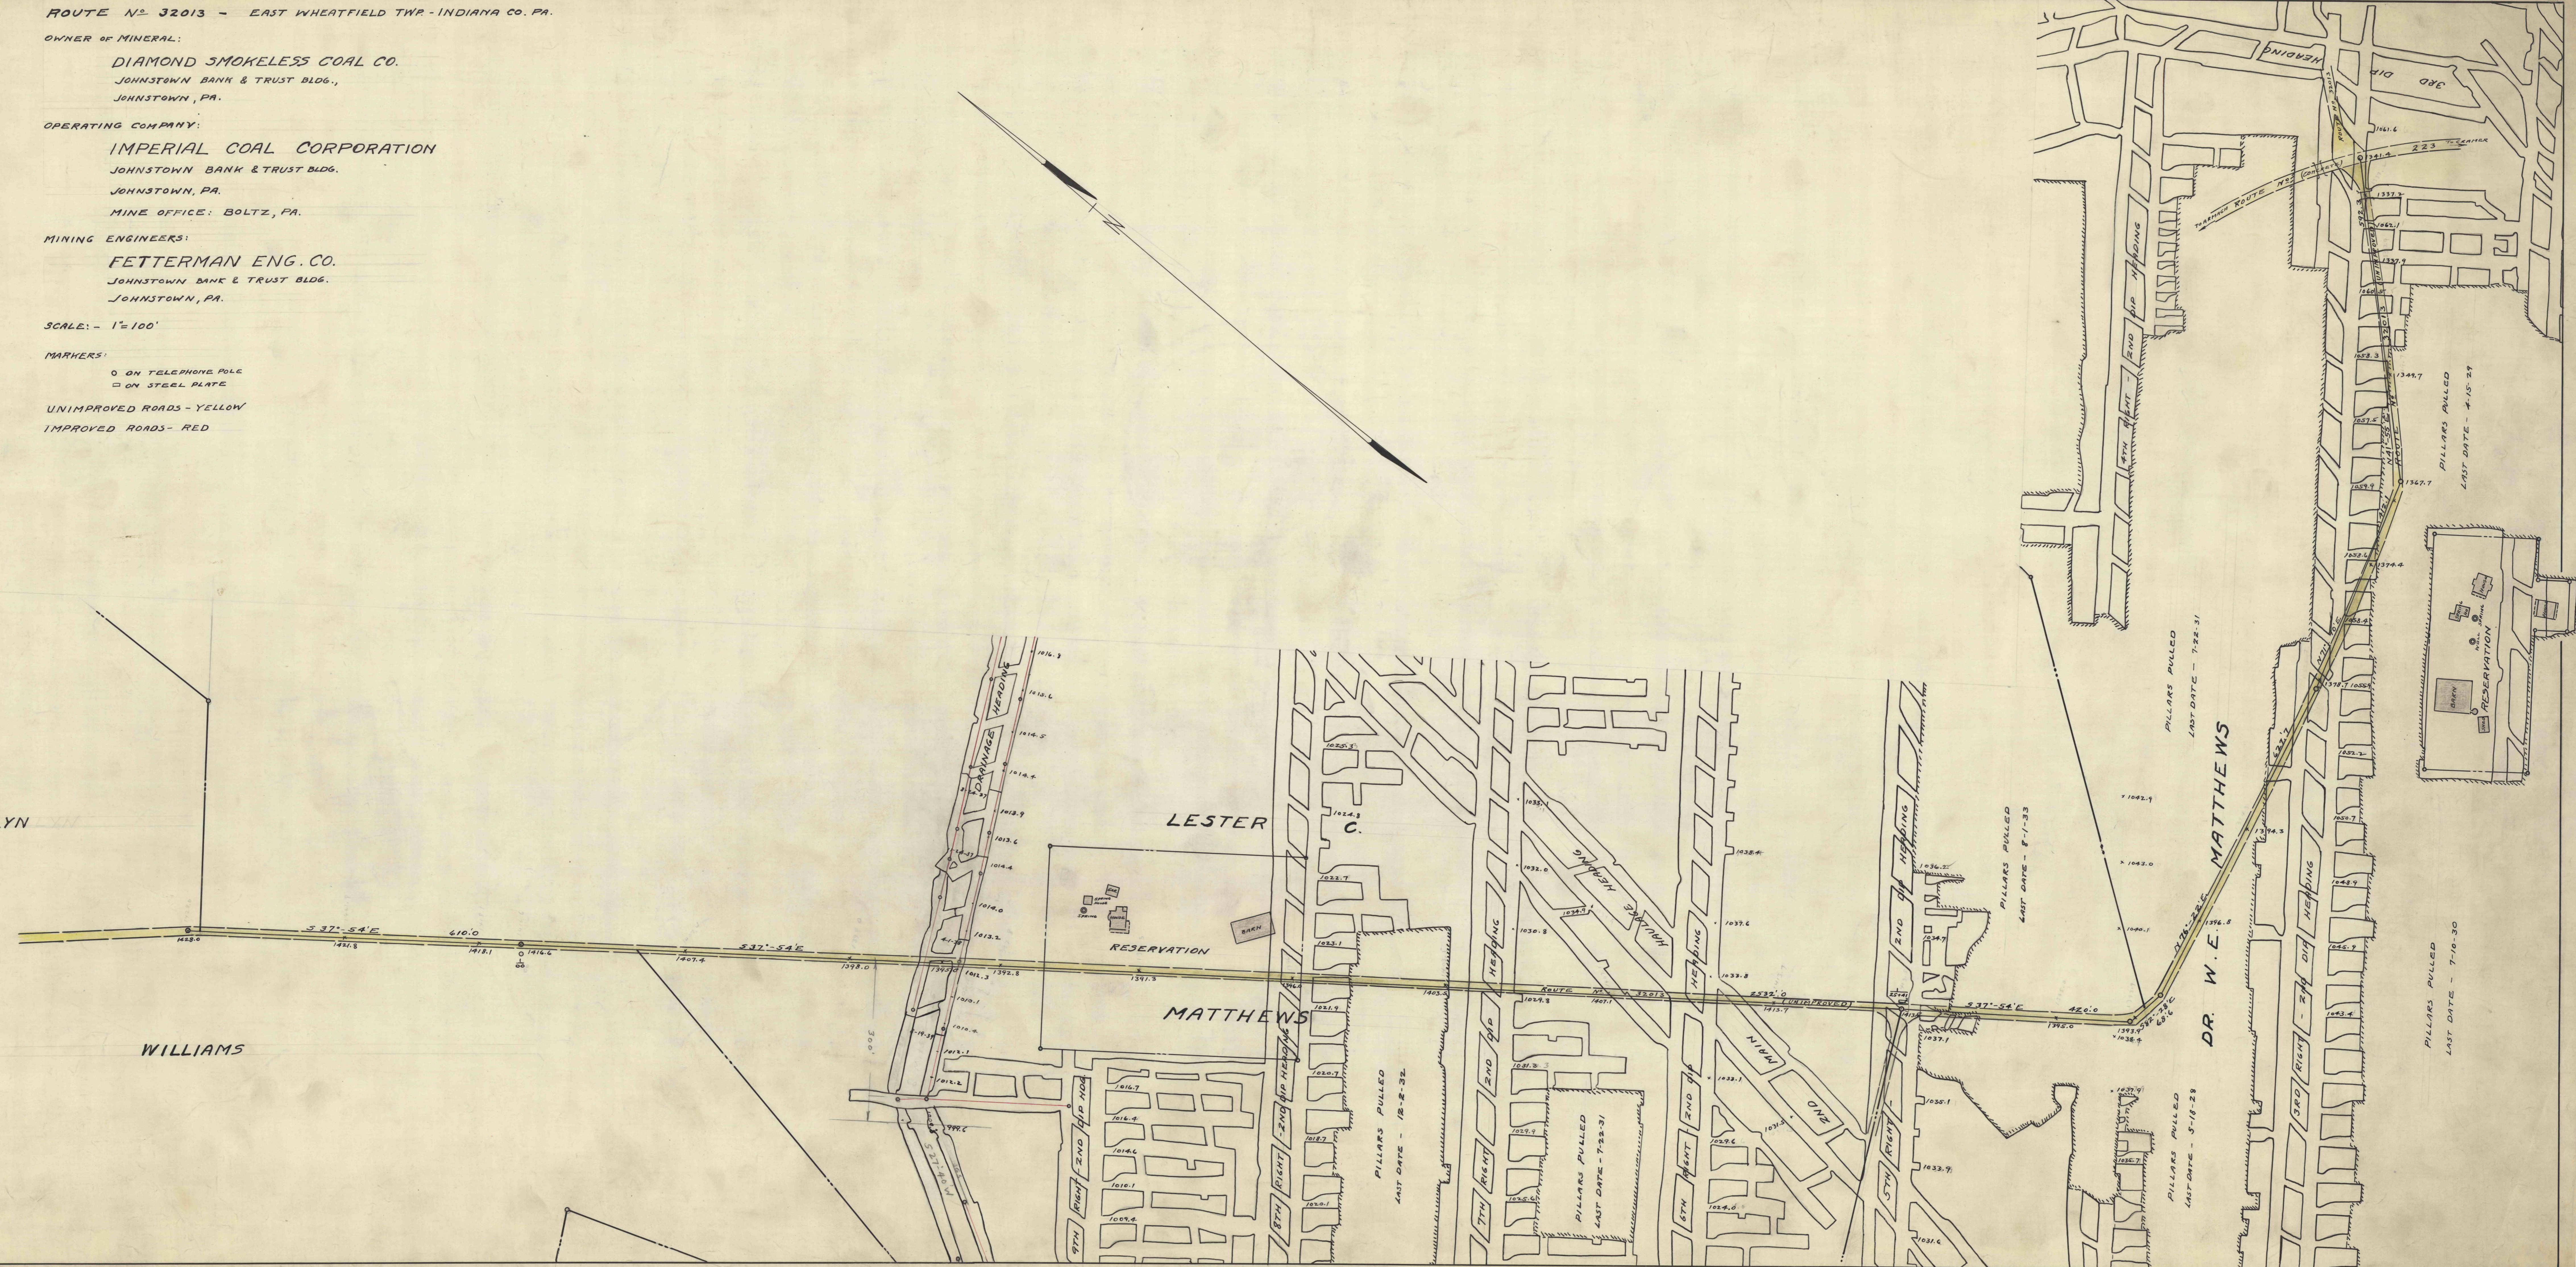

PILLARS PULLED
LAST DATE - 12-2-32

PILLARS PULLED
LAST DATE - 7-23-31

PILLARS PULLED
LAST DATE - 8-1-33

PILLARS PULLED
LAST DATE - 5-18-28

PILLARS PULLED
LAST DATE - 7-22-31

PILLARS PULLED
LAST DATE - 7-10-30

PILLARS PULLED
LAST DATE - 4-15-27