

ROUTE N^o 1

OWNER OF MINERAL

DIAMOND SMOKELESS COAL CO. MINING ENGINEERS

JOHNSTOWN BANK & TRUST BLDG.

JOHNSTOWN, PA.

OPERATING COMPANY

IMPERIAL COAL CORP

JOHNSTOWN BANK & TRUST BLDG.

JOHNSTOWN, PA.

MINE OFFICE: BOLTZ, PA.

FETTERMAN ENG CO.

JOHNSTOWN BANK & TRUST BLDG.

JOHNSTOWN, PA.


SCALE 1"=100'

MARKERS

○ ON TELEGRAPH POLE

UNIMPROVED ROADS - YELLOW

IMPROVED ROADS - RED

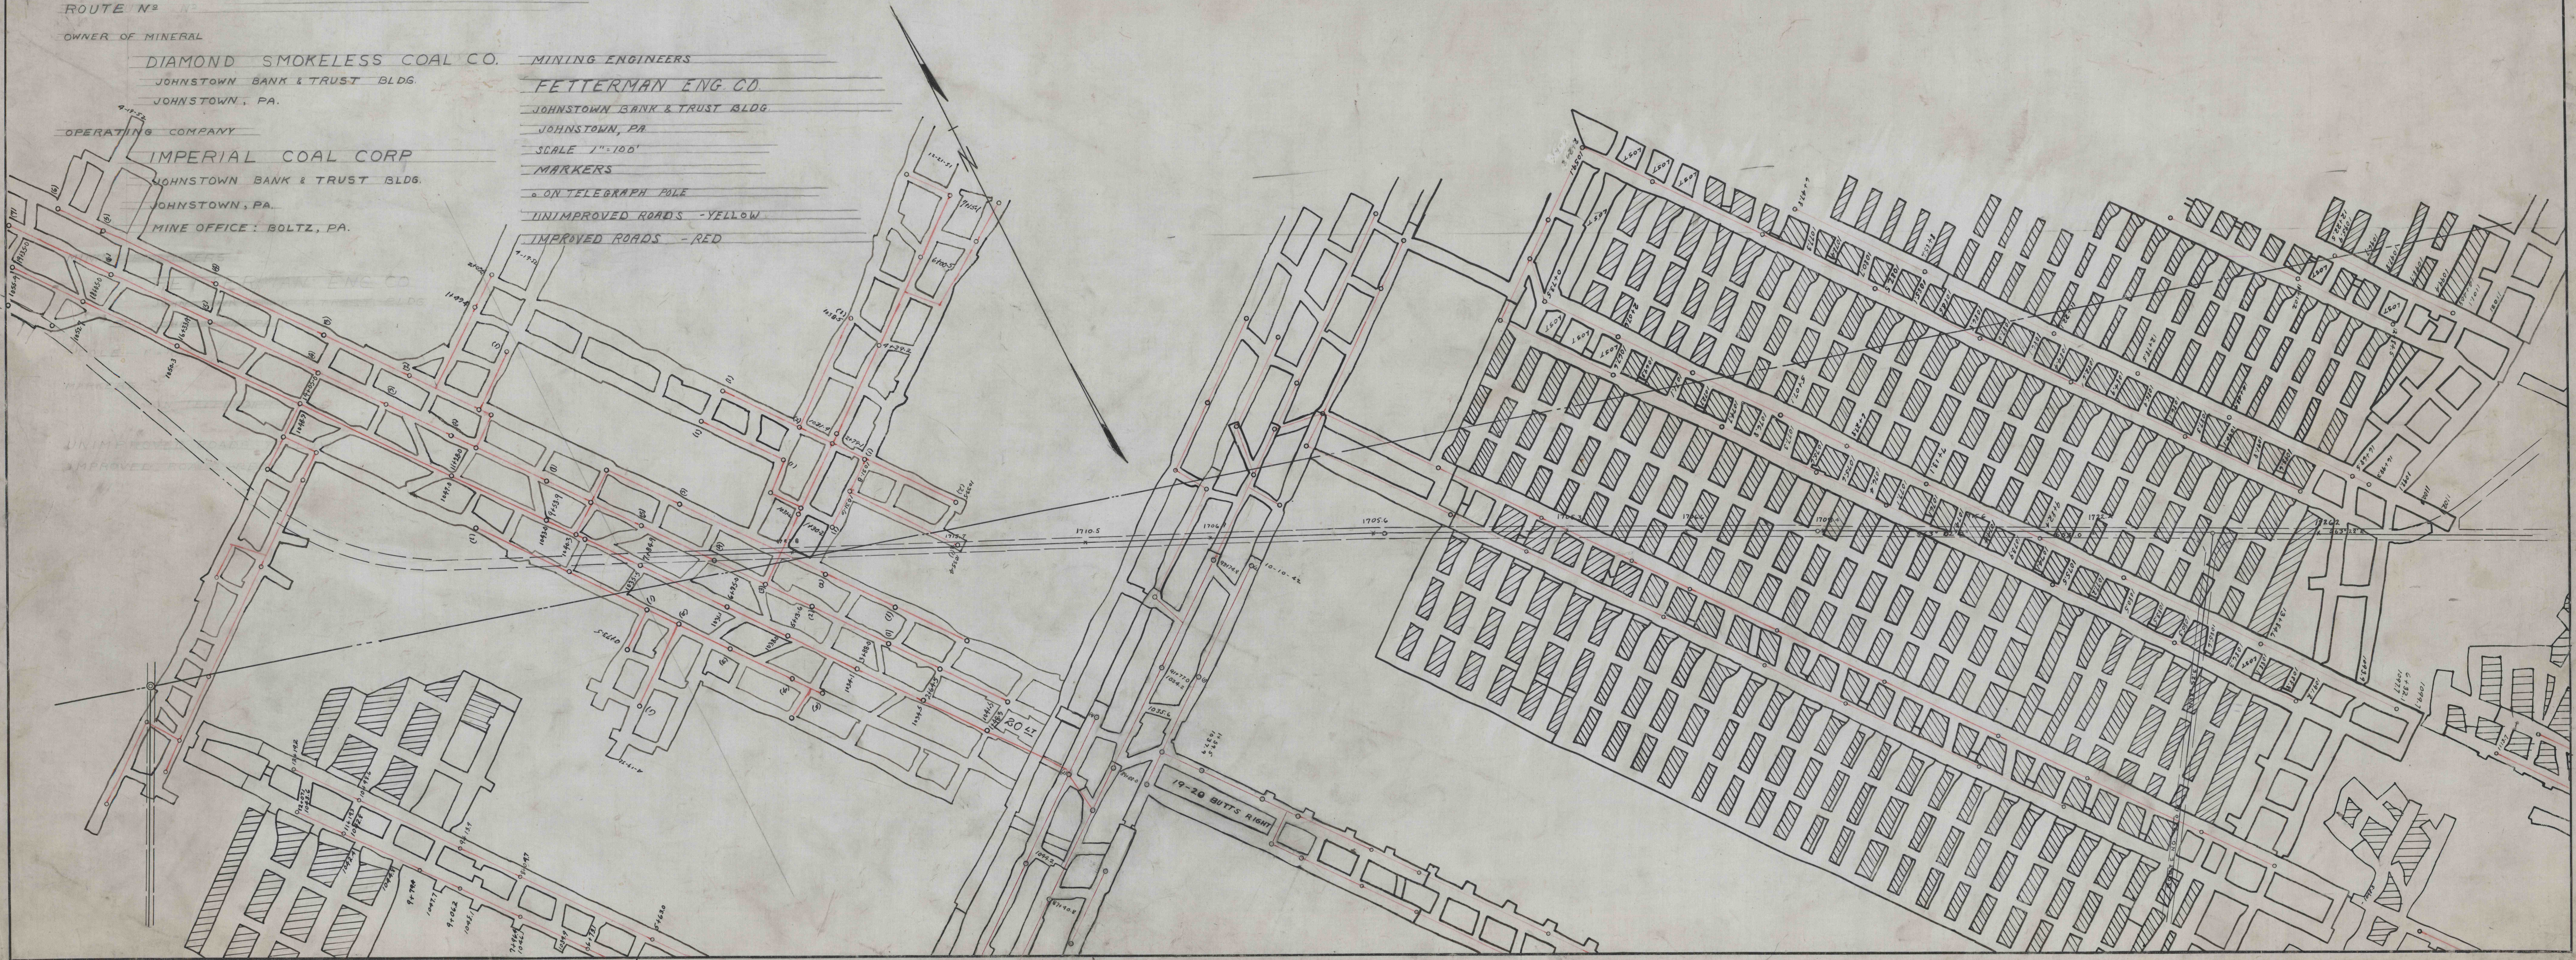

115-117
115-119
19-20 BUTTS RIGHT





