



COAL M'N'G. CO. CO.

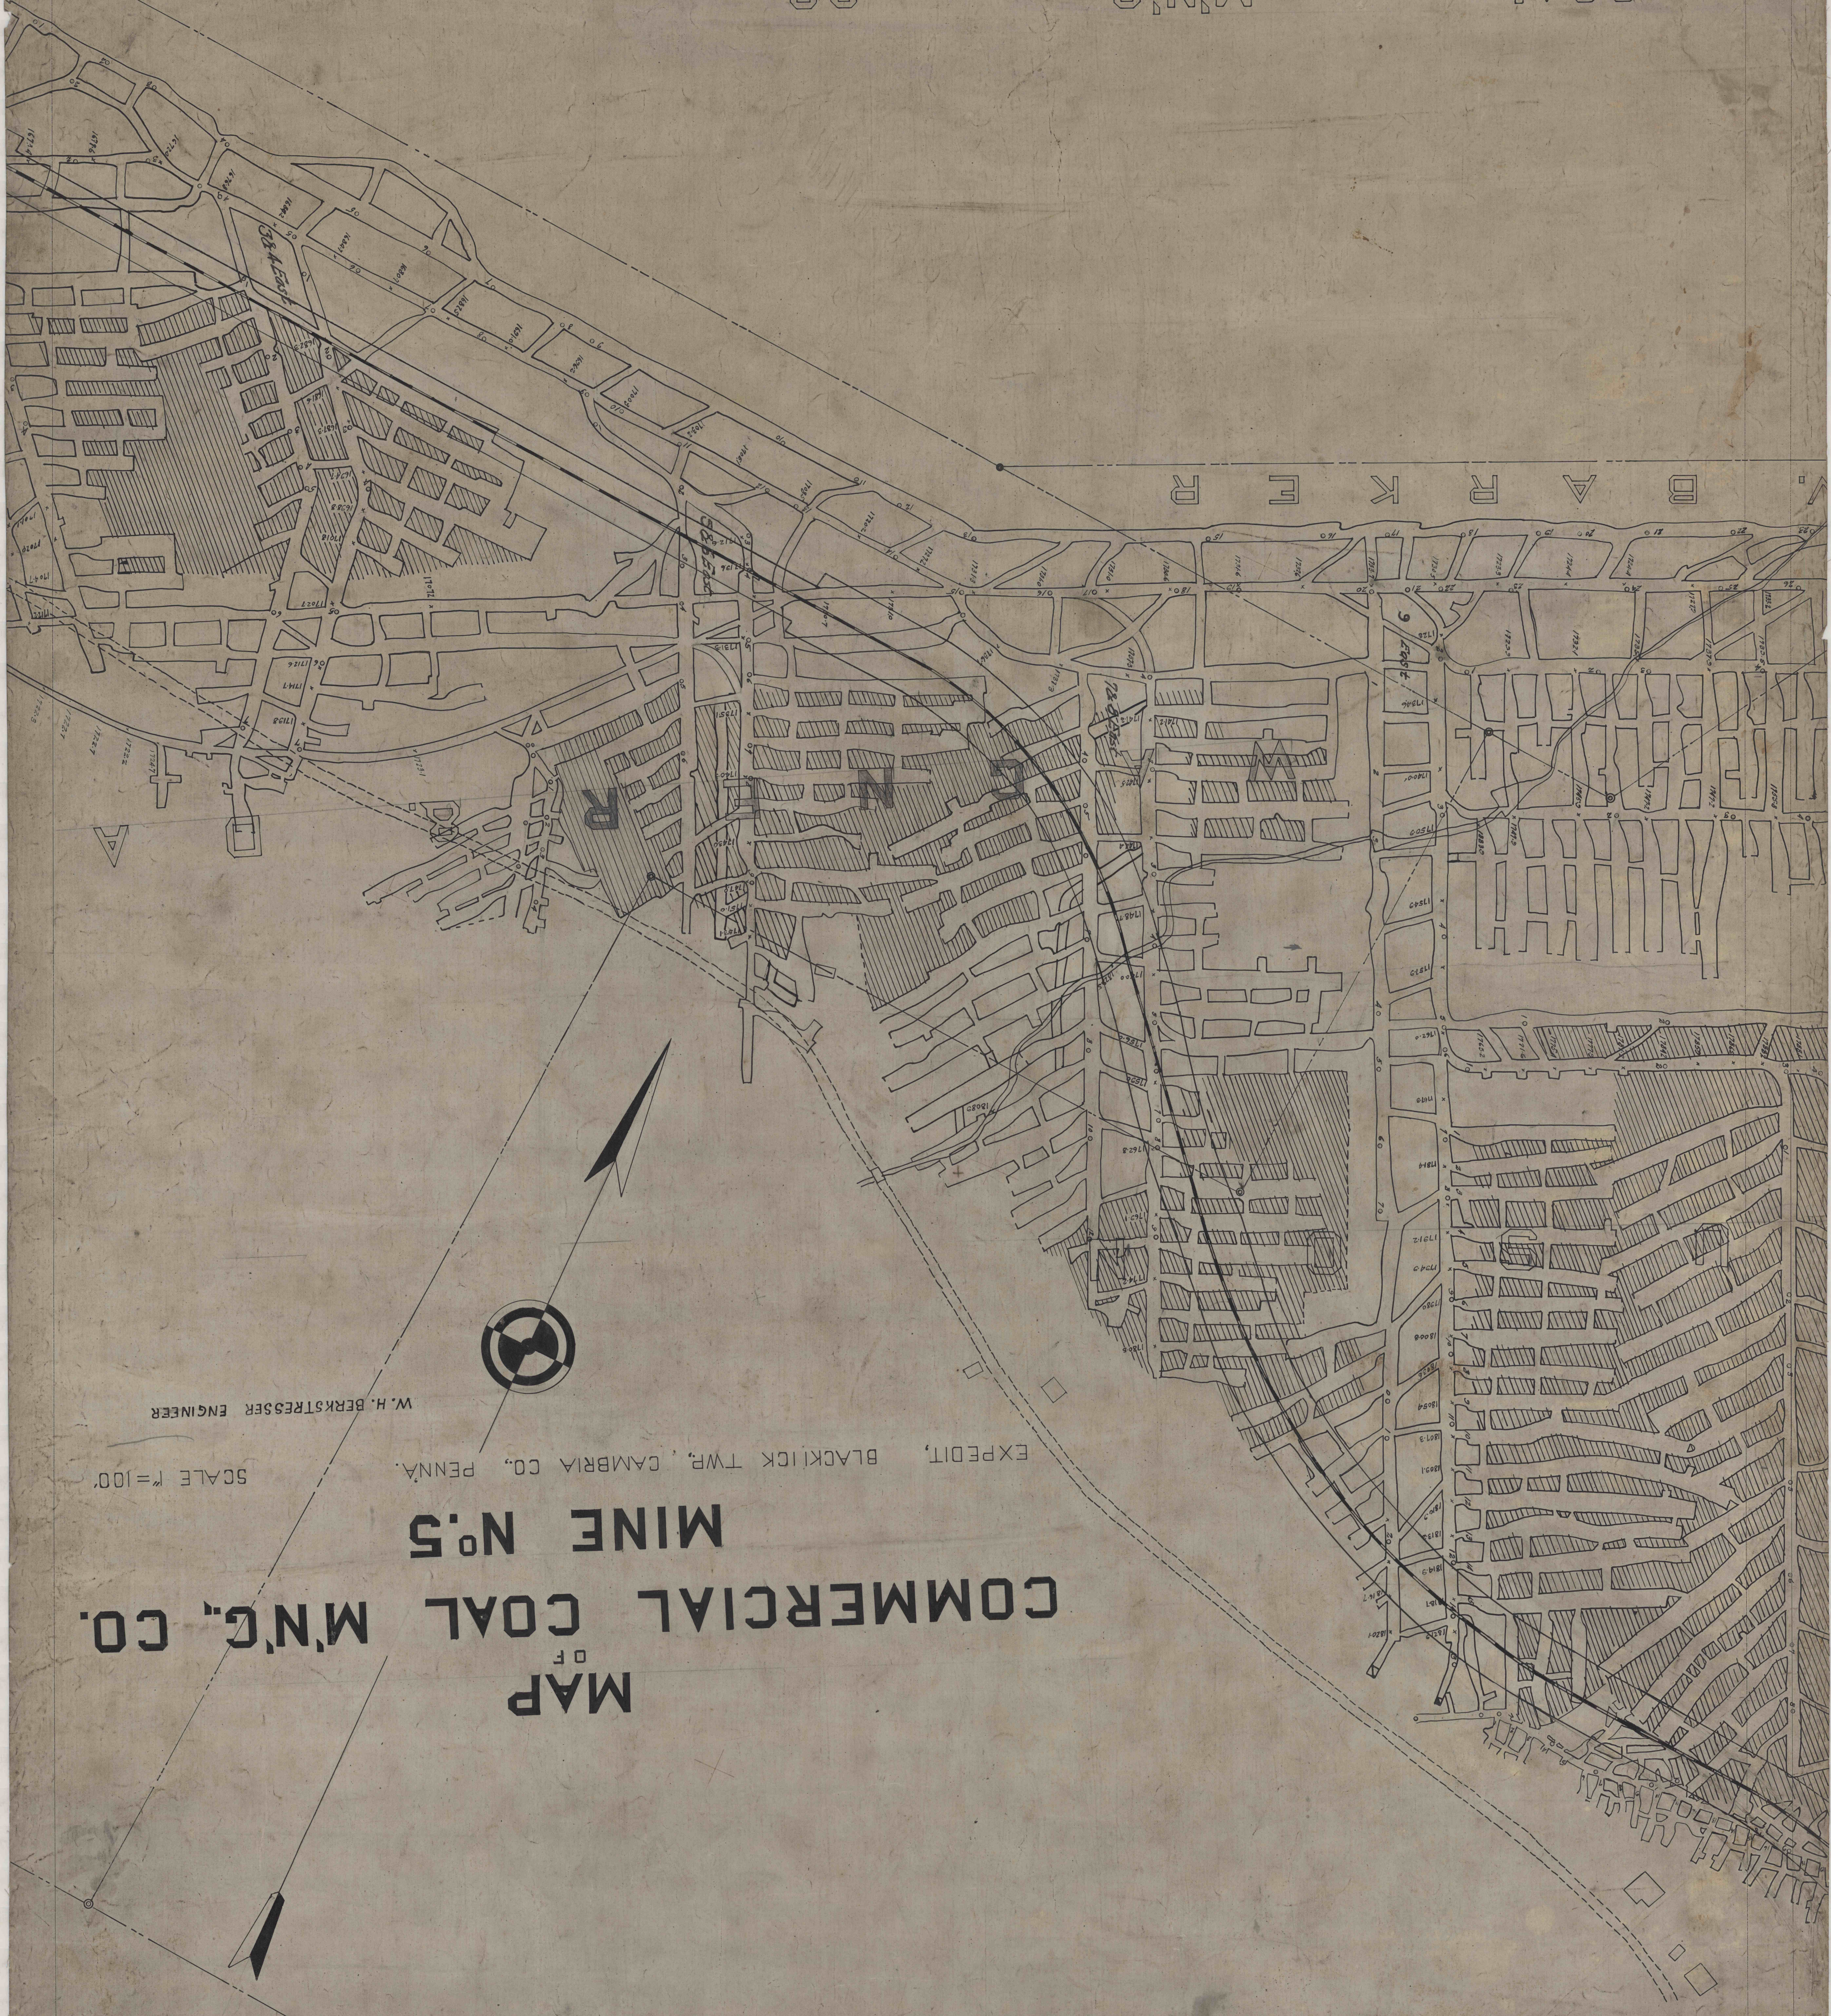

MAP
OF
COMMERCIAL COAL M'N'G. CO.
MINE No. 5
EXPEDIT, BLACKICK TWP, CAMBRIA CO., PENNA.
SCALE 1"=100'
W. H. BERKSTRESSER ENGINEER

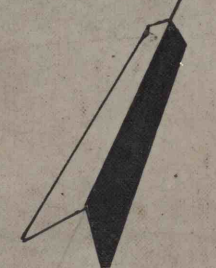

X-500 500 31