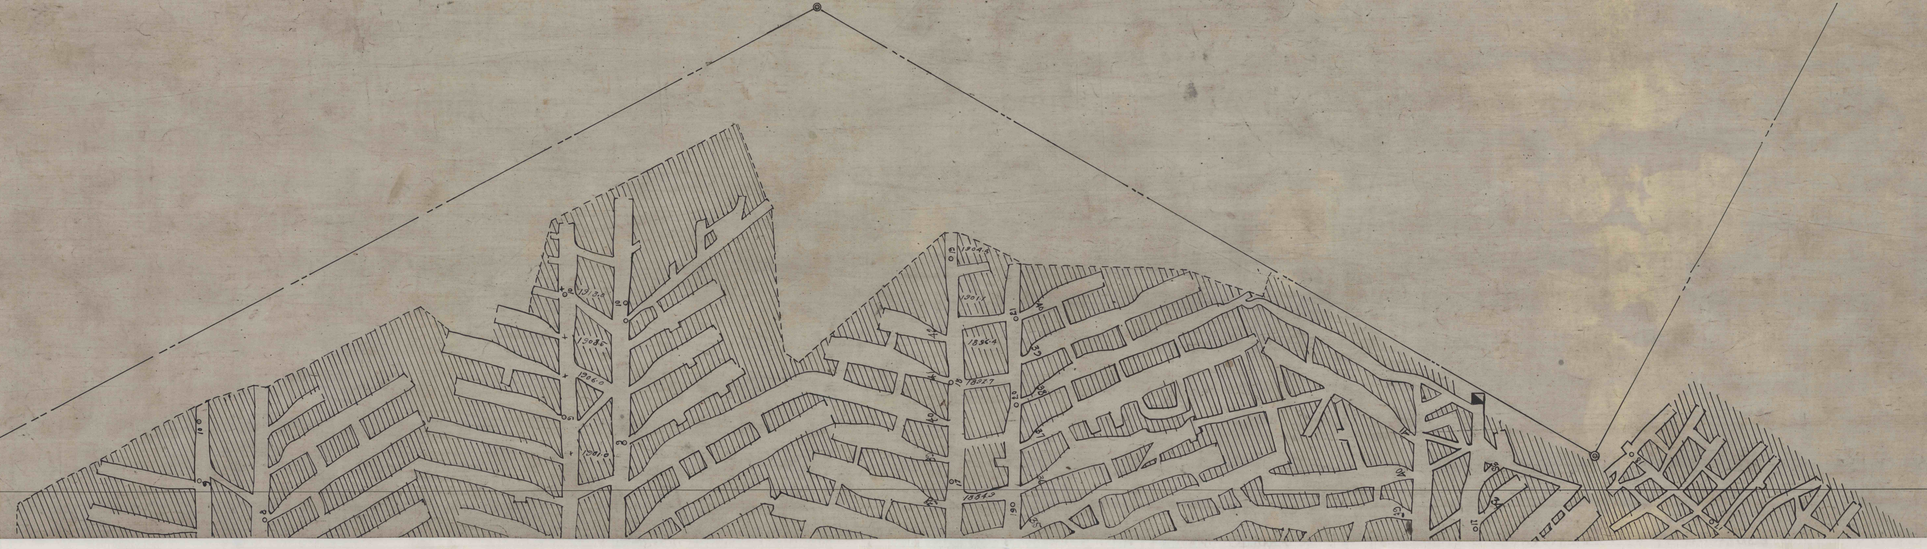THE IMPERIAL COAL M'N'G., CO.