PROPERTY OF THE R.C.M.CO. ST. BENEDICT, PA.

Sh. 1 OF 10

Here

make all for BARR

To SH 5

SH 1

To SH 4

BARR No1 SEC.

Sh 1 OF 10

To Sheet 4

SH-1

To Sheet 2

To SH. 2

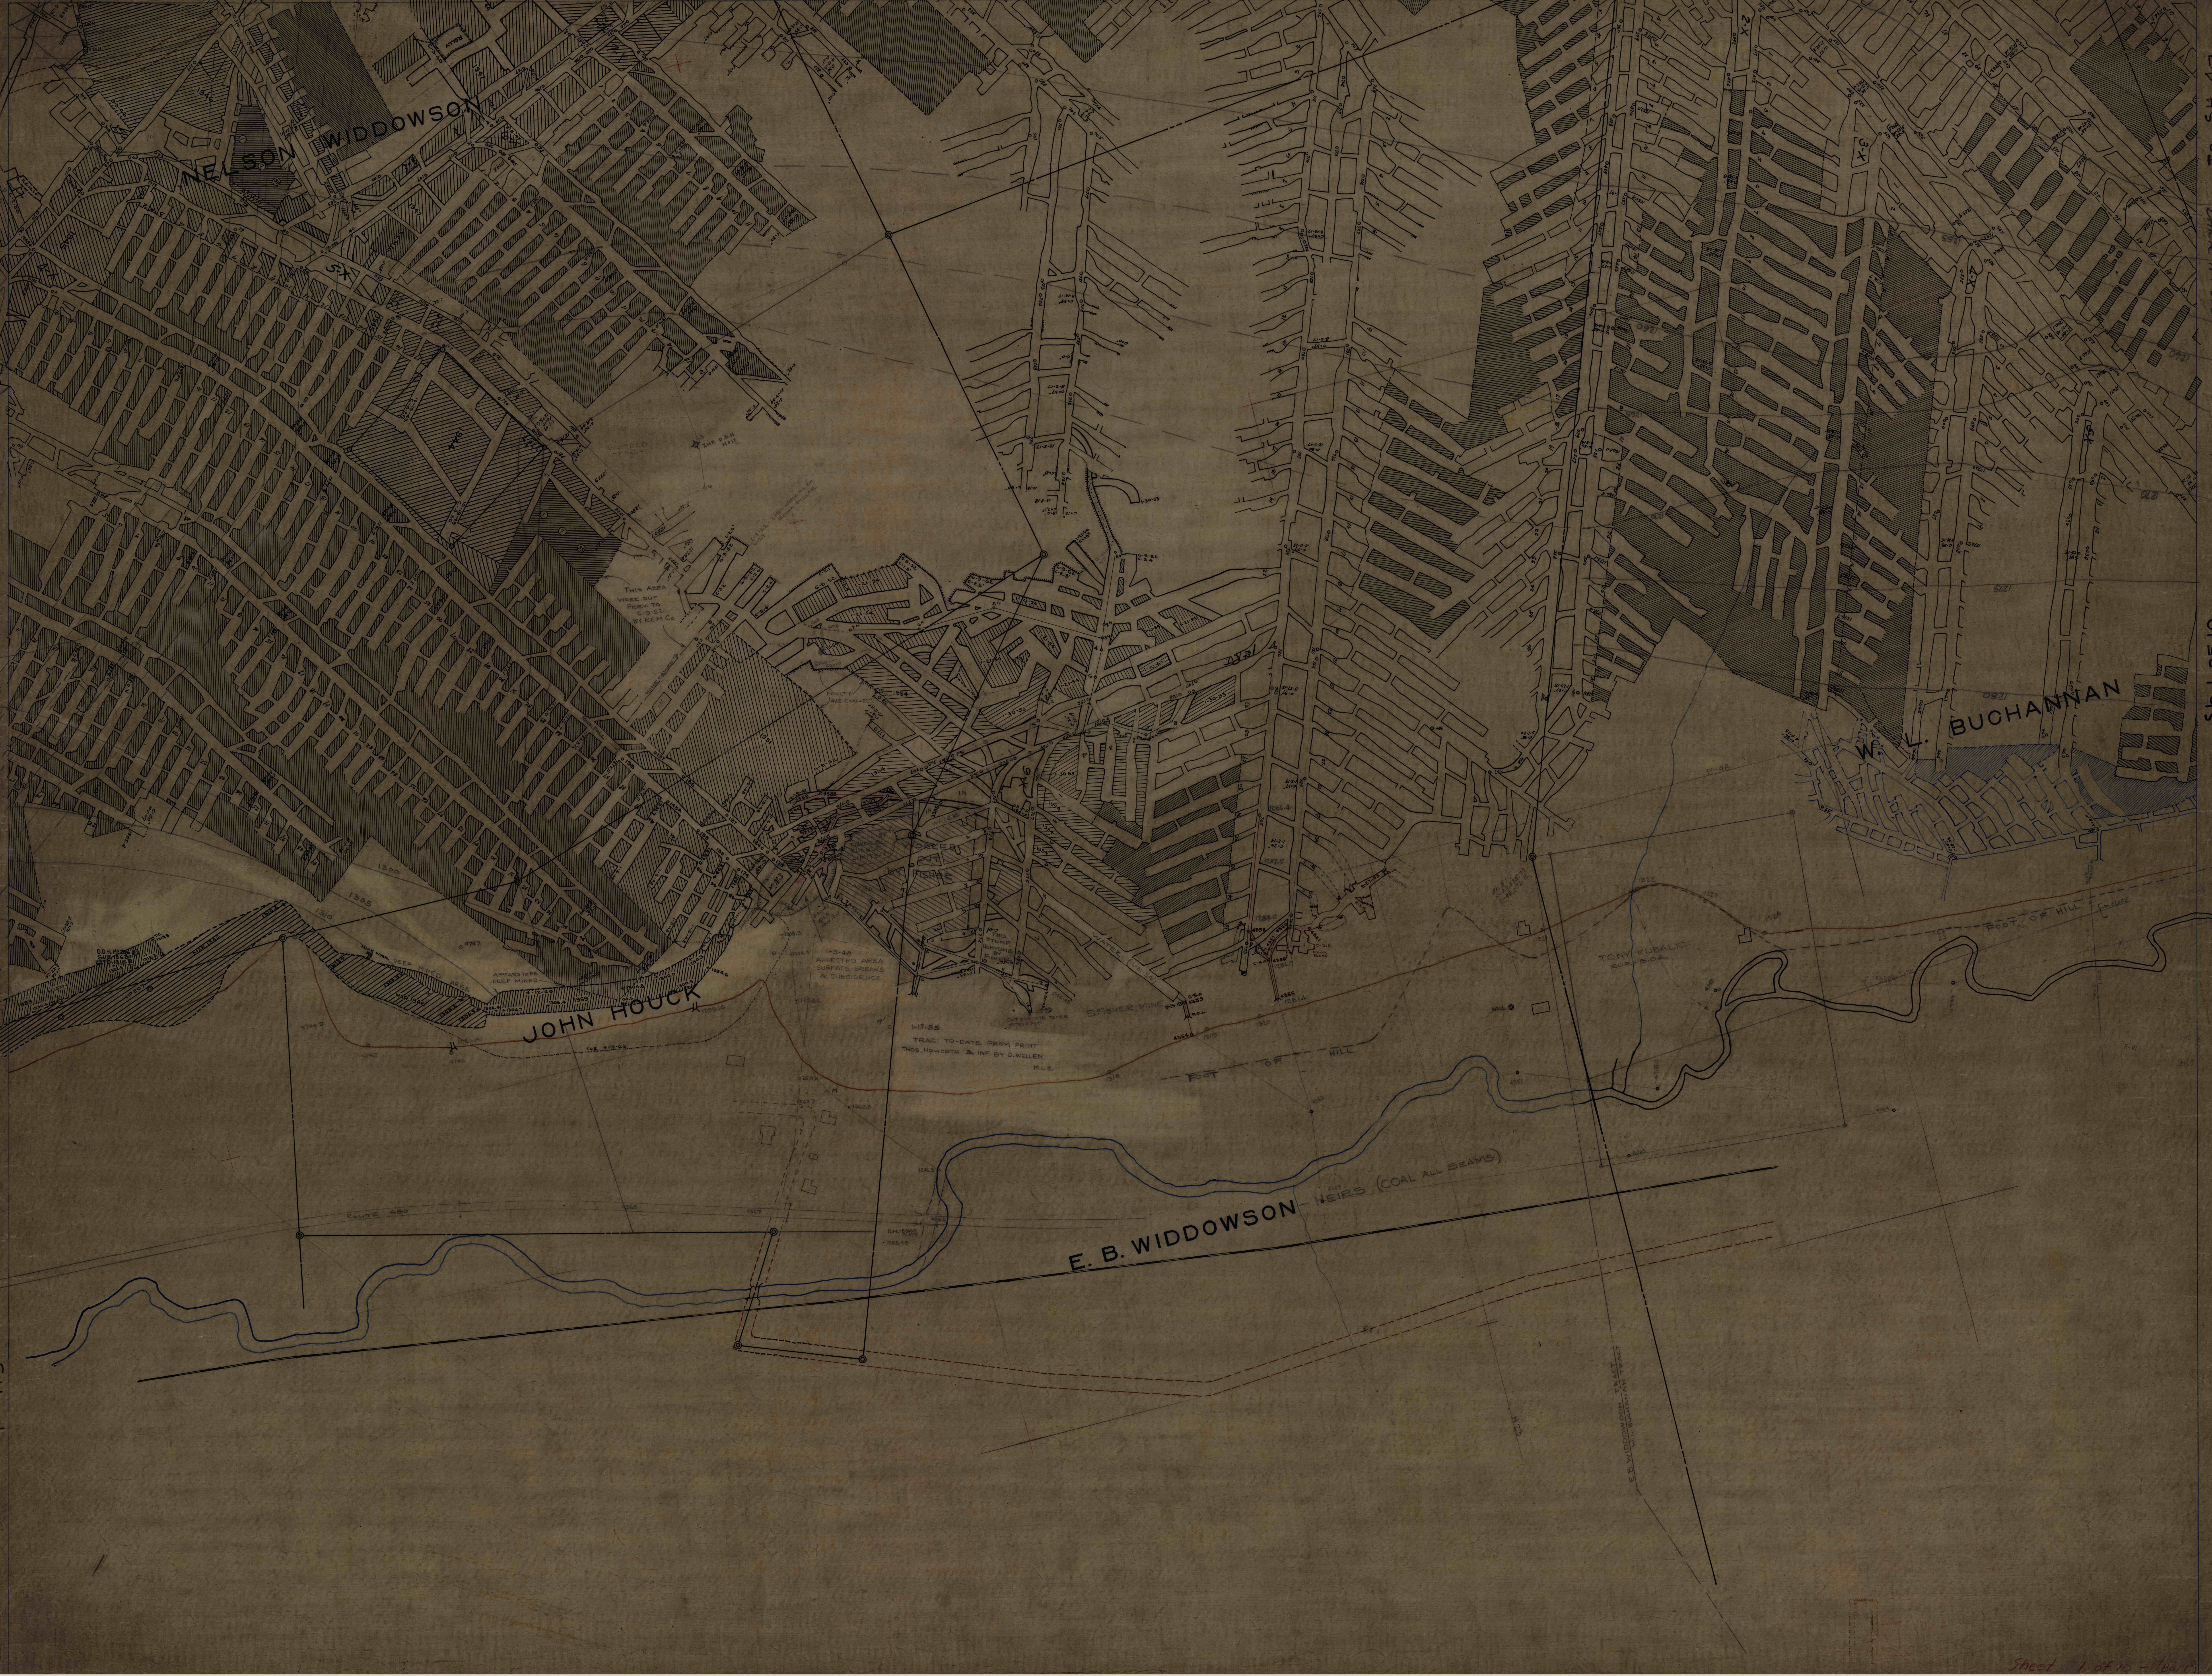
NELSON WIDDOWSON
5-X
JOHN HOUCK
E. B. WIDDOWSON HEIRS (COAL ALL SEAMS)
W. L. BUCHANNAN
TONY KUBALIC SUR. 8.0A.
2-X
3-X
4-X
1300
1305
1310
1260
1265
1270
1275
1280
ROUTE 480
FOOT OF HILL
E. FISHER MINE
WATER
WORKED OUT BY FISHER
MAR. 1946
DEEP MINED AREA
APPEARS TO BE DEEP MINED
WOODED -PINES-
ROCK FALL
WELL
WIRE FENCE
PROP. LINE
E-48
N 23
E.B. WIDDOWSON TRACT
W.L. BUCHANAN TRACT

THIS AREA WORK OUT PREV. TO 6-9-52 BY R.C.M.Co

1-5-48 AFFECTED AREA SURFACE BREAKS & SUBSIDENCE

THIS STUMP HONYCOMB BY FISHER

CUT OUT INTO TOMER STRIP PIT

1-17-55
TRAC. TO-DATE FROM PRINT
THOS. HOWORTH & INF. BY D. WELLEN.
M.L.B.

Sheet 1 of 10 - (Barr)