


B-1

B-2

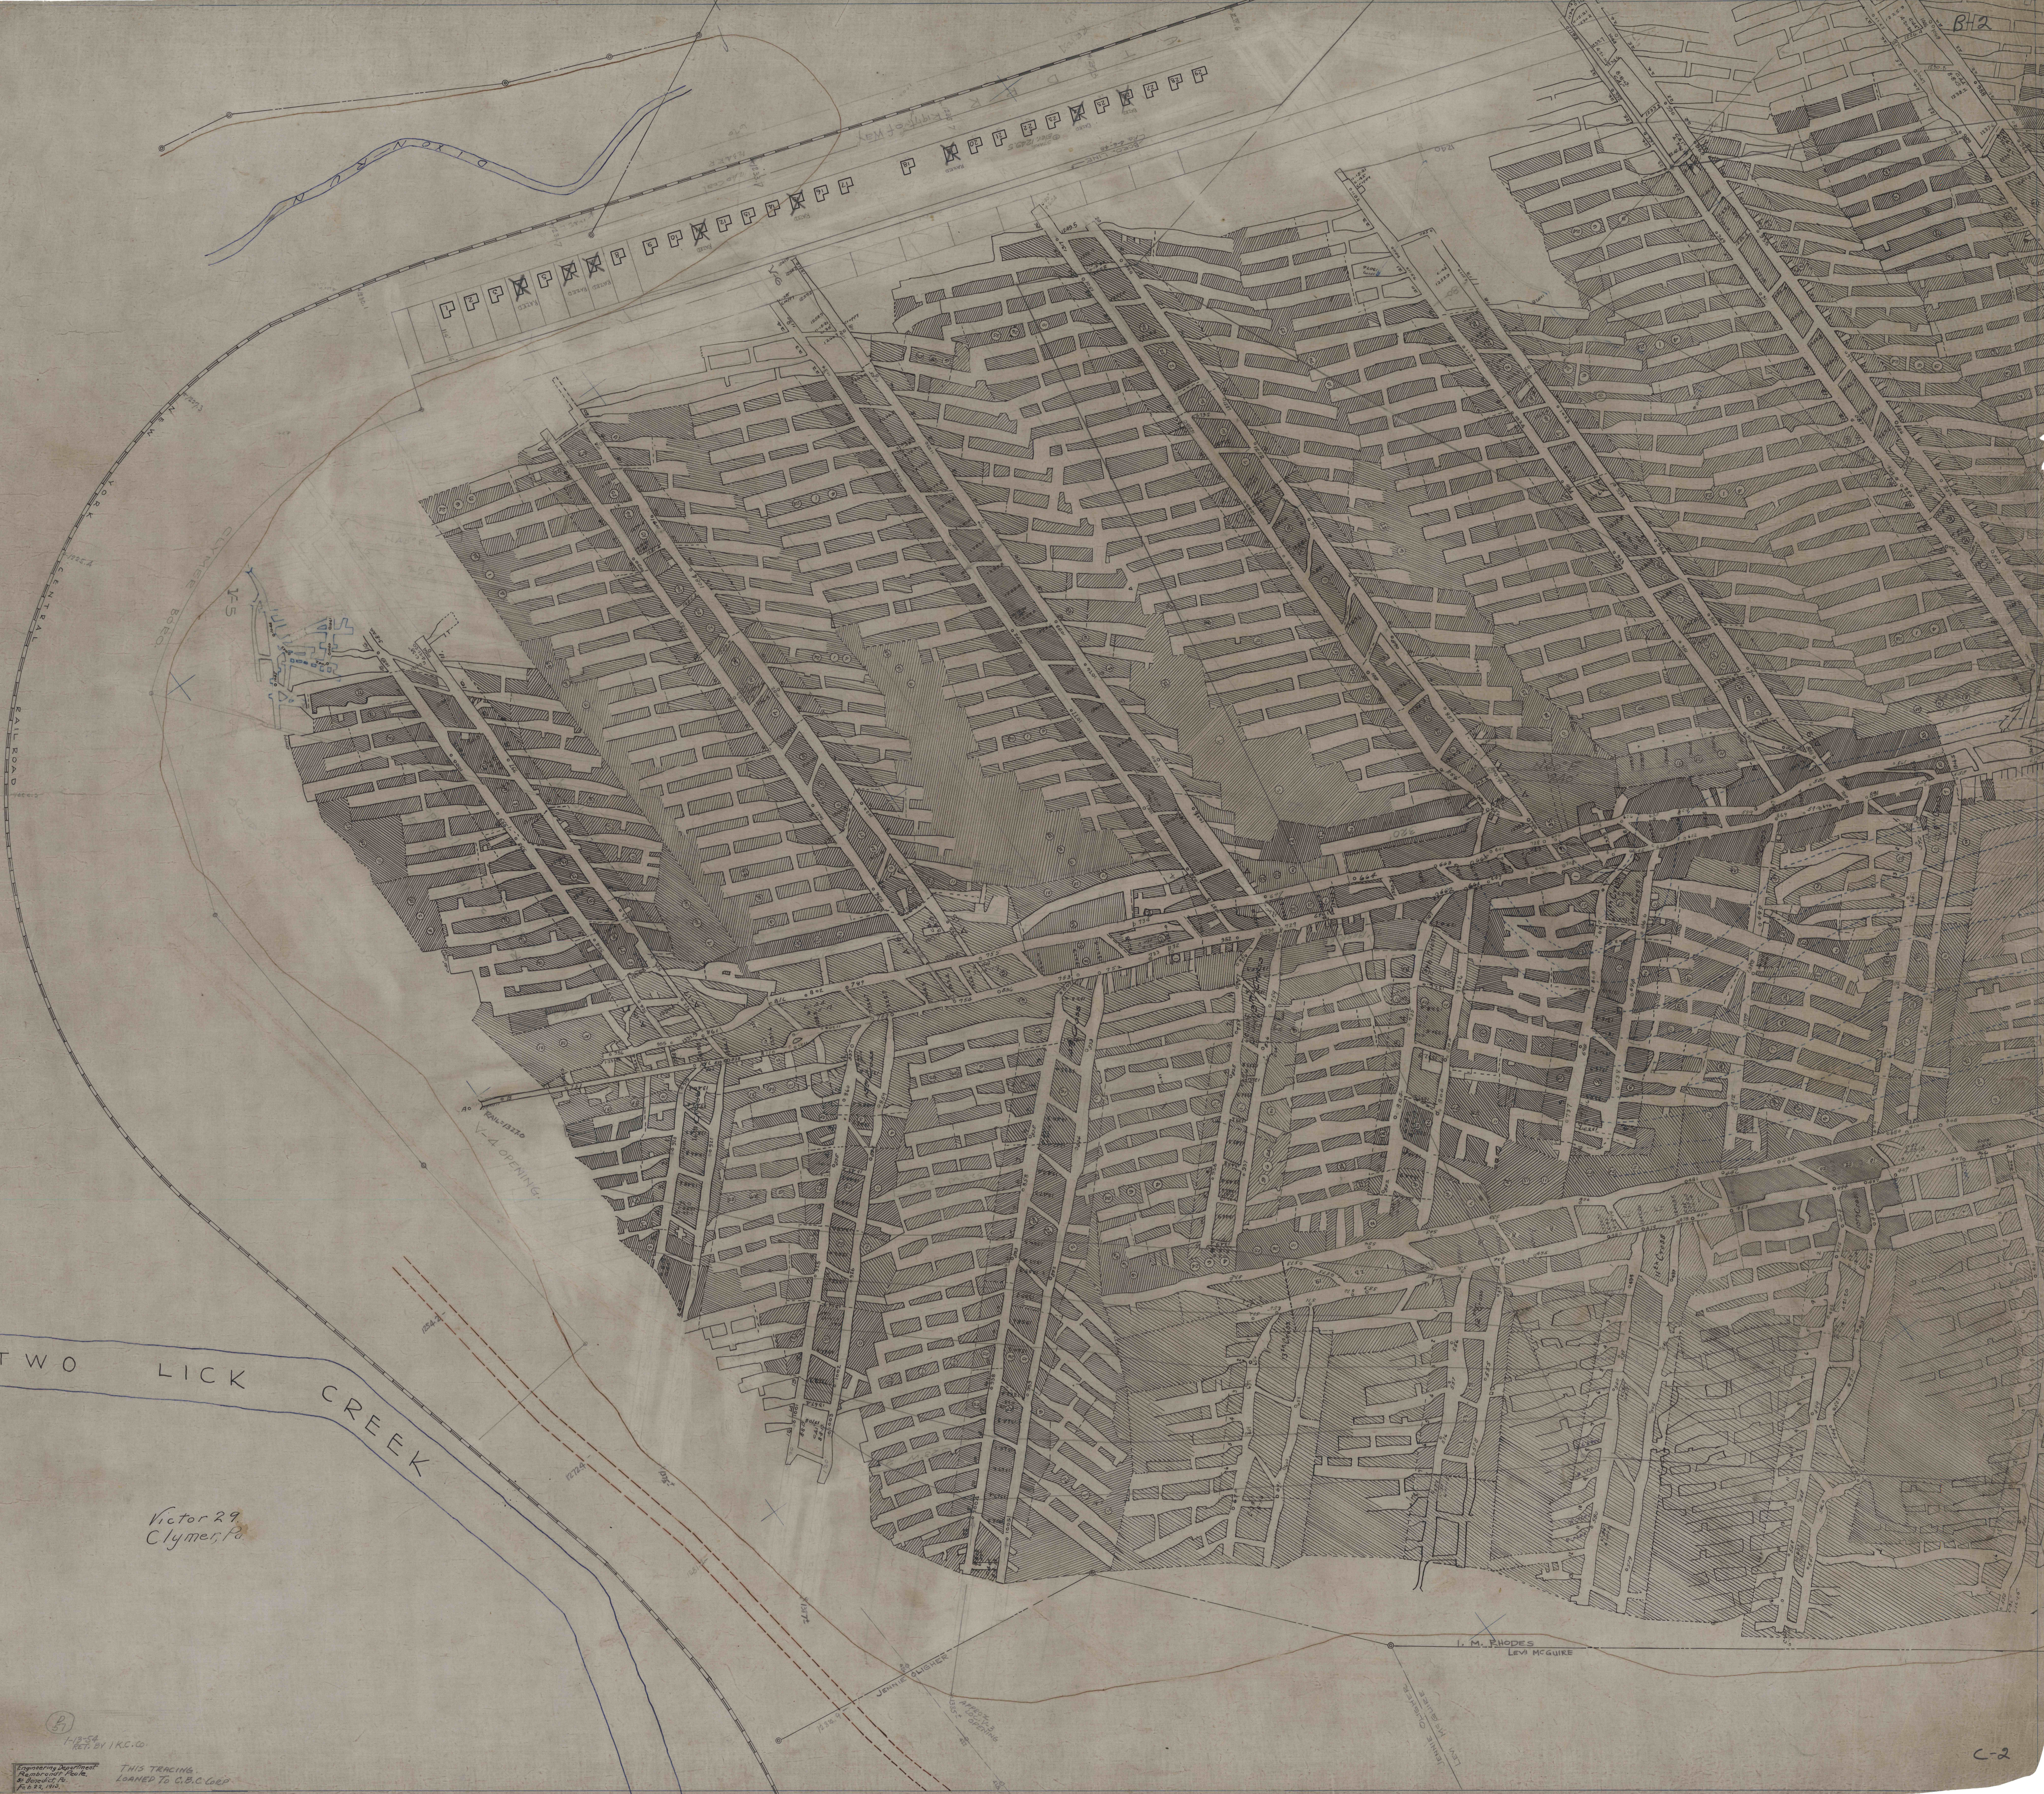

Victor 29
Clymer, Pa

E-Slow

C-1

(B)
1-18-24
REV. BY I.R.C. CO

Engineering Department
The Pennsylvania Power
& Light Co.
P.O. Box 100
Pittsburgh, Pa.
Feb. 22, 1924

THIS TRACING
LOANED TO C.B.C. CO. P.

C-2