


B-4

S 25° 35' E

BARRIER PILLAR

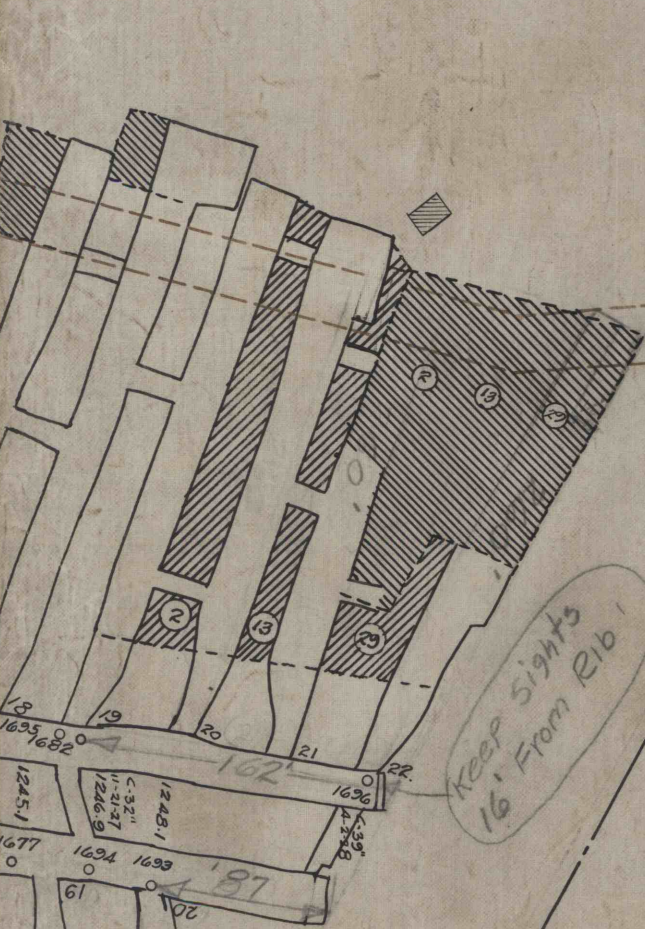

4-2

THIS DRAWING LOANED TO C. B. CLARKE BY R. C. MCG.

B-3

C-3