



15

 

8

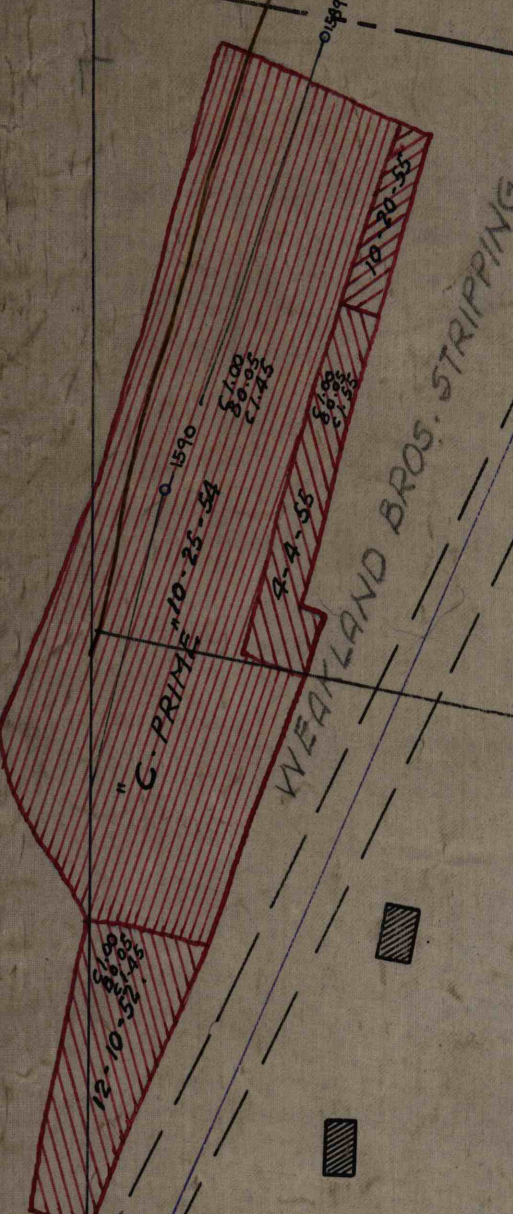