OLD HOME MAJOR

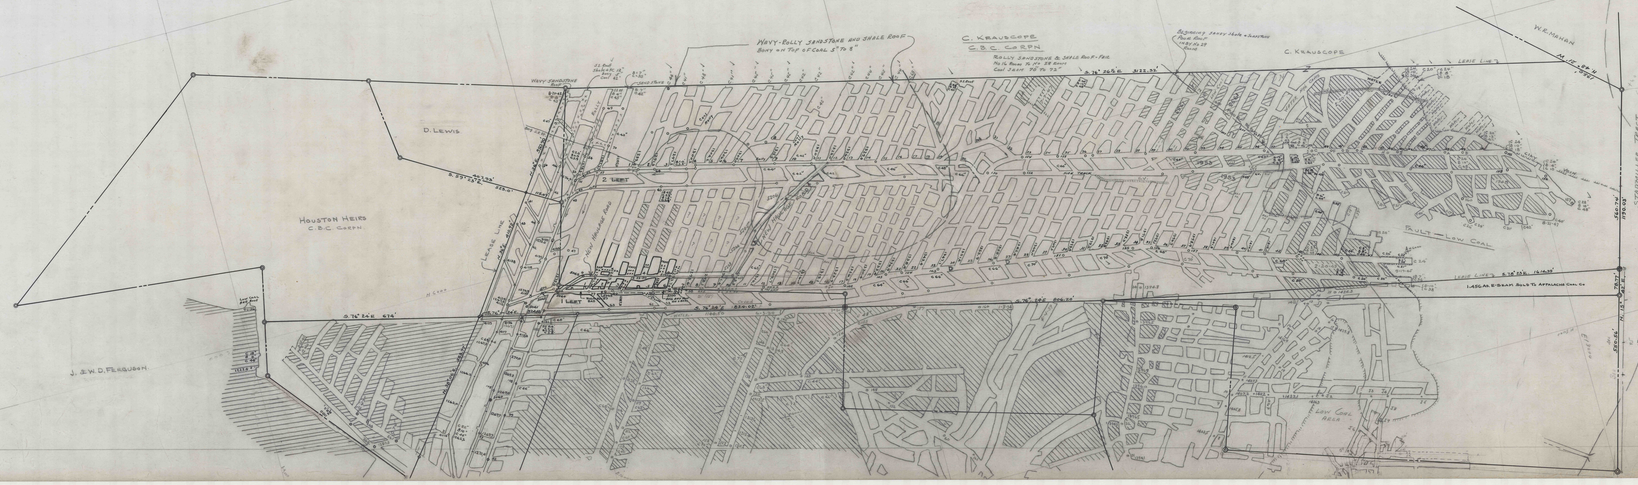

