


DISCLAIMER: This map is provided as a courtesy to the Pennsylvania Bureau of Deep Mine Safety by American Premier Underwriters, Inc. (fka The Penn Central Corporation) and its subsidiary United Railroad Corp., which own or owned, but do not operate, the coal assets depicted hereon.

American Premier Underwriters, Inc. and United Railroad Corp. disclaim any representation or duty to any person as to the accuracy or completeness of this map for any reason undertaken by an independent duty to verify its accuracy and completeness. American Premier Underwriters, Inc., United Railroad Corp. and their respective affiliates, shareholders, directors, officers and employees, harmless from damage or liability arising from its use.

DANIEL GRAY
W. D. BIGLER & CO. - COAL

JOS. LEHMIRE
GEO. H. ASHMAN - COAL

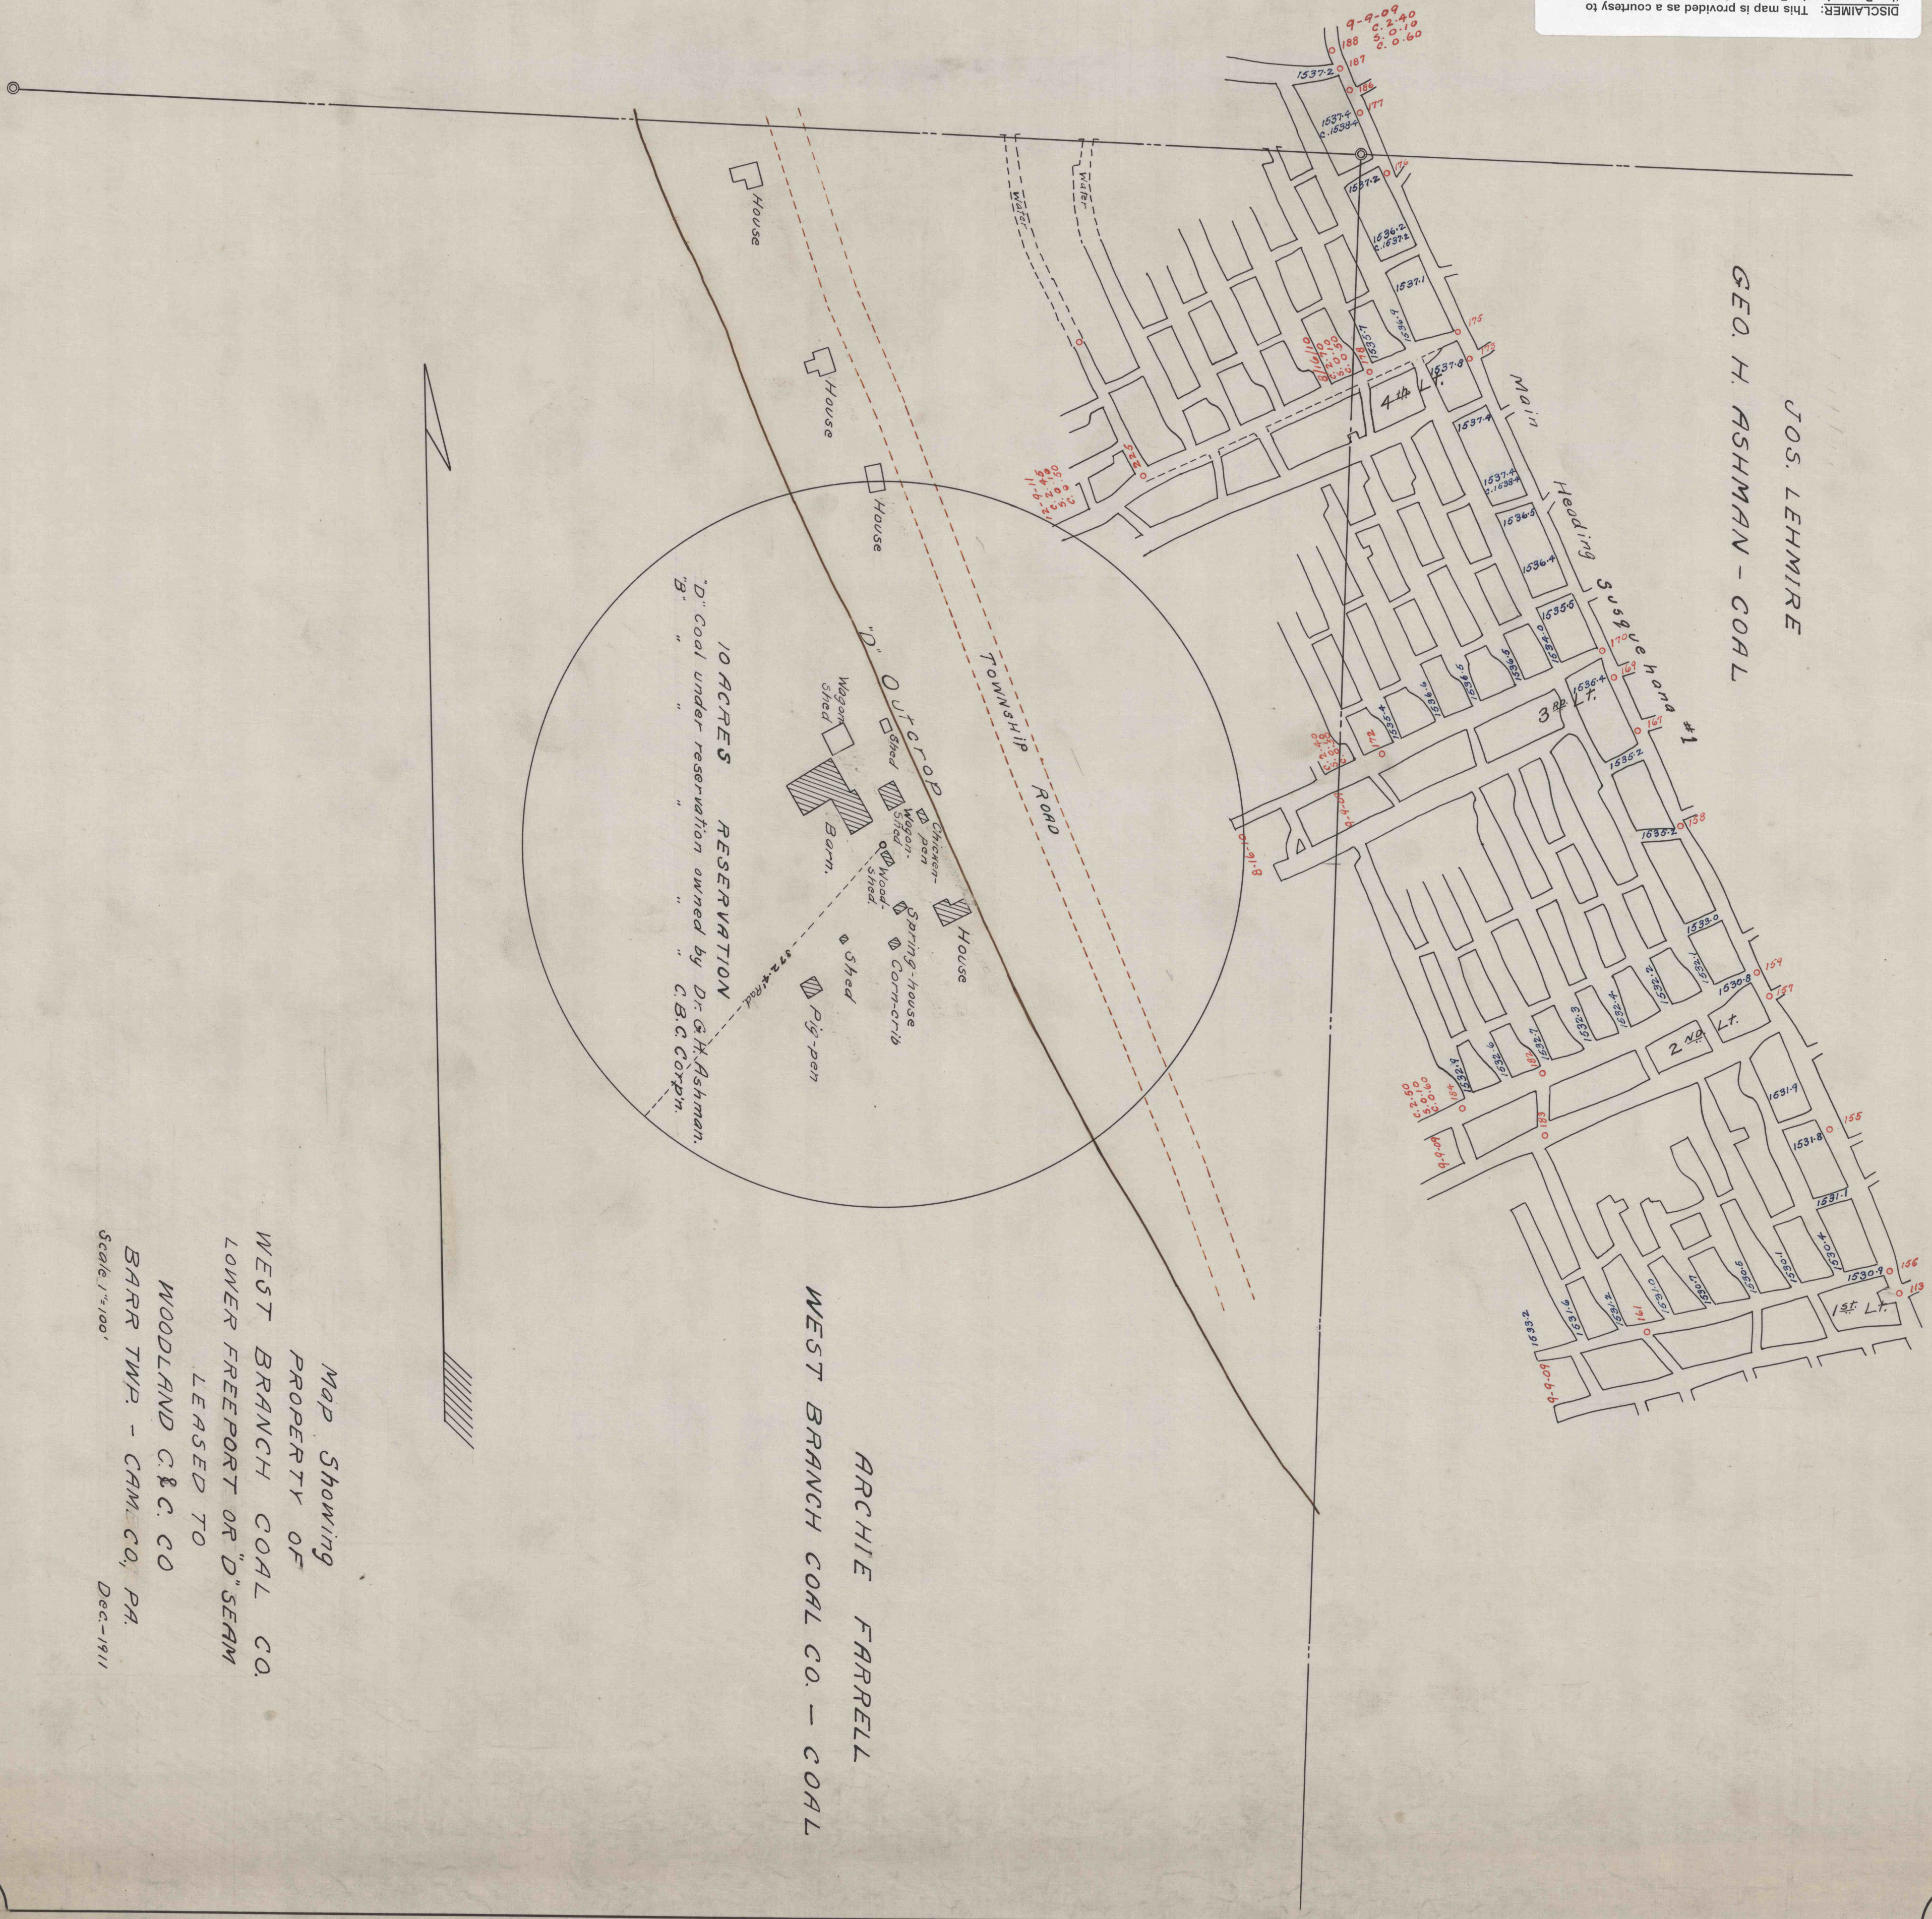

Map Showing
PROPERTY OF
WEST BRANCH COAL CO.
LOWER FREEPORT OR "D" SEAM
LEASED TO
WOODLAND C & C. CO
BARR TWP. - CAM. CO. PA.
Scale 1" = 100'
Dec-1911

ARCHIE FARRELL
WEST BRANCH COAL CO. - COAL