

HUNTER TRACT

CEMETERY


# MAP OF ROYAL SLOPE

OPERATED BY THE ROYAL COAL MINING CO

MUNSON, CLEARFIELD CO., PA.  
Scale: 1 INCH = 100 FT.  
Wernsdorff & Dunkle, Mining Engineers,  
Phillipsburg, Pa.

J. CALVIN PARDEE

LENA HODKINS

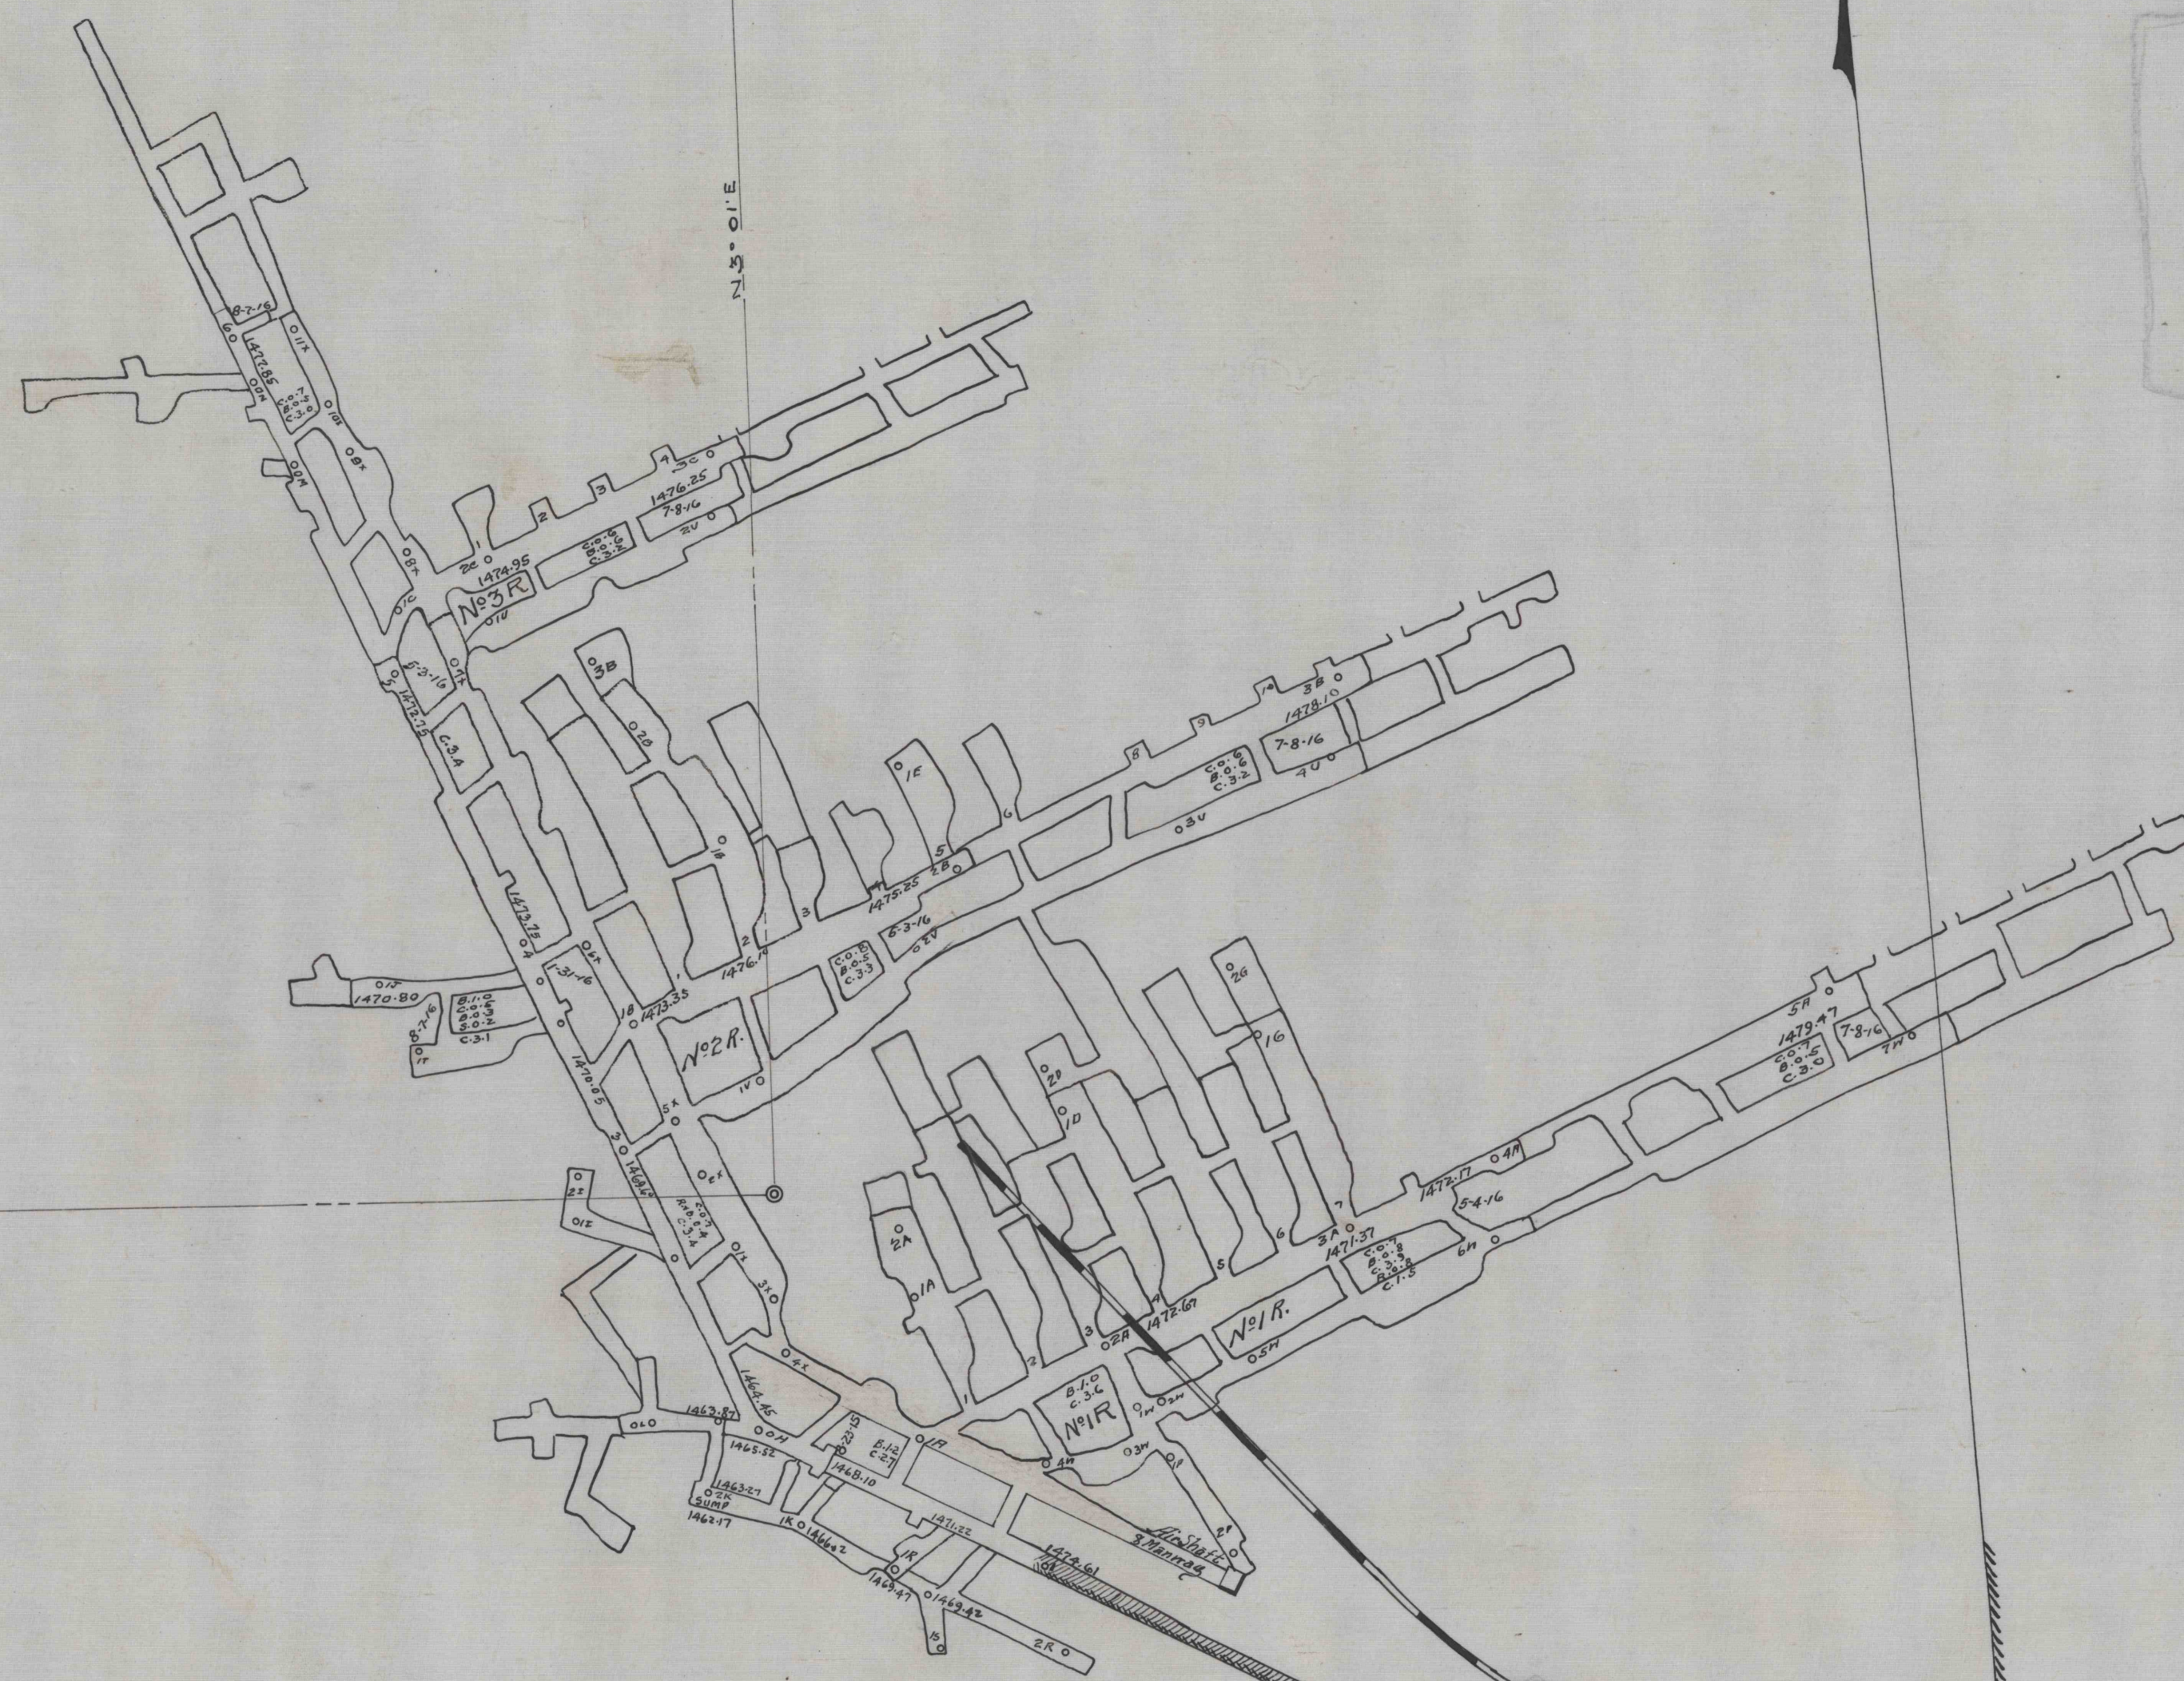

O. L. SCHOONOVER ESTATE

CEMETERY

MORRISDALE COAL CO