No. 7

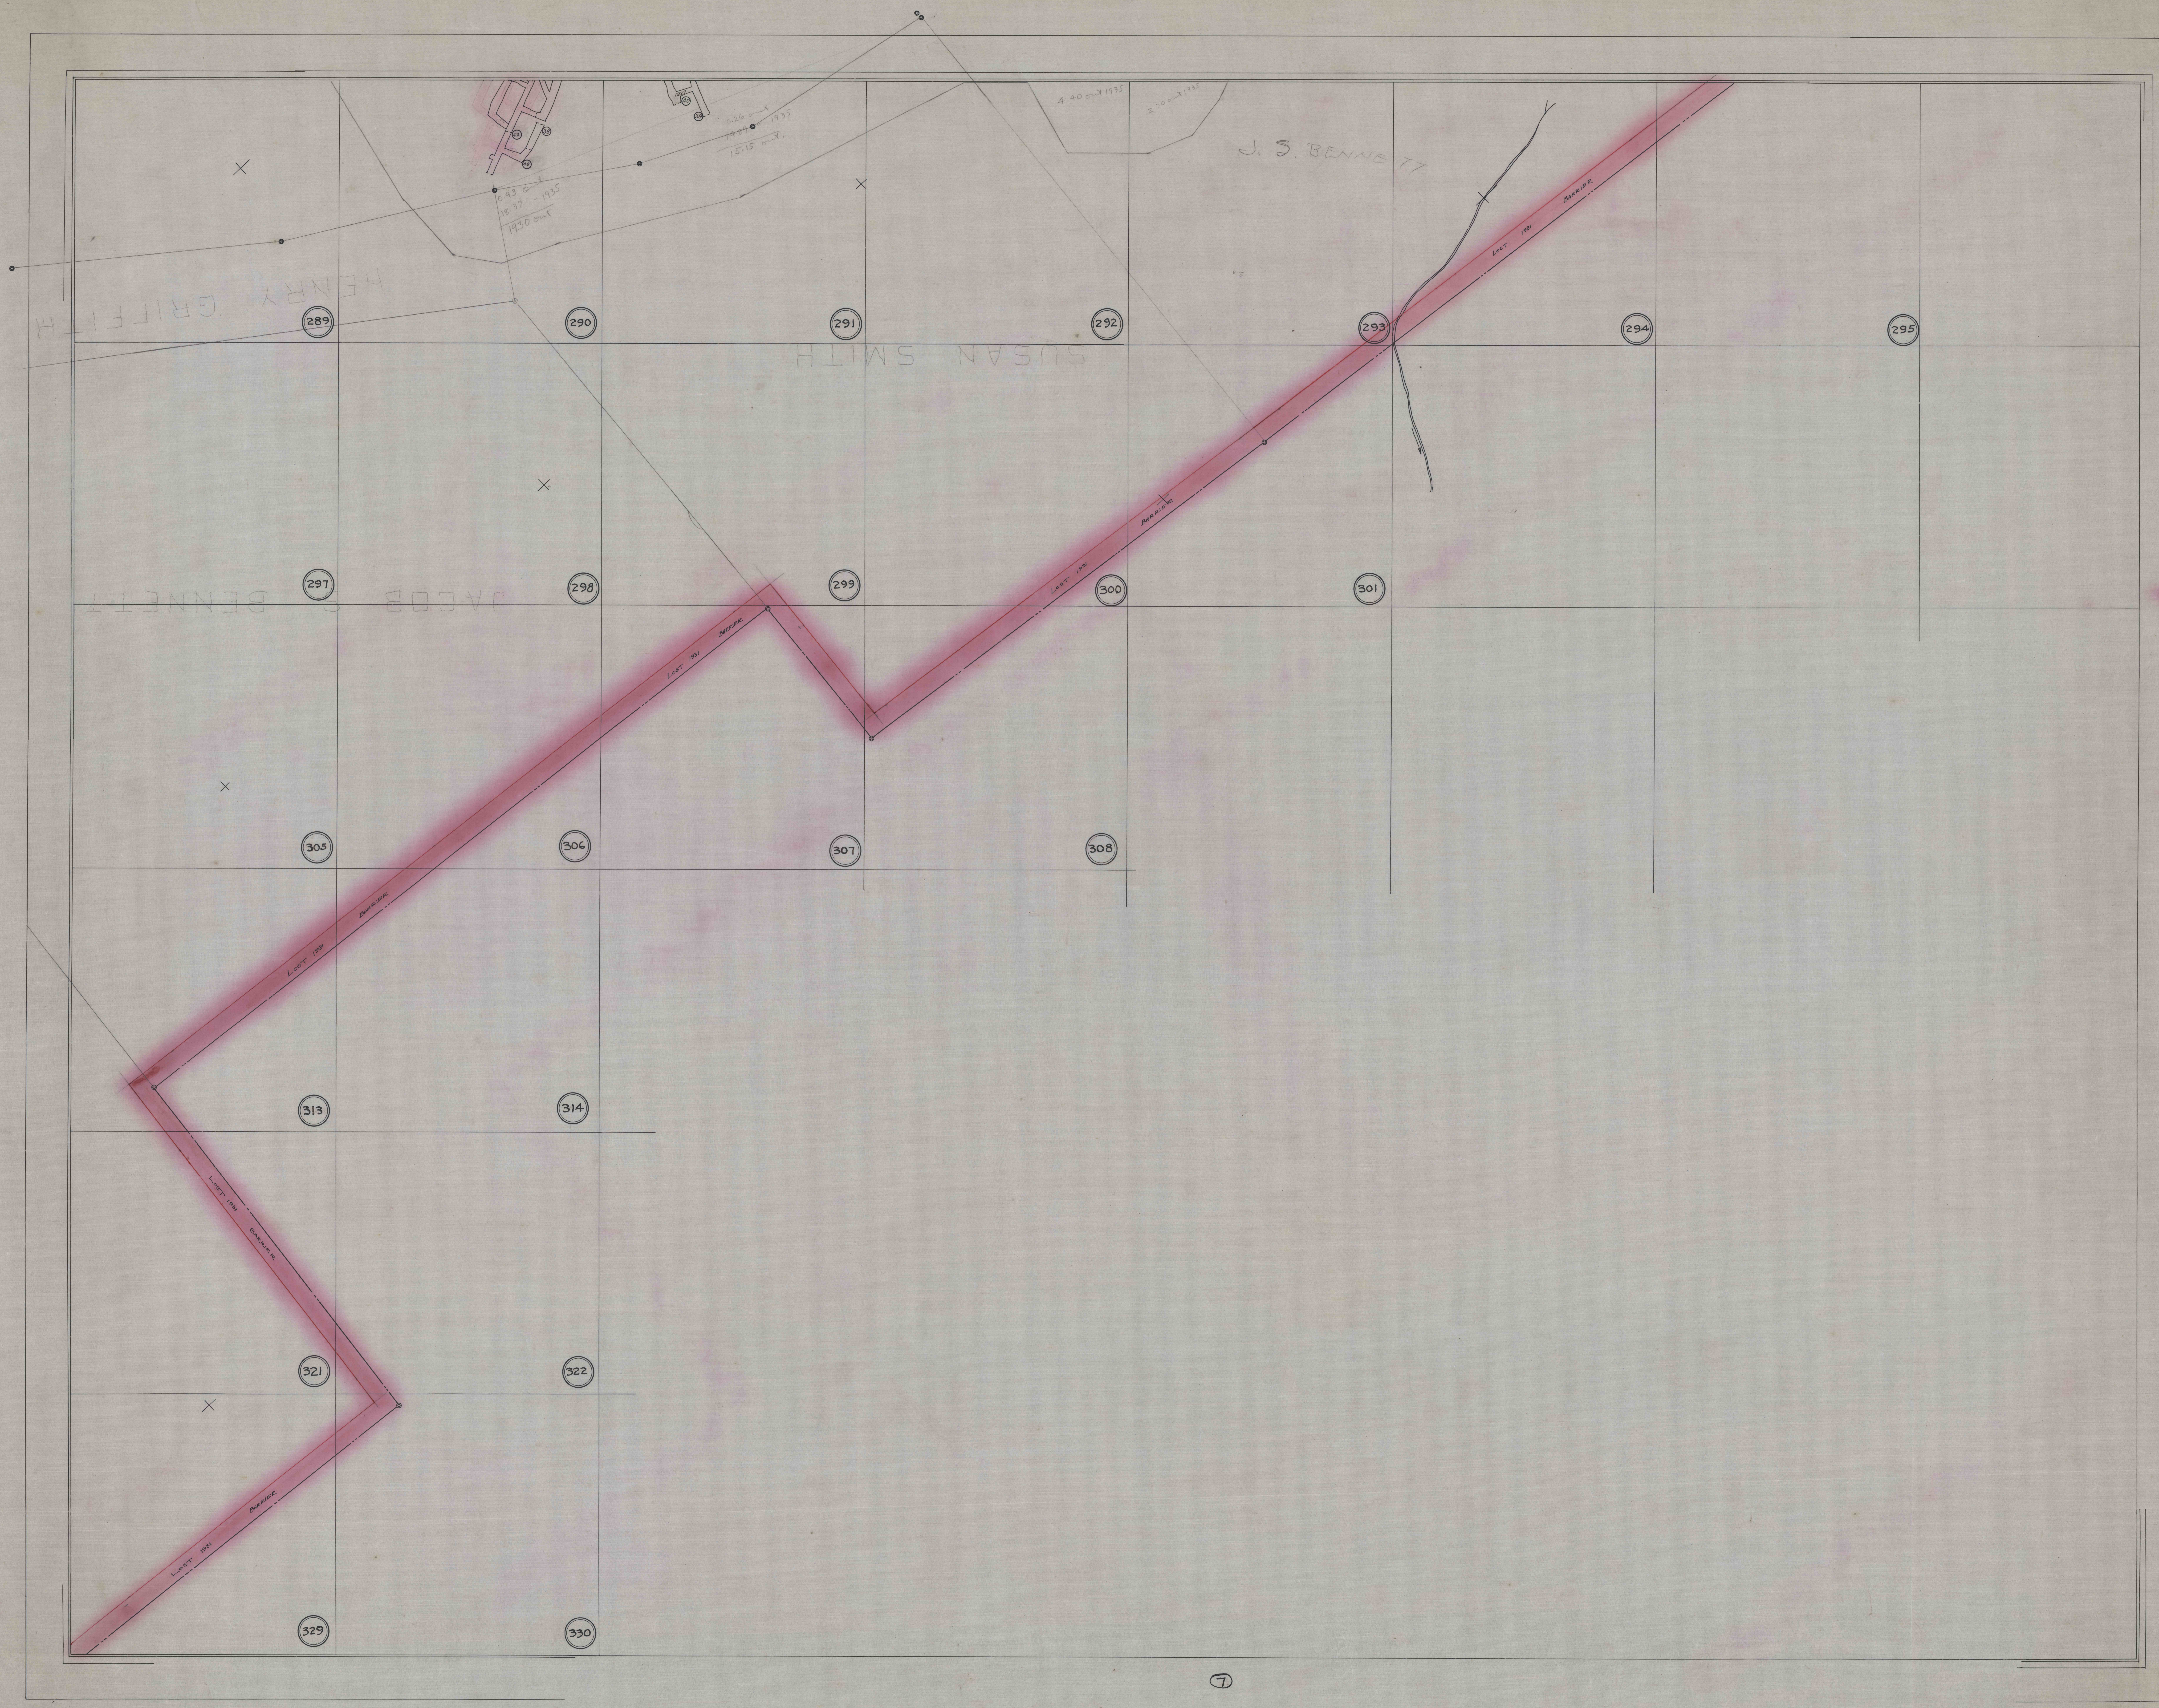

⑦

BOTTOM No. 7
WORKING TRACING

No. 7