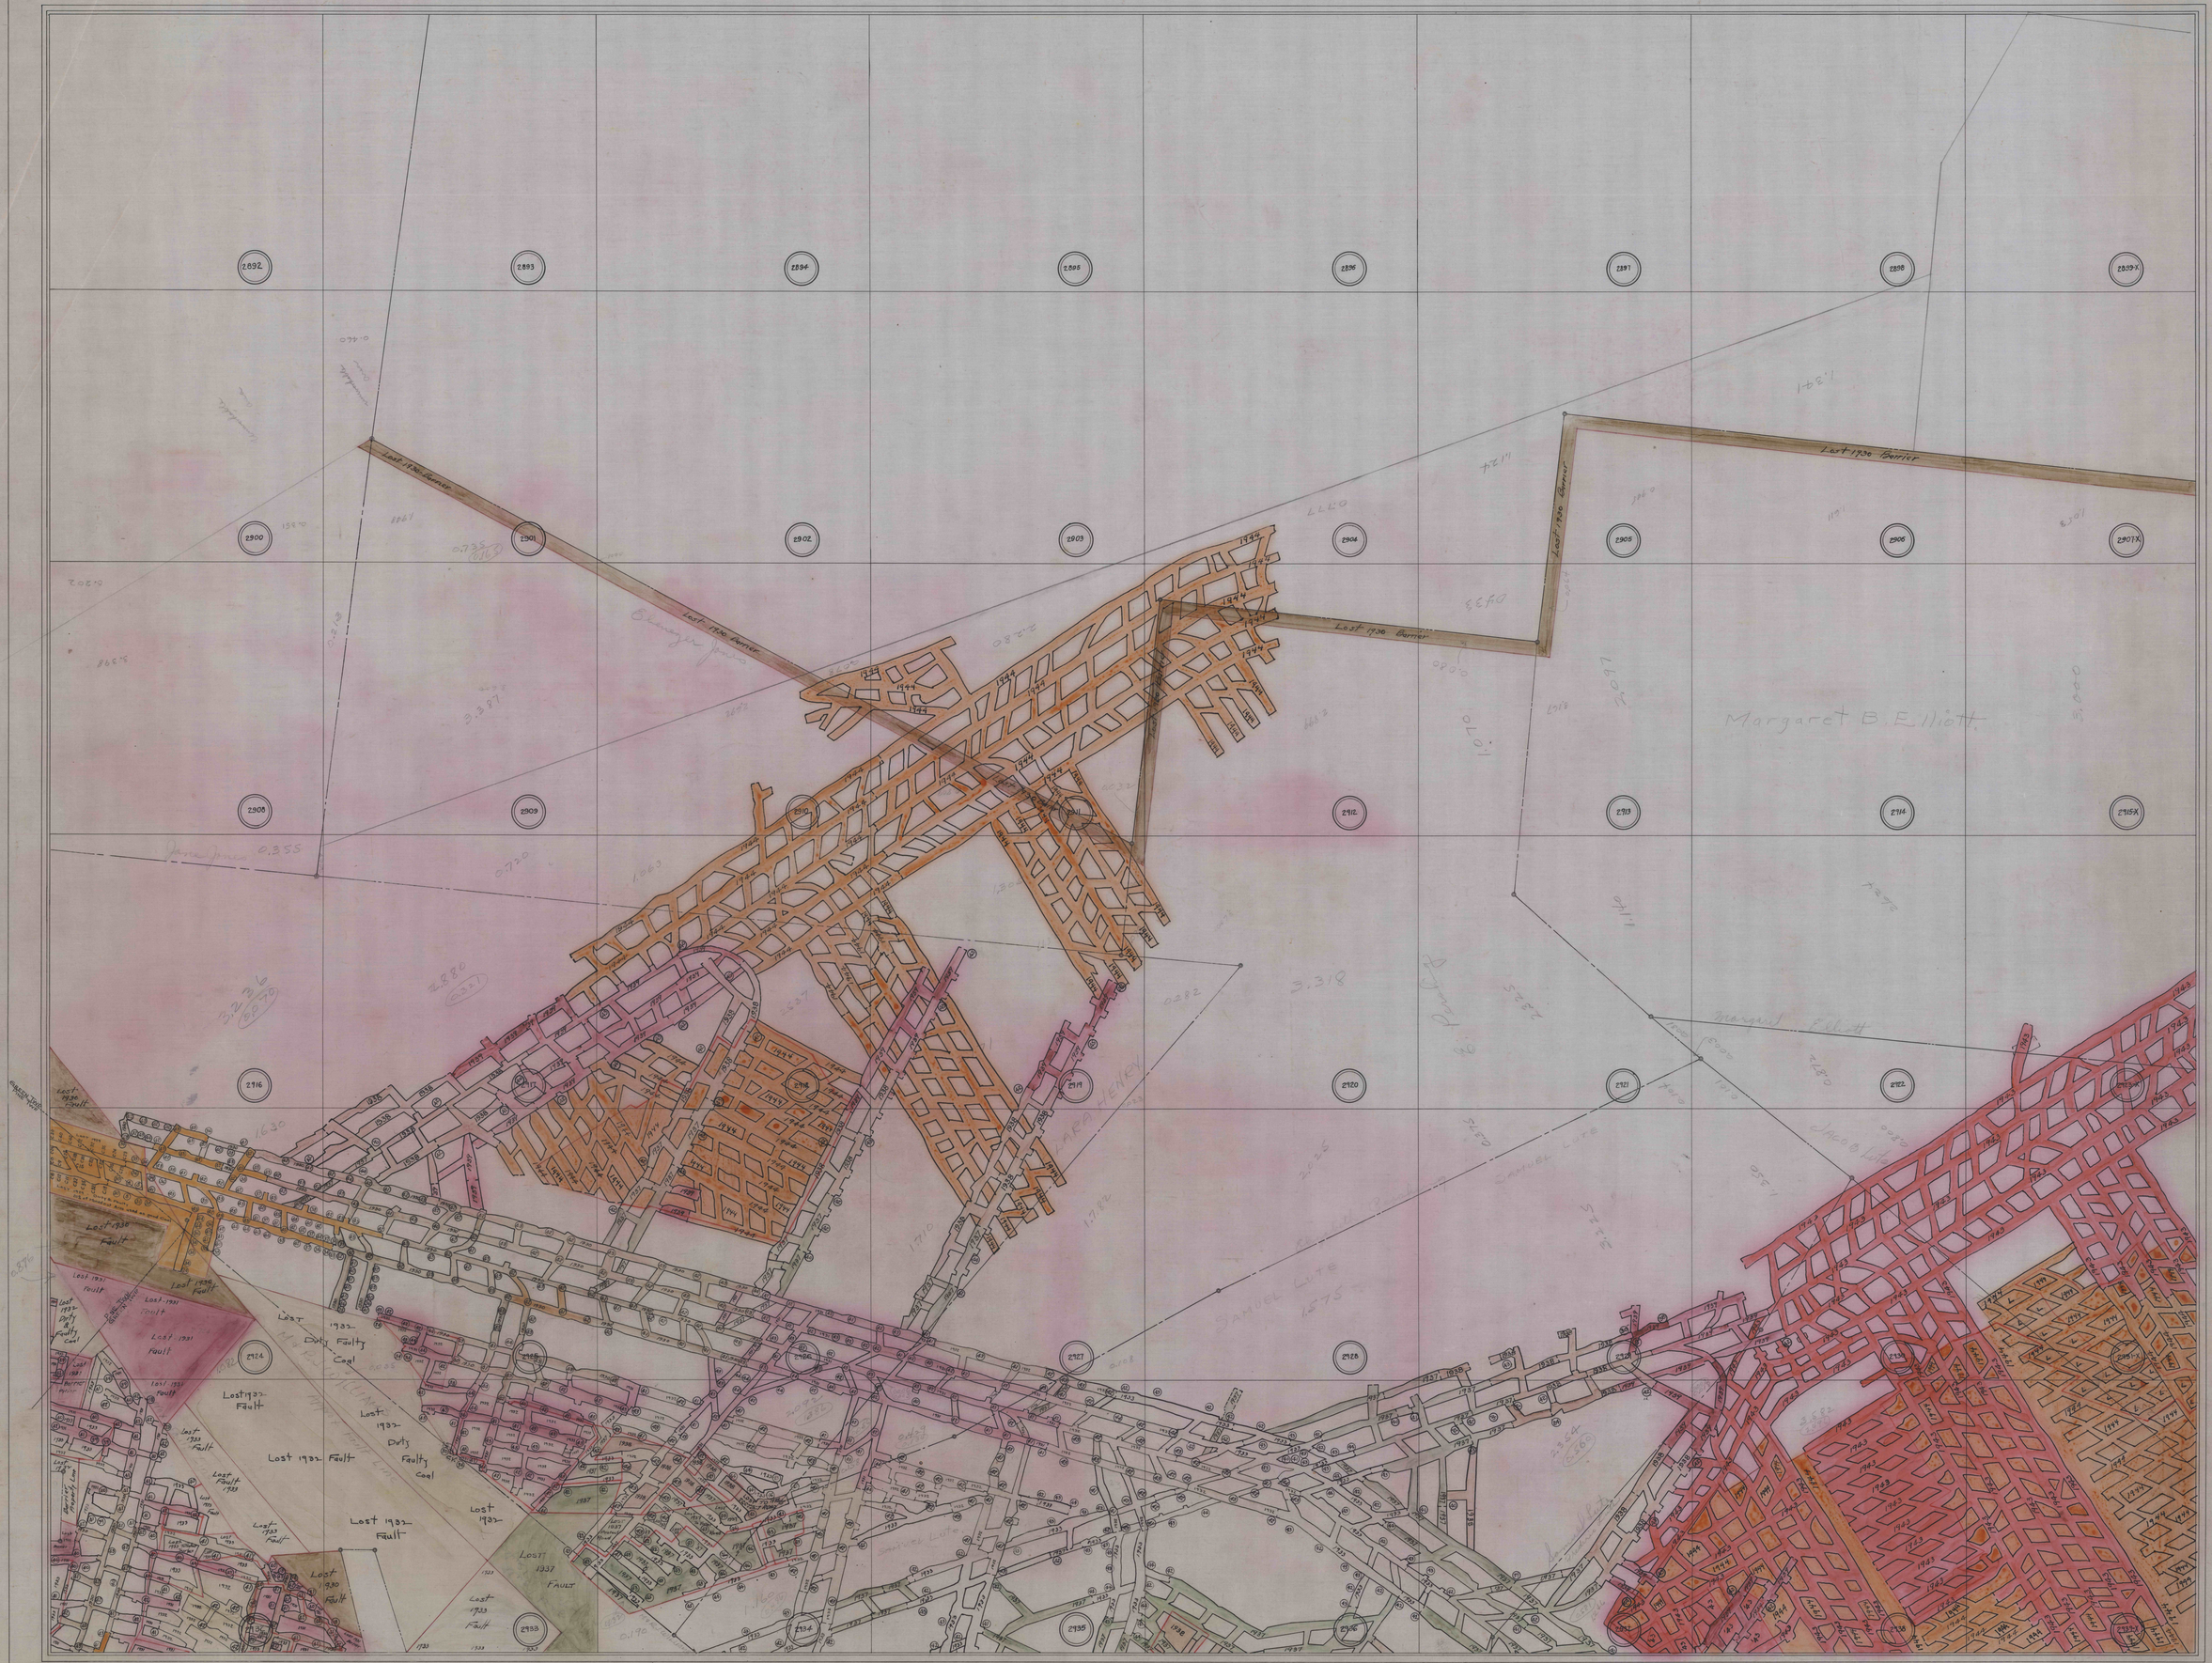
Lost 1930 Barrier
Lost 1930 Barrier
Lost 1930 Barrier
Lost 1930 Barrier
Margaret B. Elliott
Lost 1930 Fault
Lost 1931 Fault
Lost 1931 Coal
Lost 1931 Dirty Faulty Coal
Lost 1932 Fault
Lost 1932 Dirty Faulty Coal
Lost 1933 Fault
Lost 1937 Fault
Lost 1933 Fault
Lost 1930 Fault
Lost 1933 Fault
Lost 1933 Fault
Lost 1933