


No. 4

No. 4

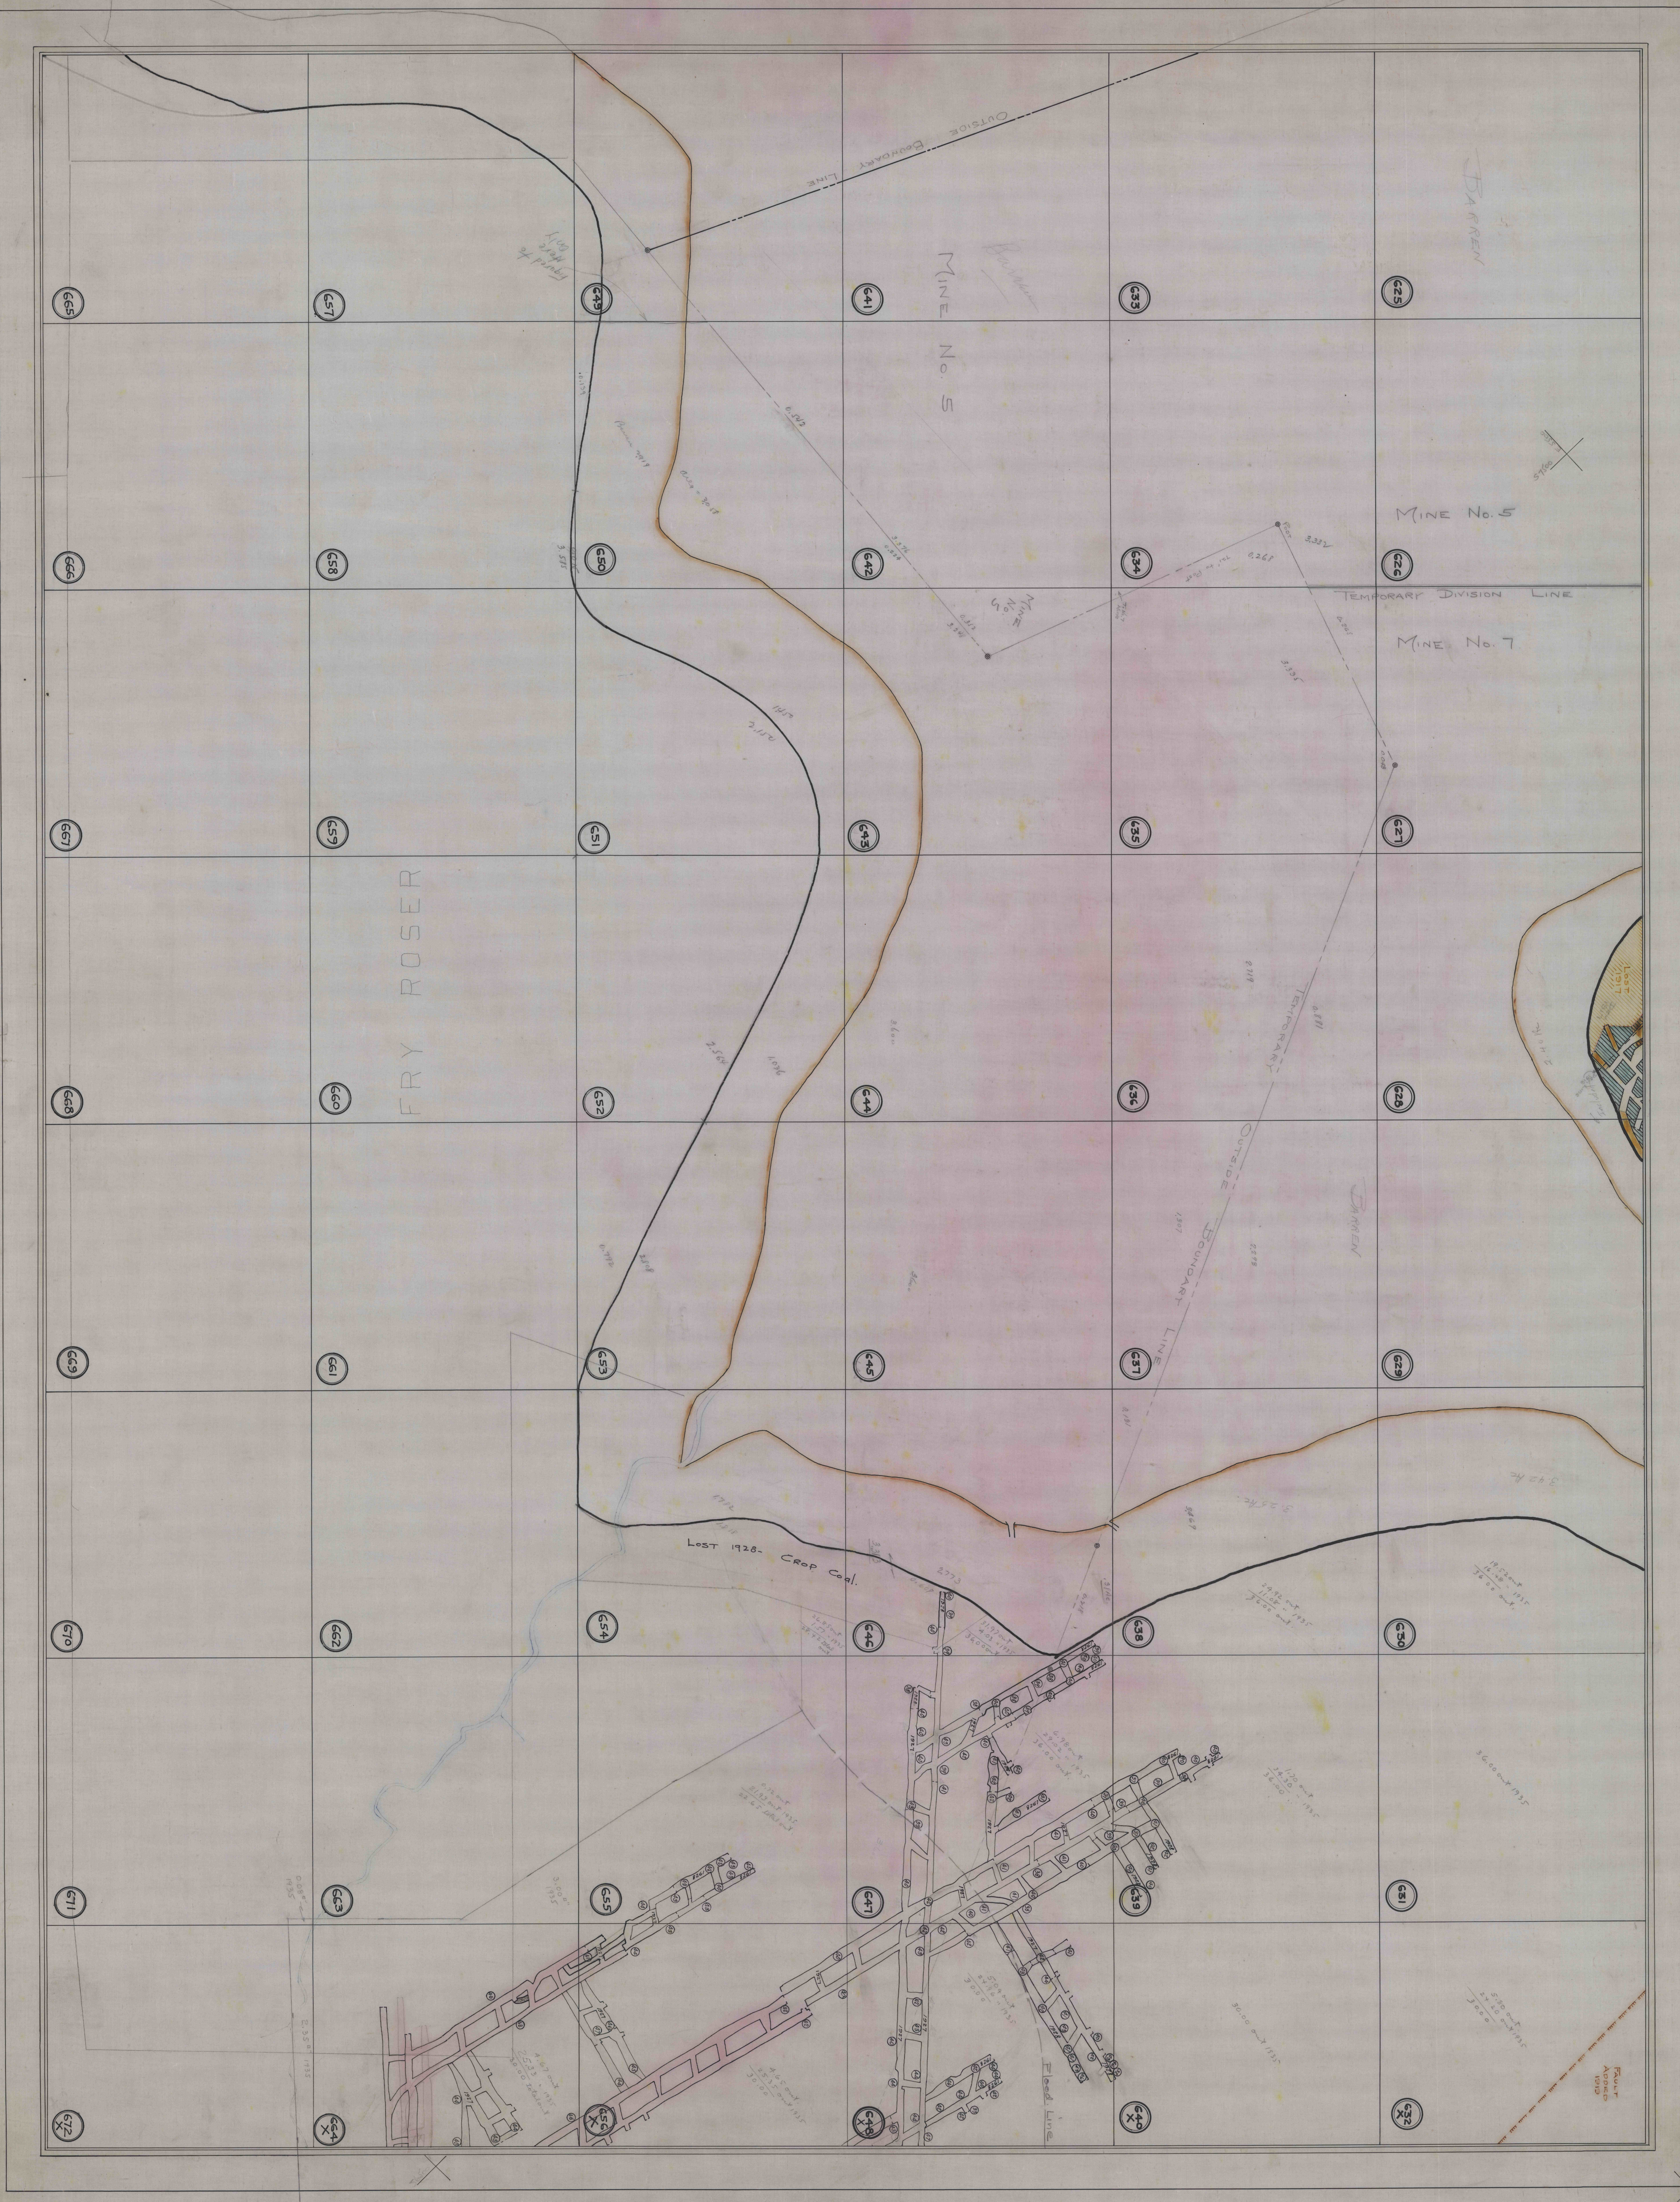

Barton No. 1 Workings

No. 4

No. 4