


TIMBLE-80

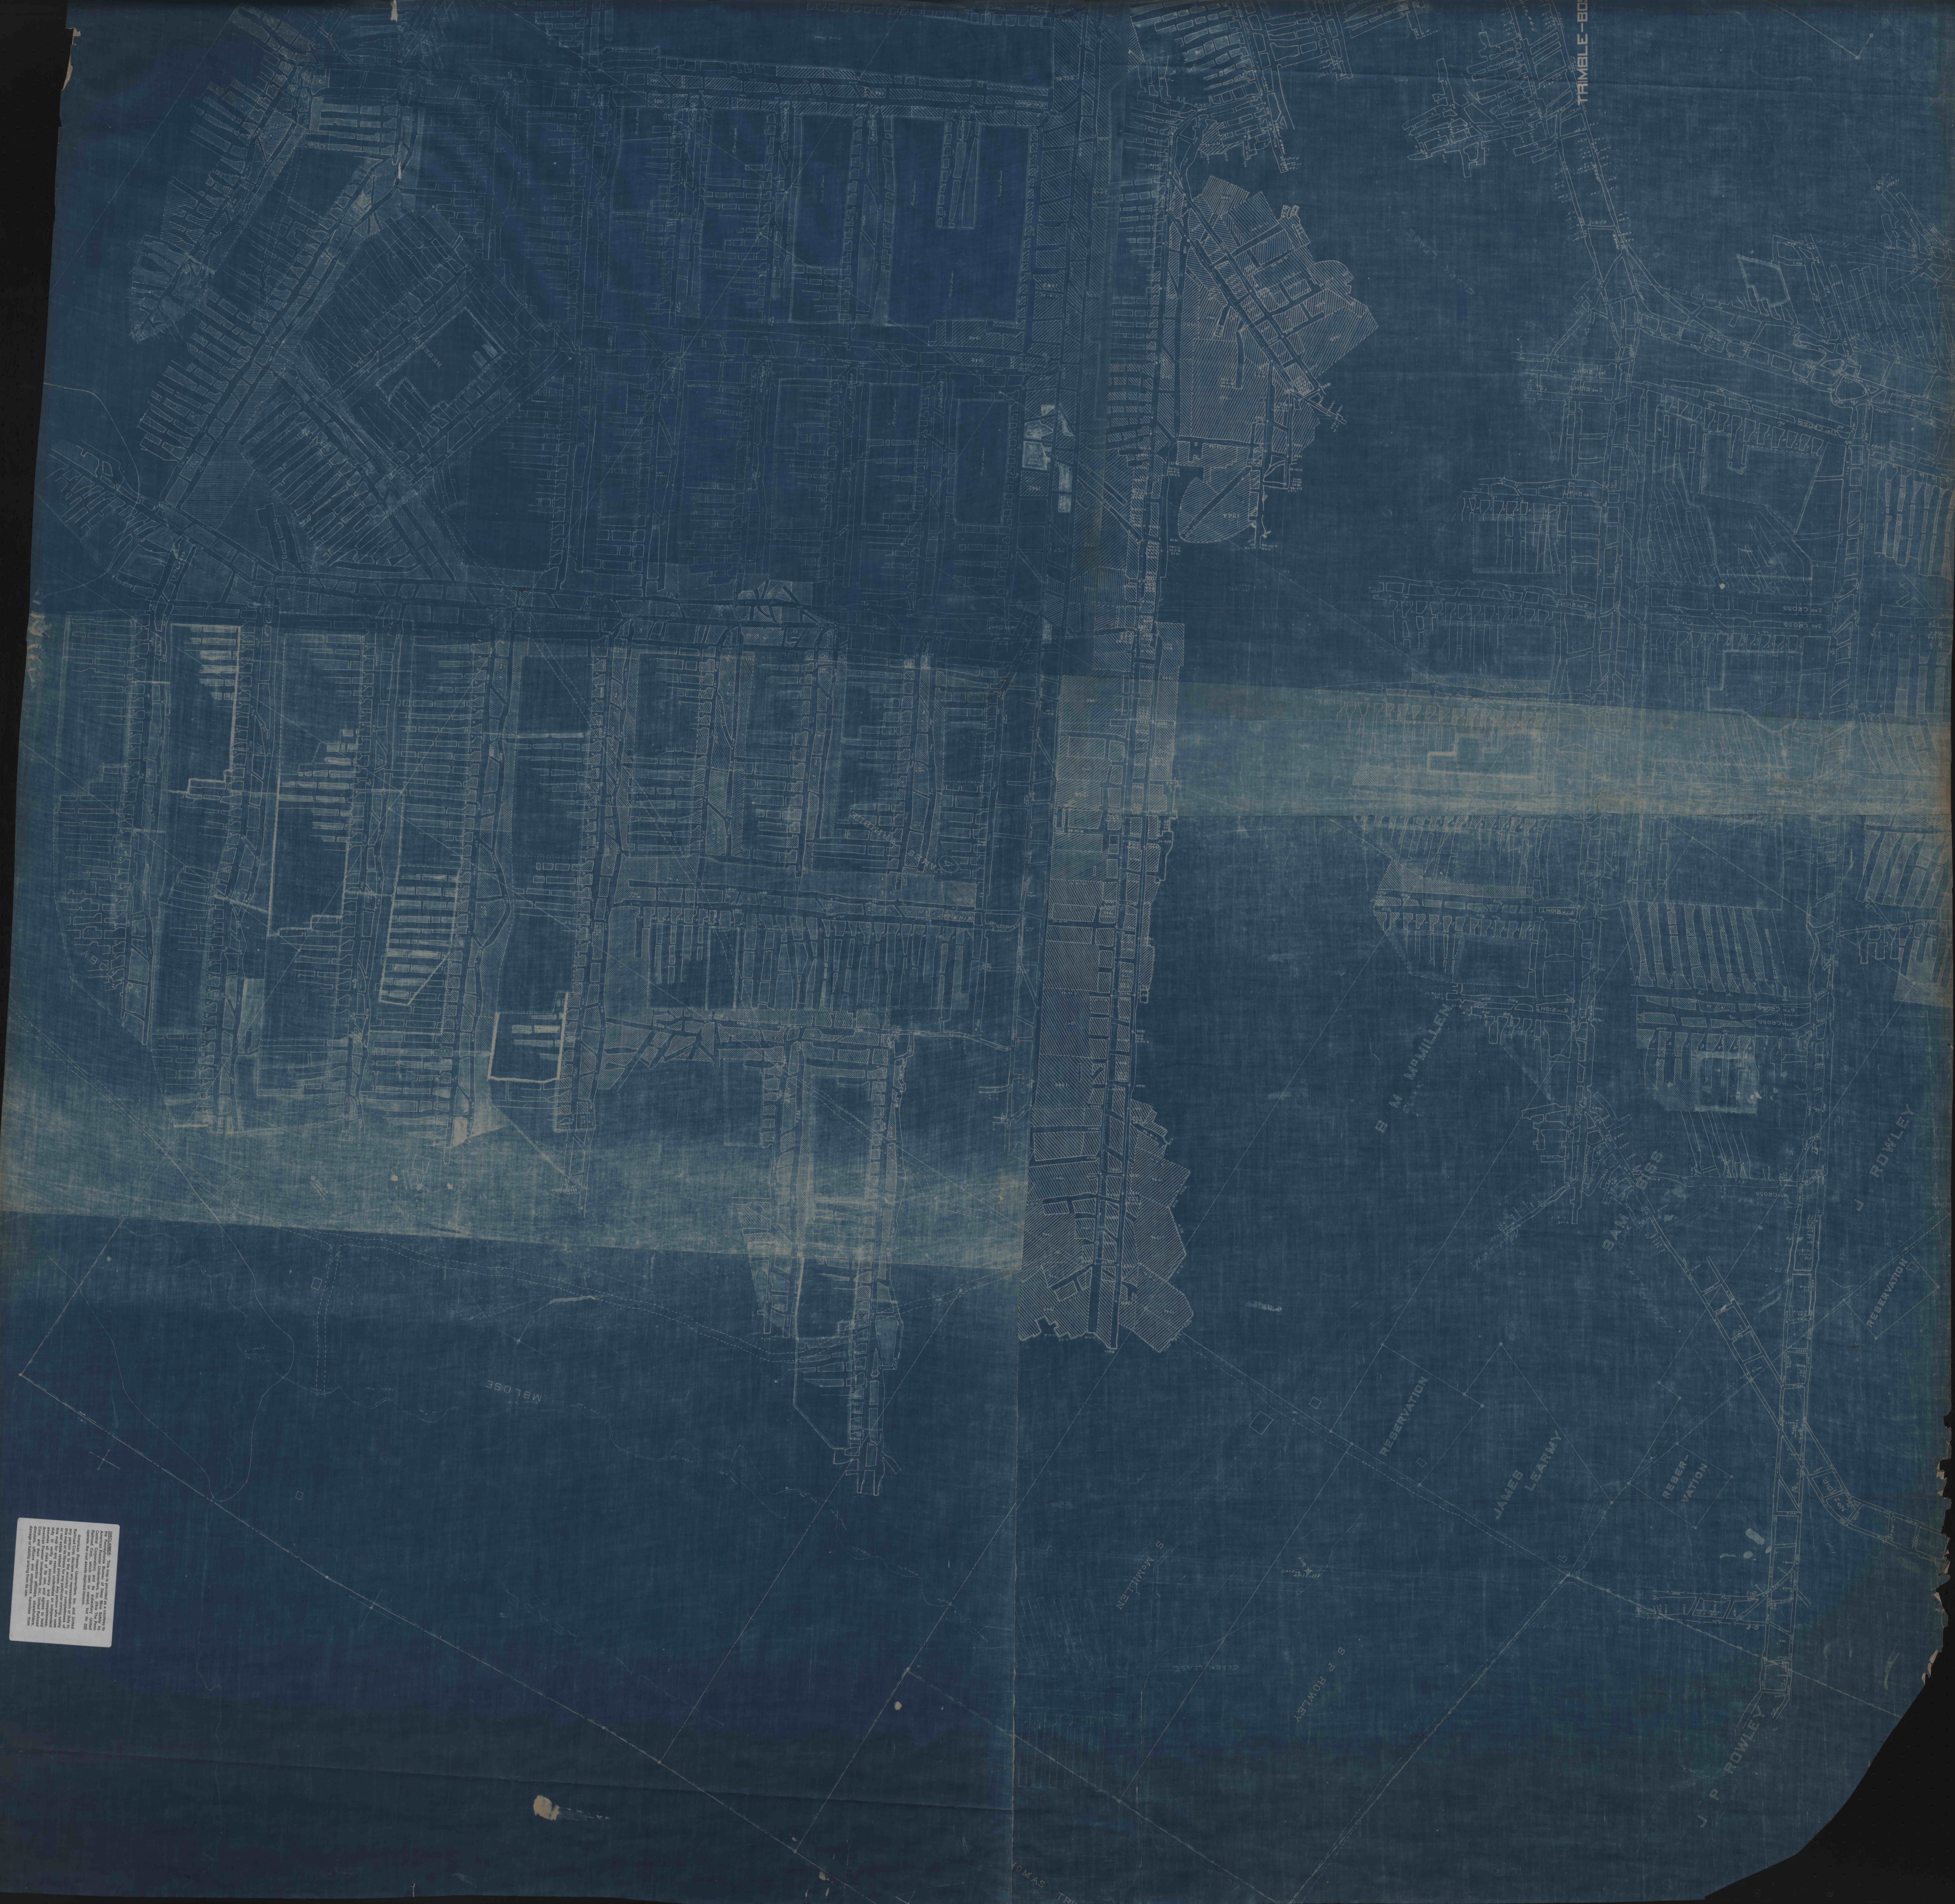





S. F. ROWLEY

RESERVATION

JAMES LEARMY

RESERVATION

J. P. ROWLEY

J. ROWLEY

RESERVATION


