



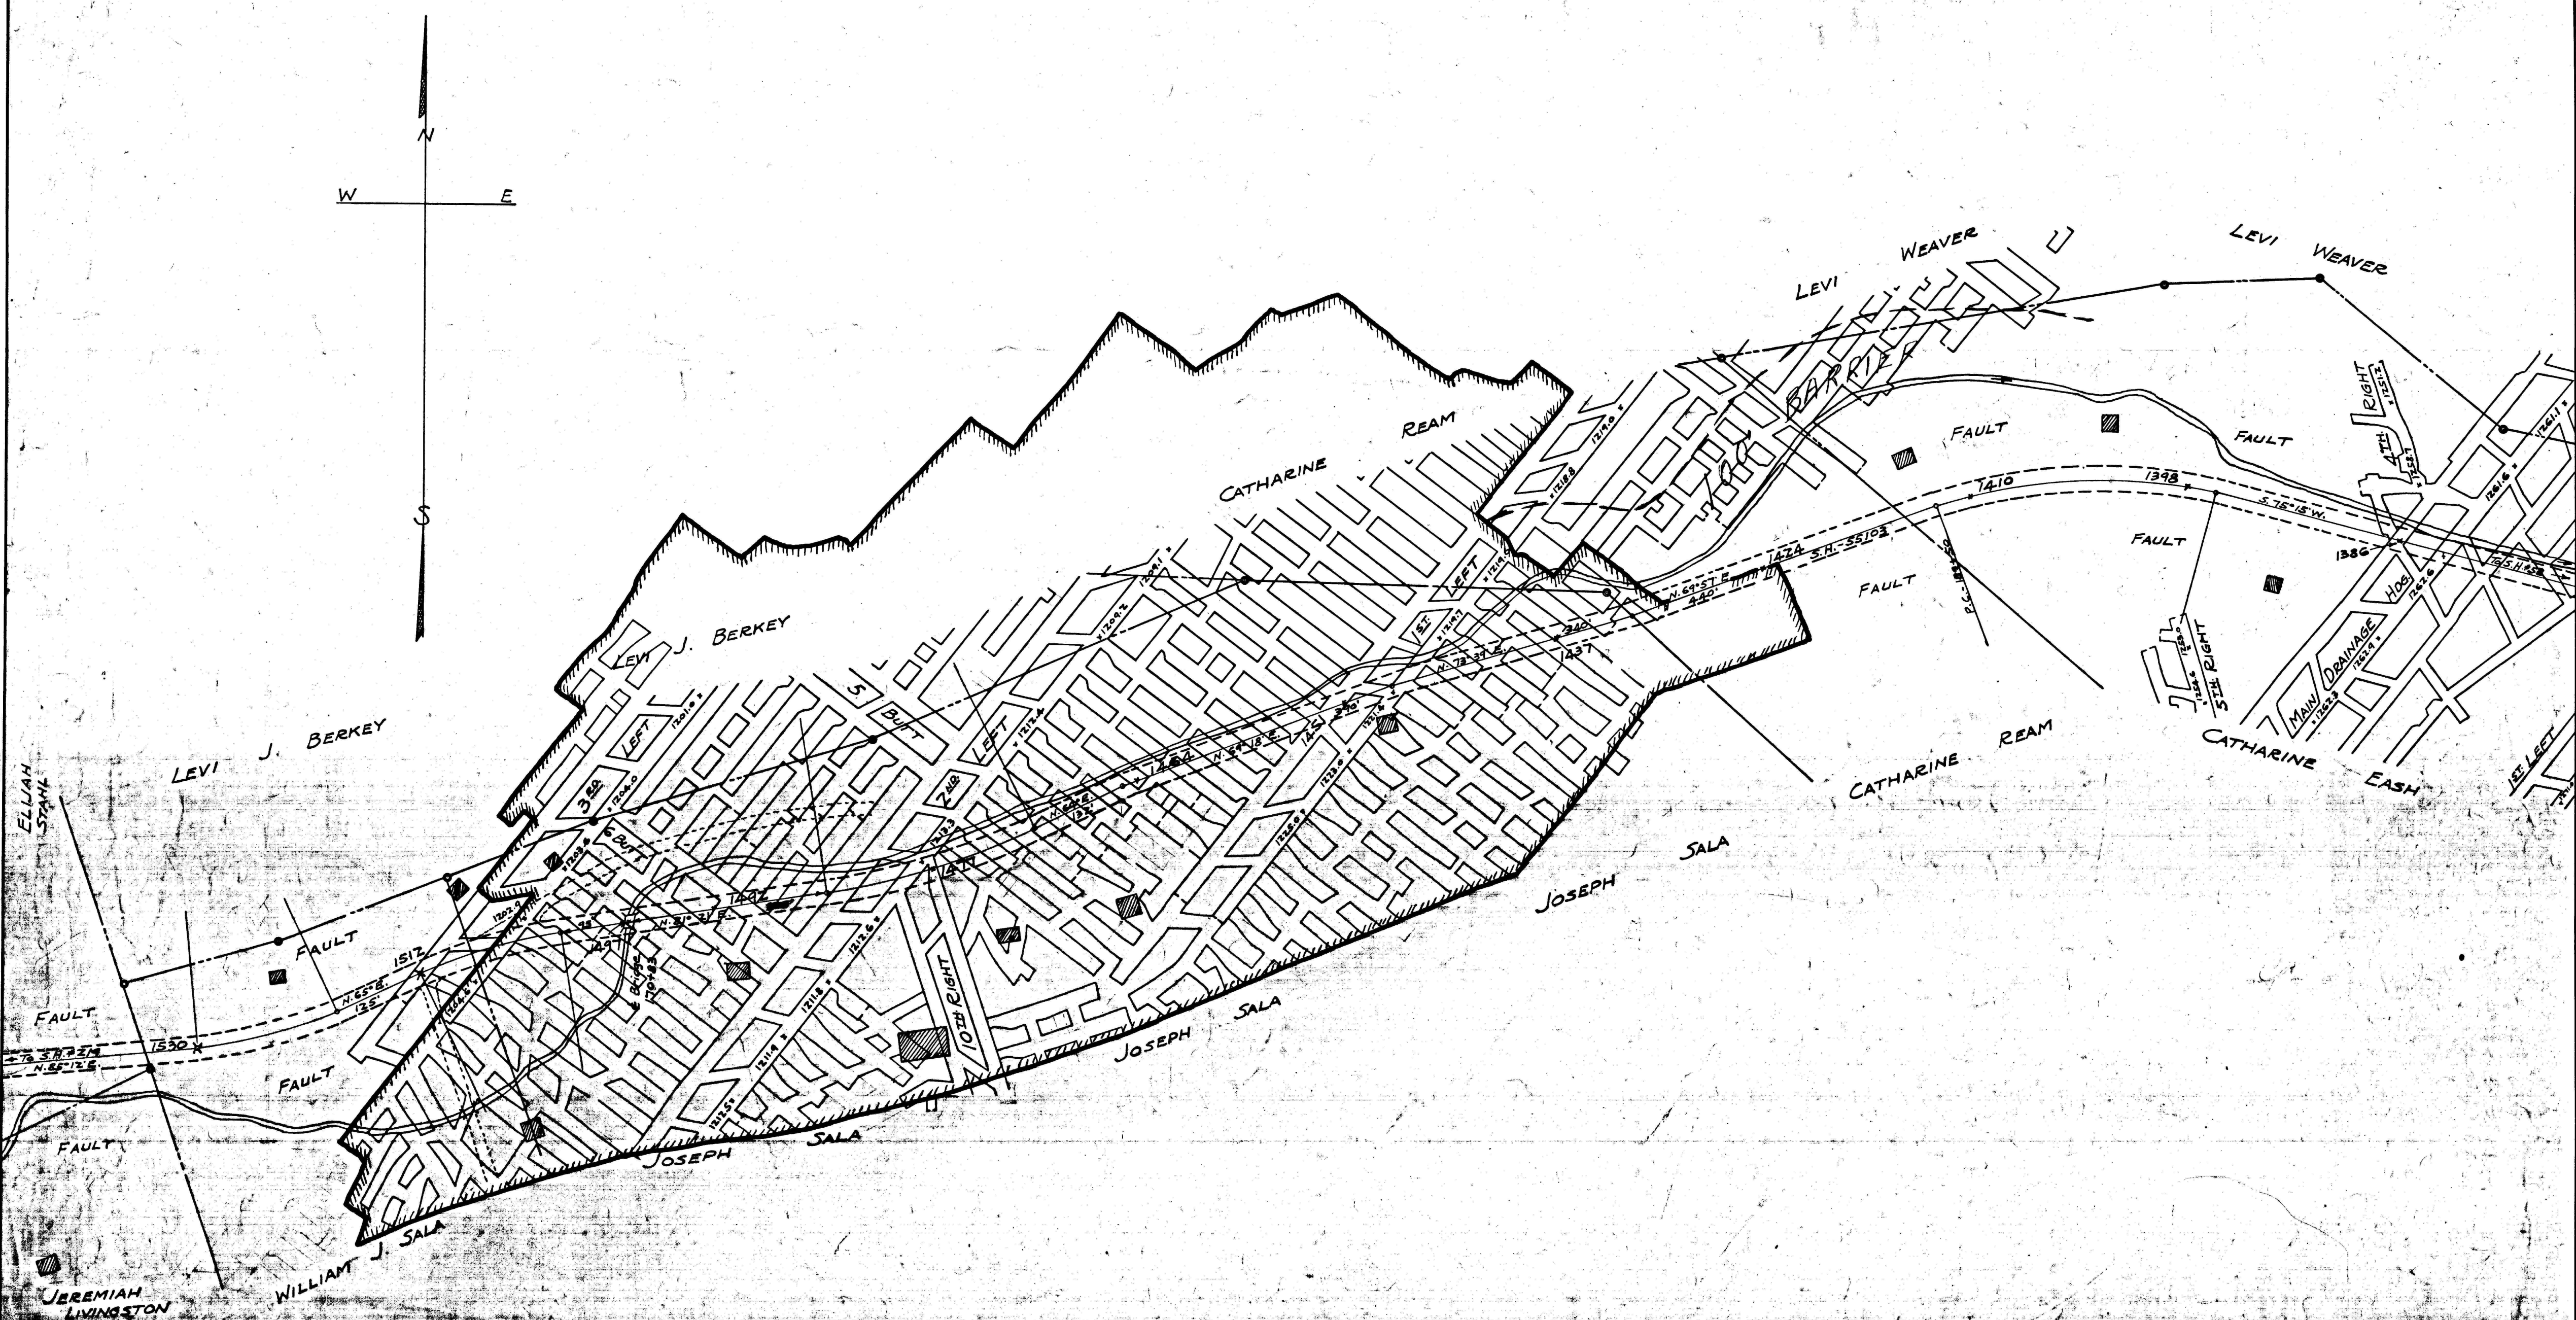

REVISIONS
JAN. 13, 1940.

NOTE

OWNER OF MINERAL--THE WILMORE COAL CO., WINDBEE, PA.
OPERATING COMPANY--BIRD COAL COMPANY
COMPANY'S OFFICES--TIRE HILL, SOMERSET CO., PA. & 1400 SOUTH PENN
SQUARE, PHILADELPHIA, PA.
MINING ENGINEER--S.E. DICKEY & CO., 809 JOHNSTOWN BANK & TRUST BLDG.
JOHNSTOWN, PA.
PROJECTIONS OF COAL TO BE MINED SHOWN THUS 

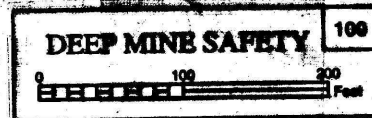

BIRD COAL COMPANY
MINE #2-C PRIME OR CEMENT SEAM OPERATIONS
SHOWING

HIGHWAYS AS REQUIRED BY ACT 438
SITUATE IN

CONEMAUGH TOWNSHIP, SOMERSET COUNTY, PENNA.
SCALE 1"=100' S.E. DICKEY & COMPANY MAR. 5, 1938
CIVIL AND MINING ENGINEERS
JOHNSTOWN, PENNA.