



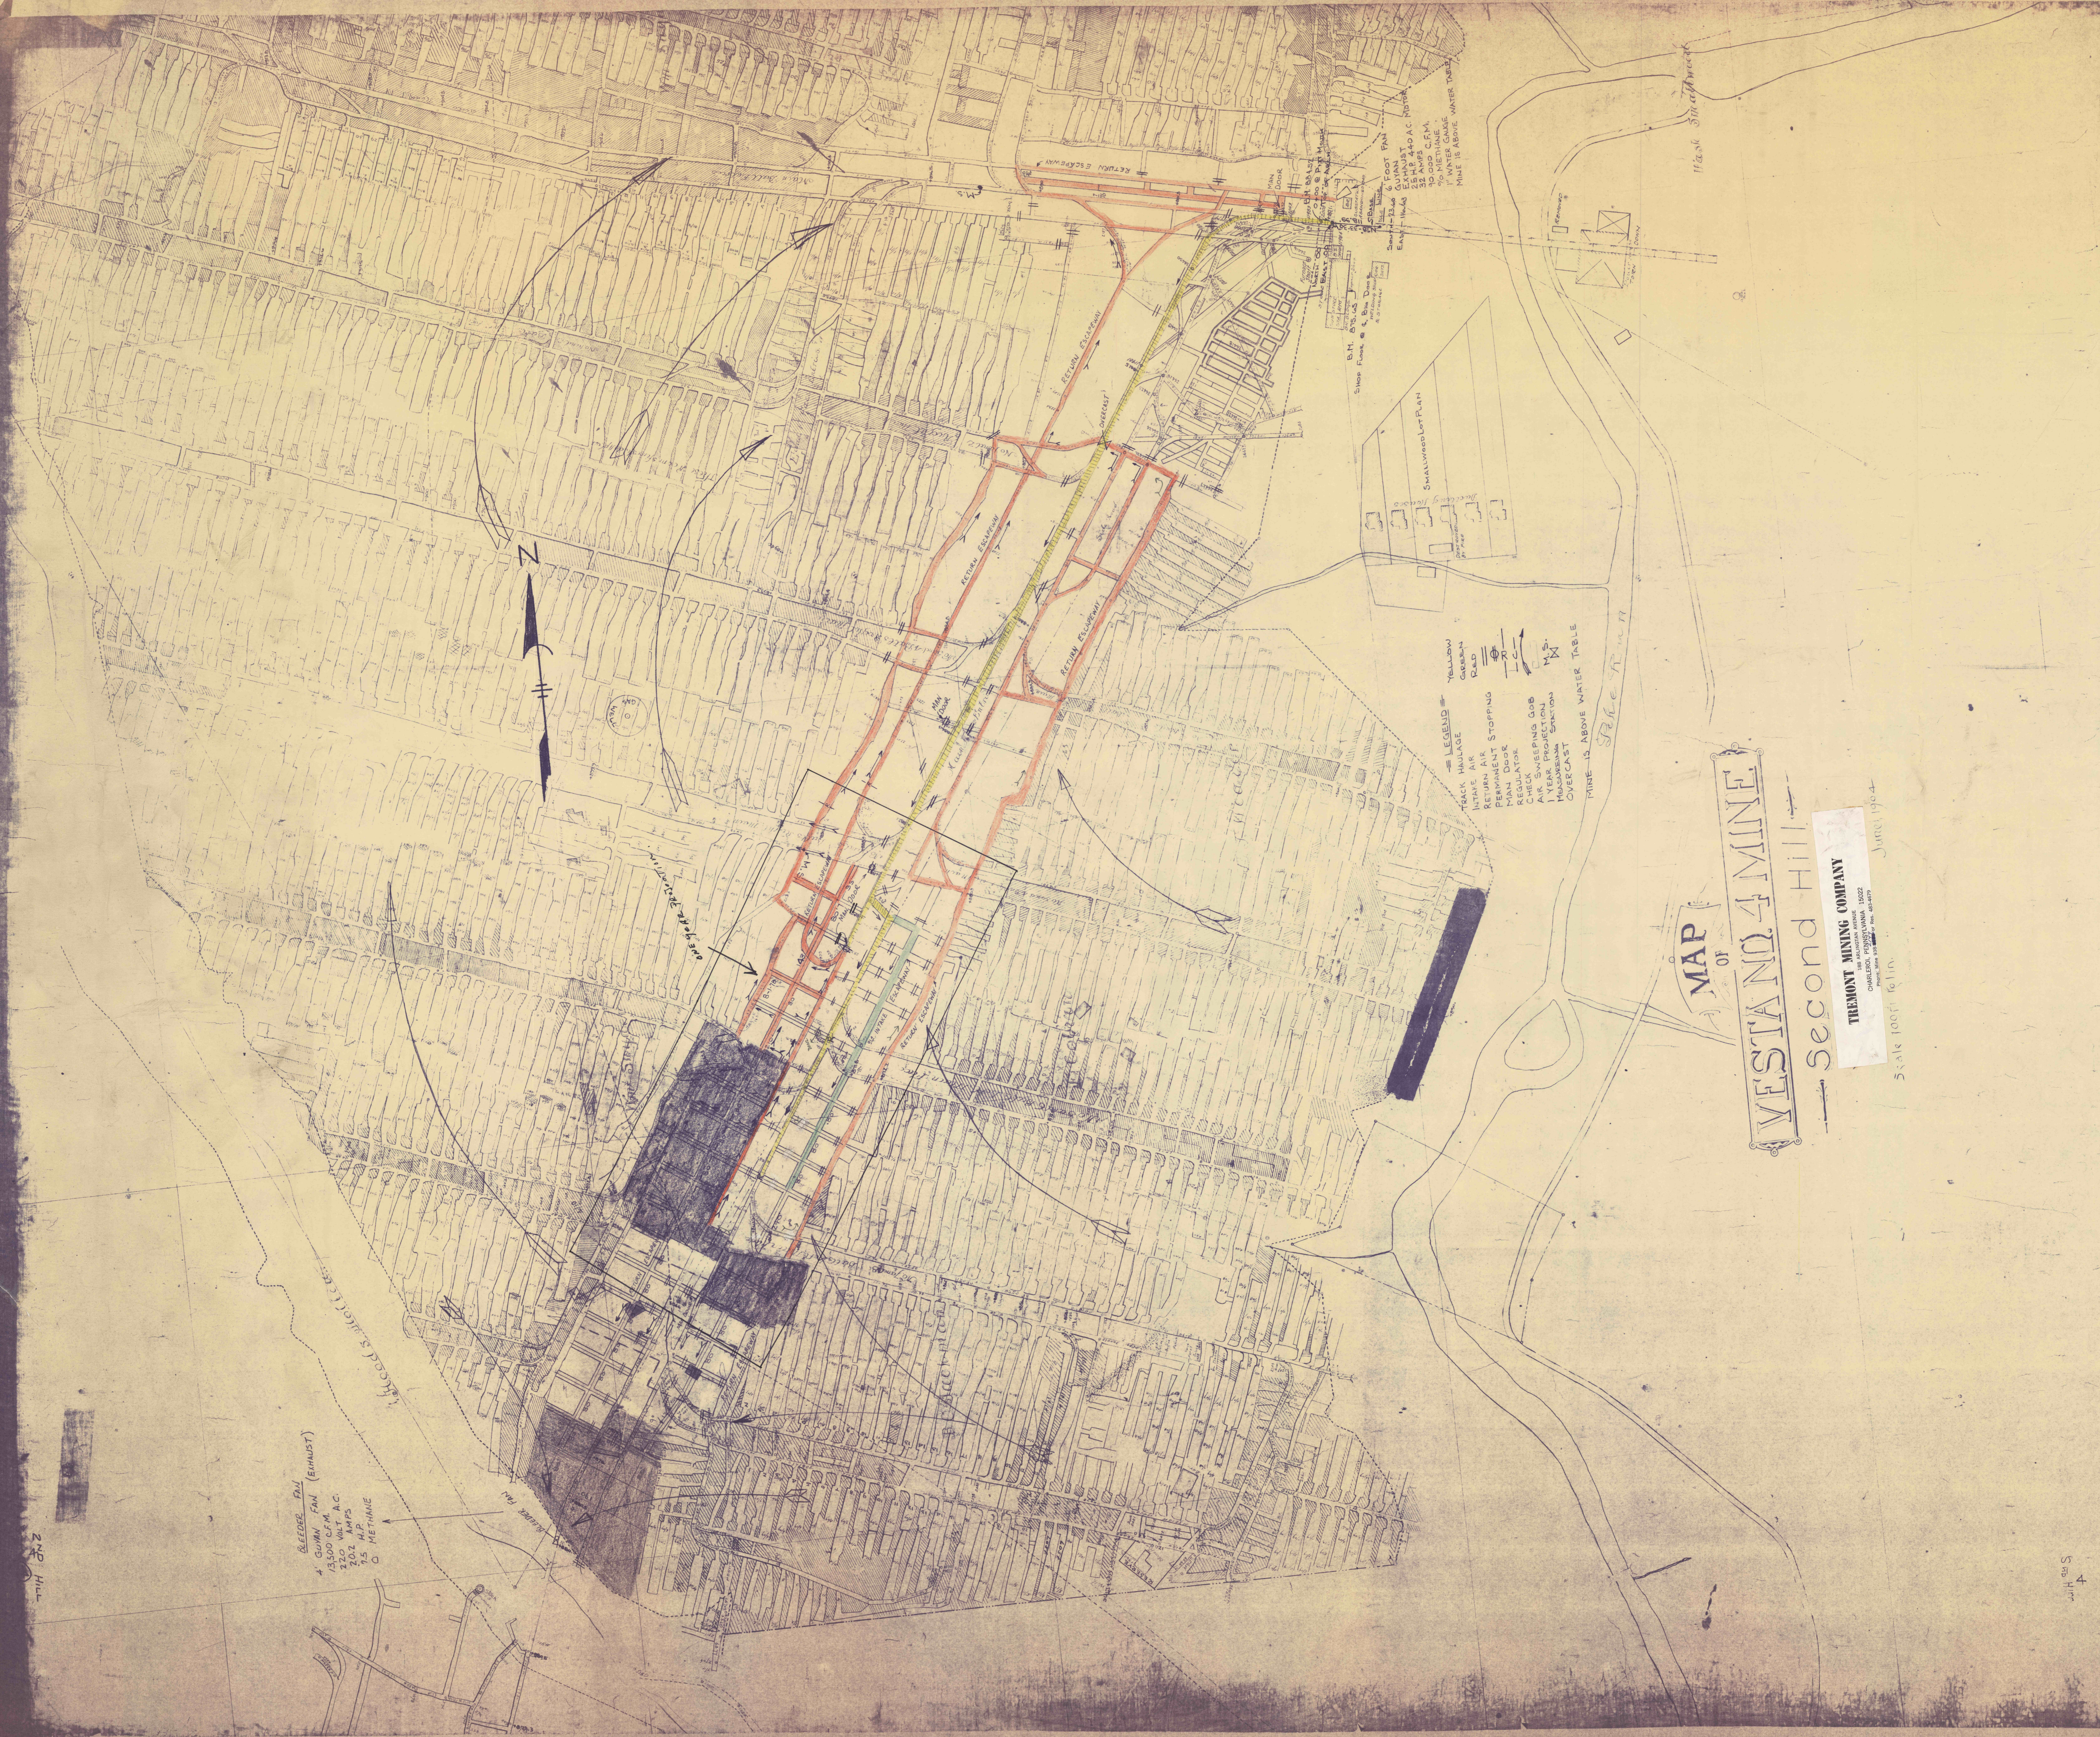

BLEEDER FAN  
O METHANE

LEGEND  
YELLOW TRACK HAULAGE  
GREEN INTAKE AIR  
RED RETURN AIR  
RETURN STOPPING  
PEEN DOOR  
REGULATOR  
CHECK  
AIR SWEEPING GOB  
MATERIAL STATION  
OVERCAST  
MINE IS ABOVE WATER TABLE

# MAP OF VESTA NO. 4 MINE

Second Hill

TREMONT MINING COMPANY  

SCALE 100 FT. TO 1 IN.

Scale 100 ft.