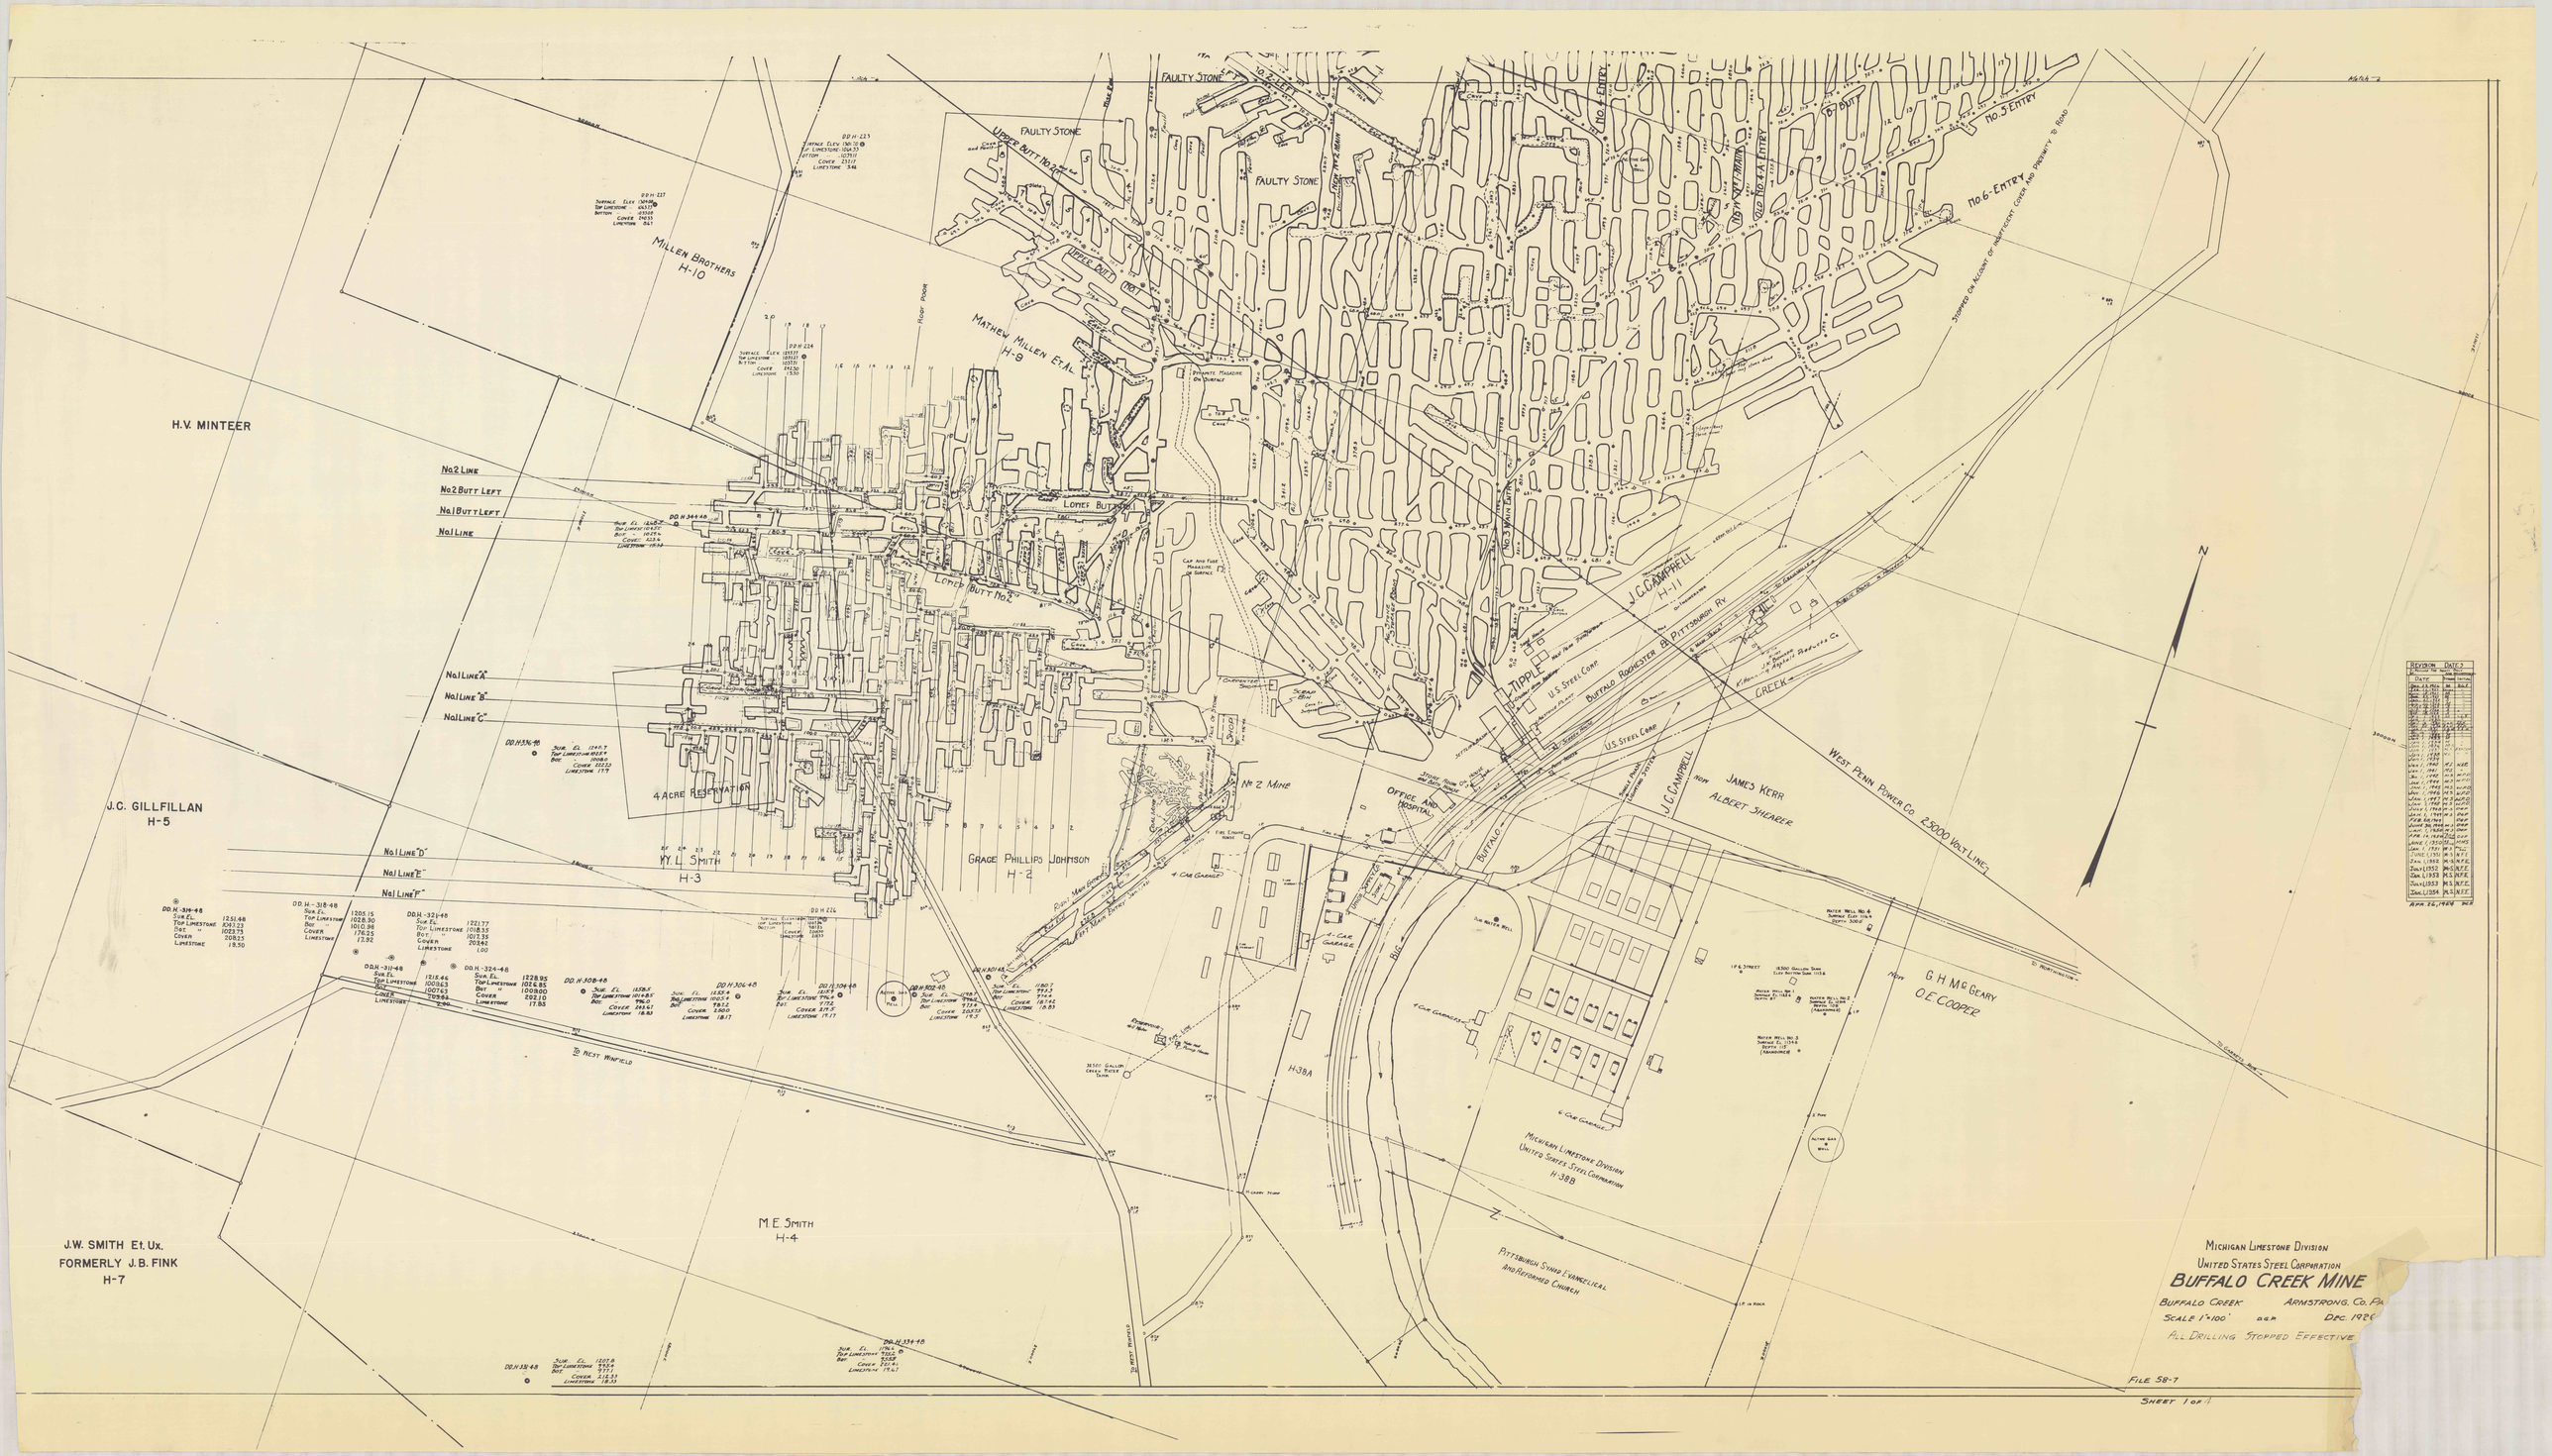
H.V. MINTEER
J.C. GILLFILLAN
H-5
J.W. SMITH Et. Ux.
FORMERLY J.B. FINK
H-7
MILLEN BROTHERS
H-10
MATHEW MILLEN ET.AL
H-9
W.L. SMITH
H-3
GRACE PHILLIPS JOHNSON
H-2
M.E. SMITH
H-4
J.C. CAMPBELL
H-11
H-38A
H-38B
FAULTY STONE
UPPER BUTT No.2
UPPER BUTT No.1
LOWER BUTT No.1
LOWER BUTT No.2
No.2 LINE
No.2 BUTT LEFT
No.1 BUTT LEFT
No.1 LINE
No.1 LINE "A"
No.1 LINE "B"
No.1 LINE "C"
No.1 LINE "D"
No.1 LINE "E"
No.1 LINE "F"
4 ACRE RESERVATION
No.2 MINE
No.3 ENTRY
No.4 ENTRY
No.5 ENTRY
No.6 ENTRY
TIPPLE
OFFICE AND HOSPITAL
U.S. STEEL CORP.
BUFFALO ROCHESTER & PITTSBURGH RY.
BUFFALO CREEK
WEST PENN POWER CO. 23000 VOLT LINE
JAMES KERR
ALBERT SHEARER
G.H. McGEARY
O.E. COOPER
MICHIGAN LIMESTONE DIVISION
UNITED STATES STEEL CORPORATION
H-38B
PITTSBURGH SYNOD EVANGELICAL AND REFORMED CHURCH
TO WEST WINFIELD
TO BUTT
MICHIGAN LIMESTONE DIVISION
UNITED STATES STEEL CORPORATION
BUFFALO CREEK MINE
BUFFALO CREEK ARMSTRONG, CO. PA.
SCALE 1"=100' D.G.R. DEC. 1926
ALL DRILLING STOPPED EFFECTIVE
FILE 58-7
SHEET 1 OF 1