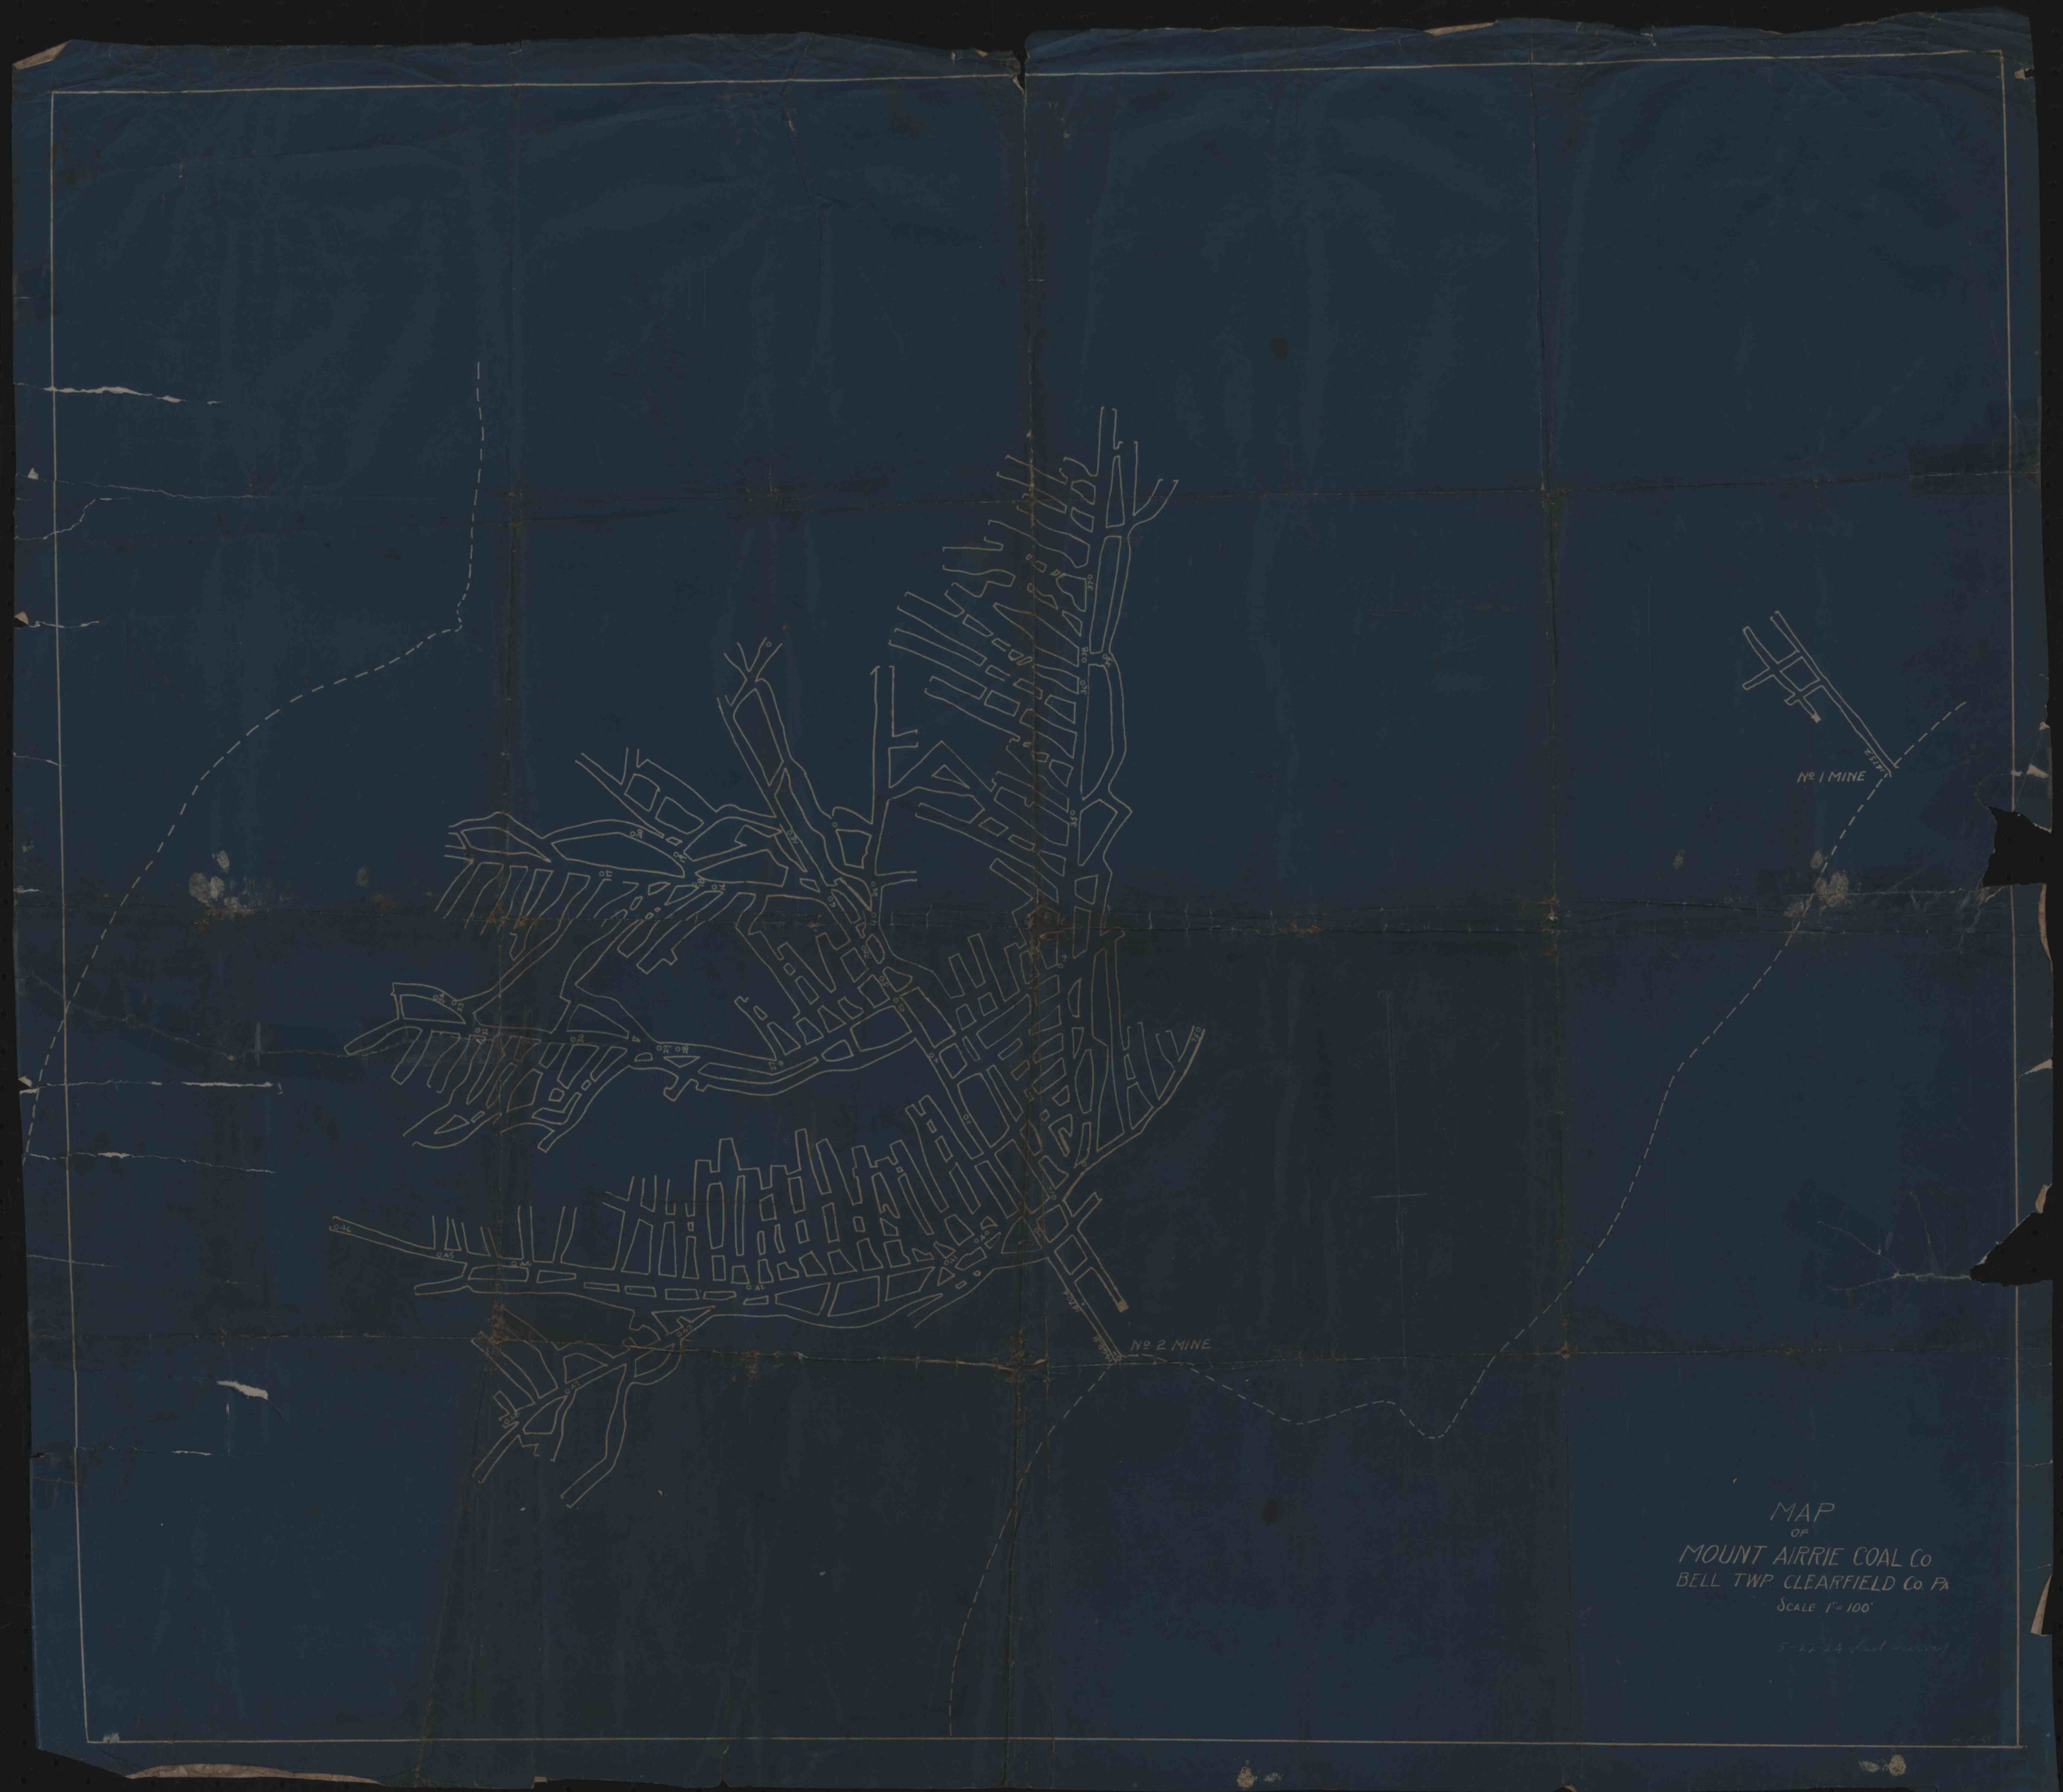

MAP
OF
MOUNT AIRRIE COAL Co
BELL TWP CLEARFIELD Co. PA
SCALE 1"= 100'