


SHEET NO. 1
DUQUESNE LIGHT CO.
WARWICK MINE NO. 2
PITTSBURGH COAL

SURVEY DATES

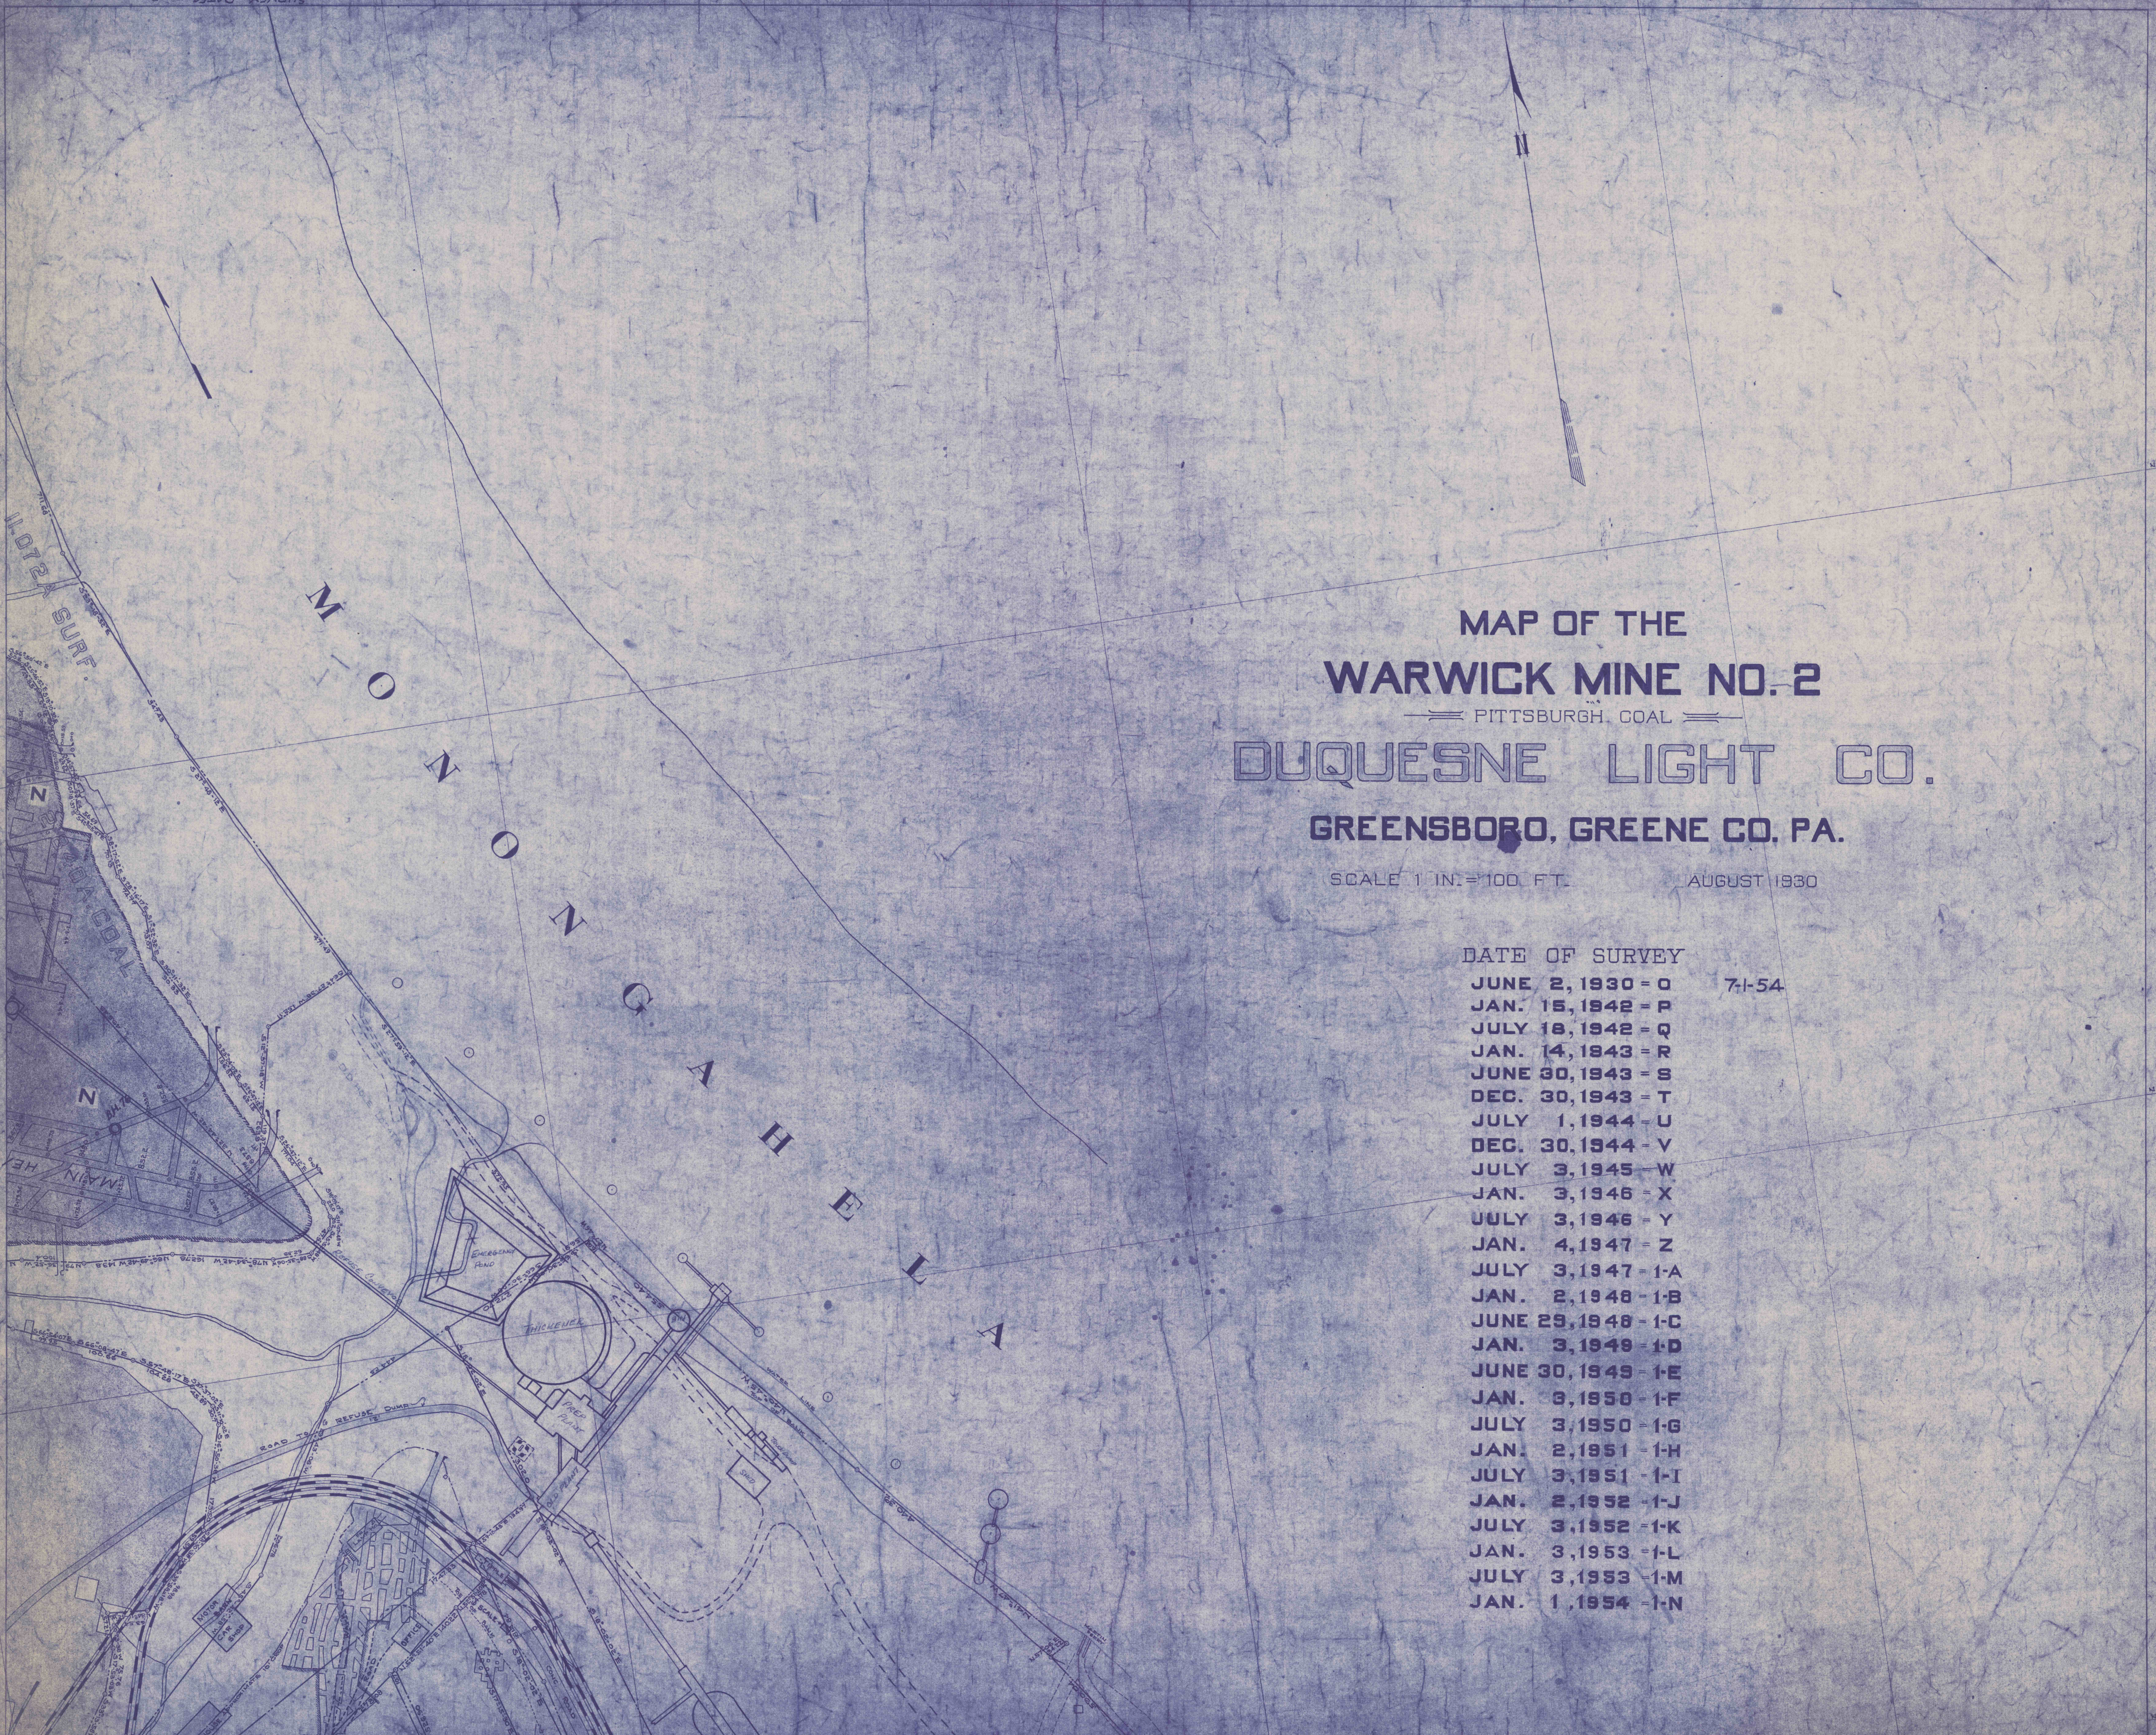

MAP OF THE
WARWICK MINE NO. 2
PITTSBURGH COAL
DUQUESNE LIGHT CO.
GREENSBORO, GREENE CO. PA.

SCALE 1 IN. = 100 FT. AUGUST 1930

DATE OF SURVEY

- JUNE 2, 1930 = O 7-1-54
- JAN. 15, 1942 = P
- JULY 18, 1942 = Q
- JAN. 14, 1943 = R
- JUNE 30, 1943 = S
- DEC. 30, 1943 = T
- JULY 1, 1944 = U
- DEC. 30, 1944 = V
- JULY 3, 1945 = W
- JAN. 3, 1946 = X
- JULY 3, 1946 = Y
- JAN. 4, 1947 = Z
- JULY 3, 1947 = 1-A
- JAN. 2, 1948 = 1-B
- JUNE 29, 1948 = 1-C
- JAN. 3, 1949 = 1-D
- JUNE 30, 1949 = 1-E
- JAN. 3, 1950 = 1-F
- JULY 3, 1950 = 1-G
- JAN. 2, 1951 = 1-H
- JULY 3, 1951 = 1-I
- JAN. 2, 1952 = 1-J
- JULY 3, 1952 = 1-K
- JAN. 3, 1953 = 1-L
- JULY 3, 1953 = 1-M
- JAN. 1, 1954 = 1-N

SURVEY DATES
DUQUESNE LIGHT CO.
WARWICK MINE NO. 2
PITTSBURGH COAL
SHEET NO. 1