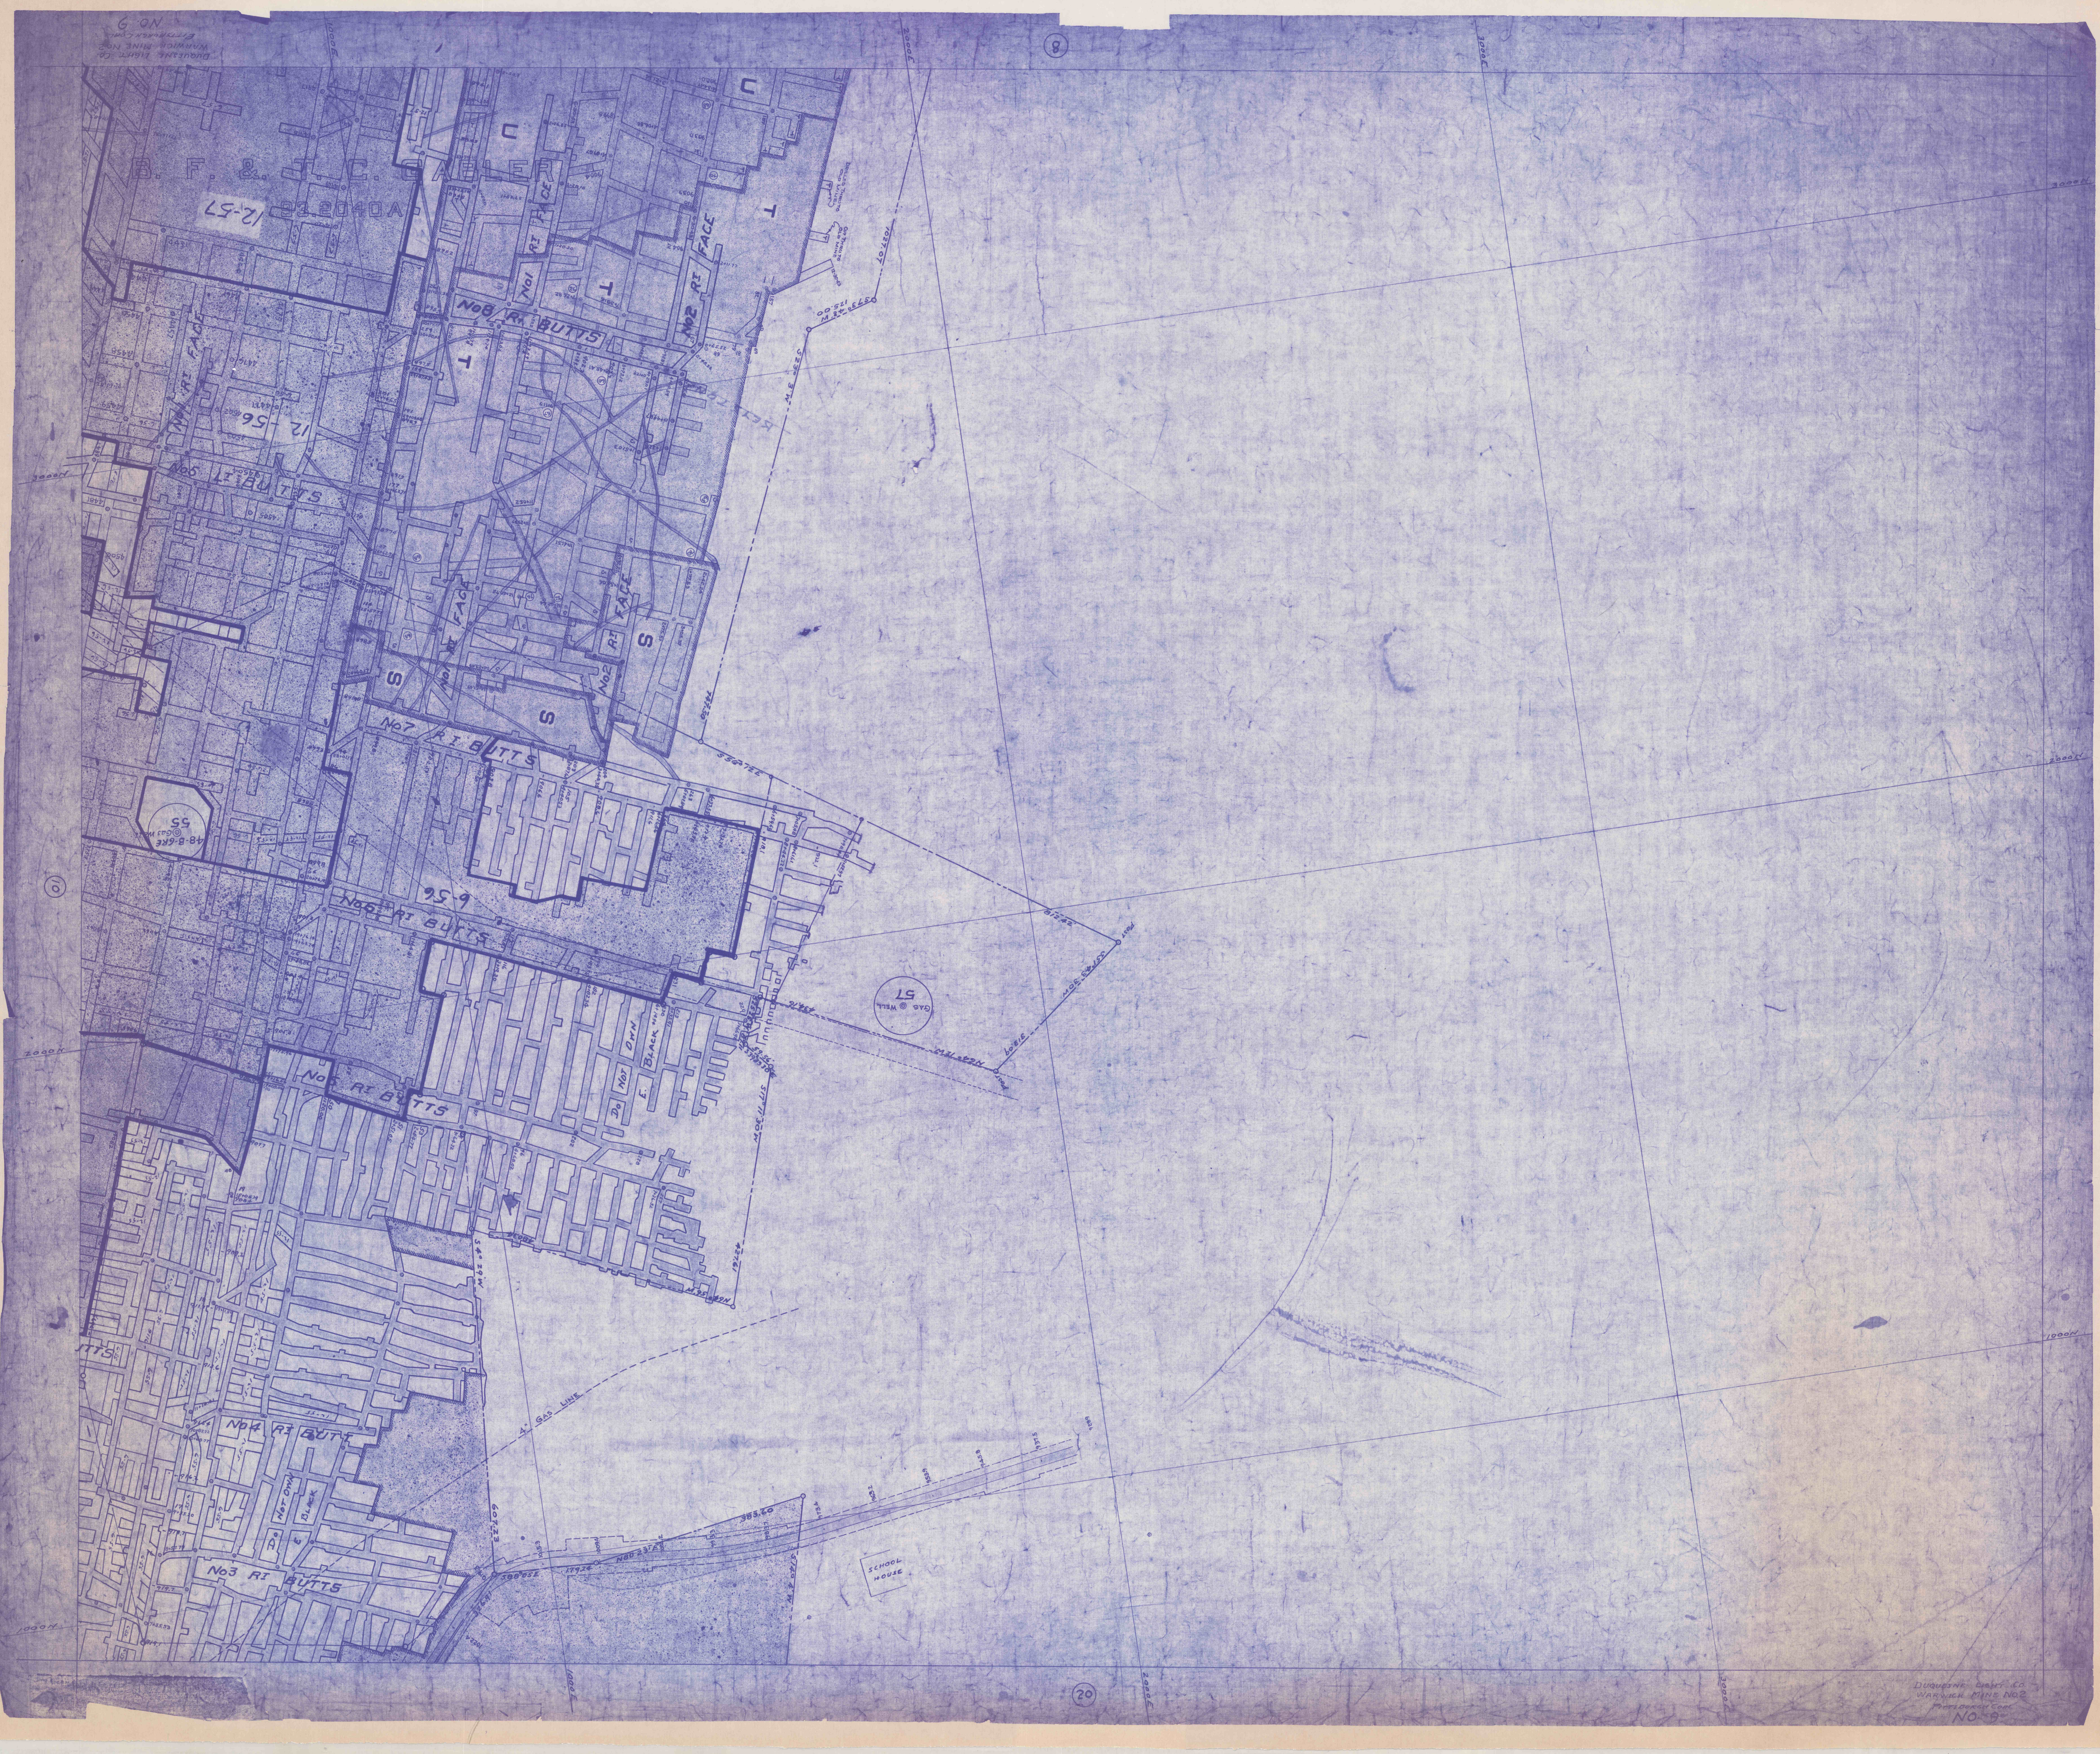
B. F. & J. C. GABLER
93.2040A
12-57
12-56
6-56
No8 RT BUTTS
No7 RT BUTTS
No6 RT BUTTS
No5 LT BUTTS
No4 RT BUTTS
No3 RT BUTTS
No2 RT BUTTS
No1 RT FACE
No2 RT FACE
Do NOT OWN E. BLACK
GAS WELL 57
GAS WELL 55
48-B-GRE
4" GAS LINE
SCHOOL HOUSE
DRILLED THRU TO OLD MINE
CUT THRU TO OLD MINE
POST
3000E
2000E
1000E
3000N
2000N
1000N
(8)
(10)
(20)
DUQUESNE LIGHT CO.
WARWICK MINE NO.2
PITTSBURGH COAL
NO. 9