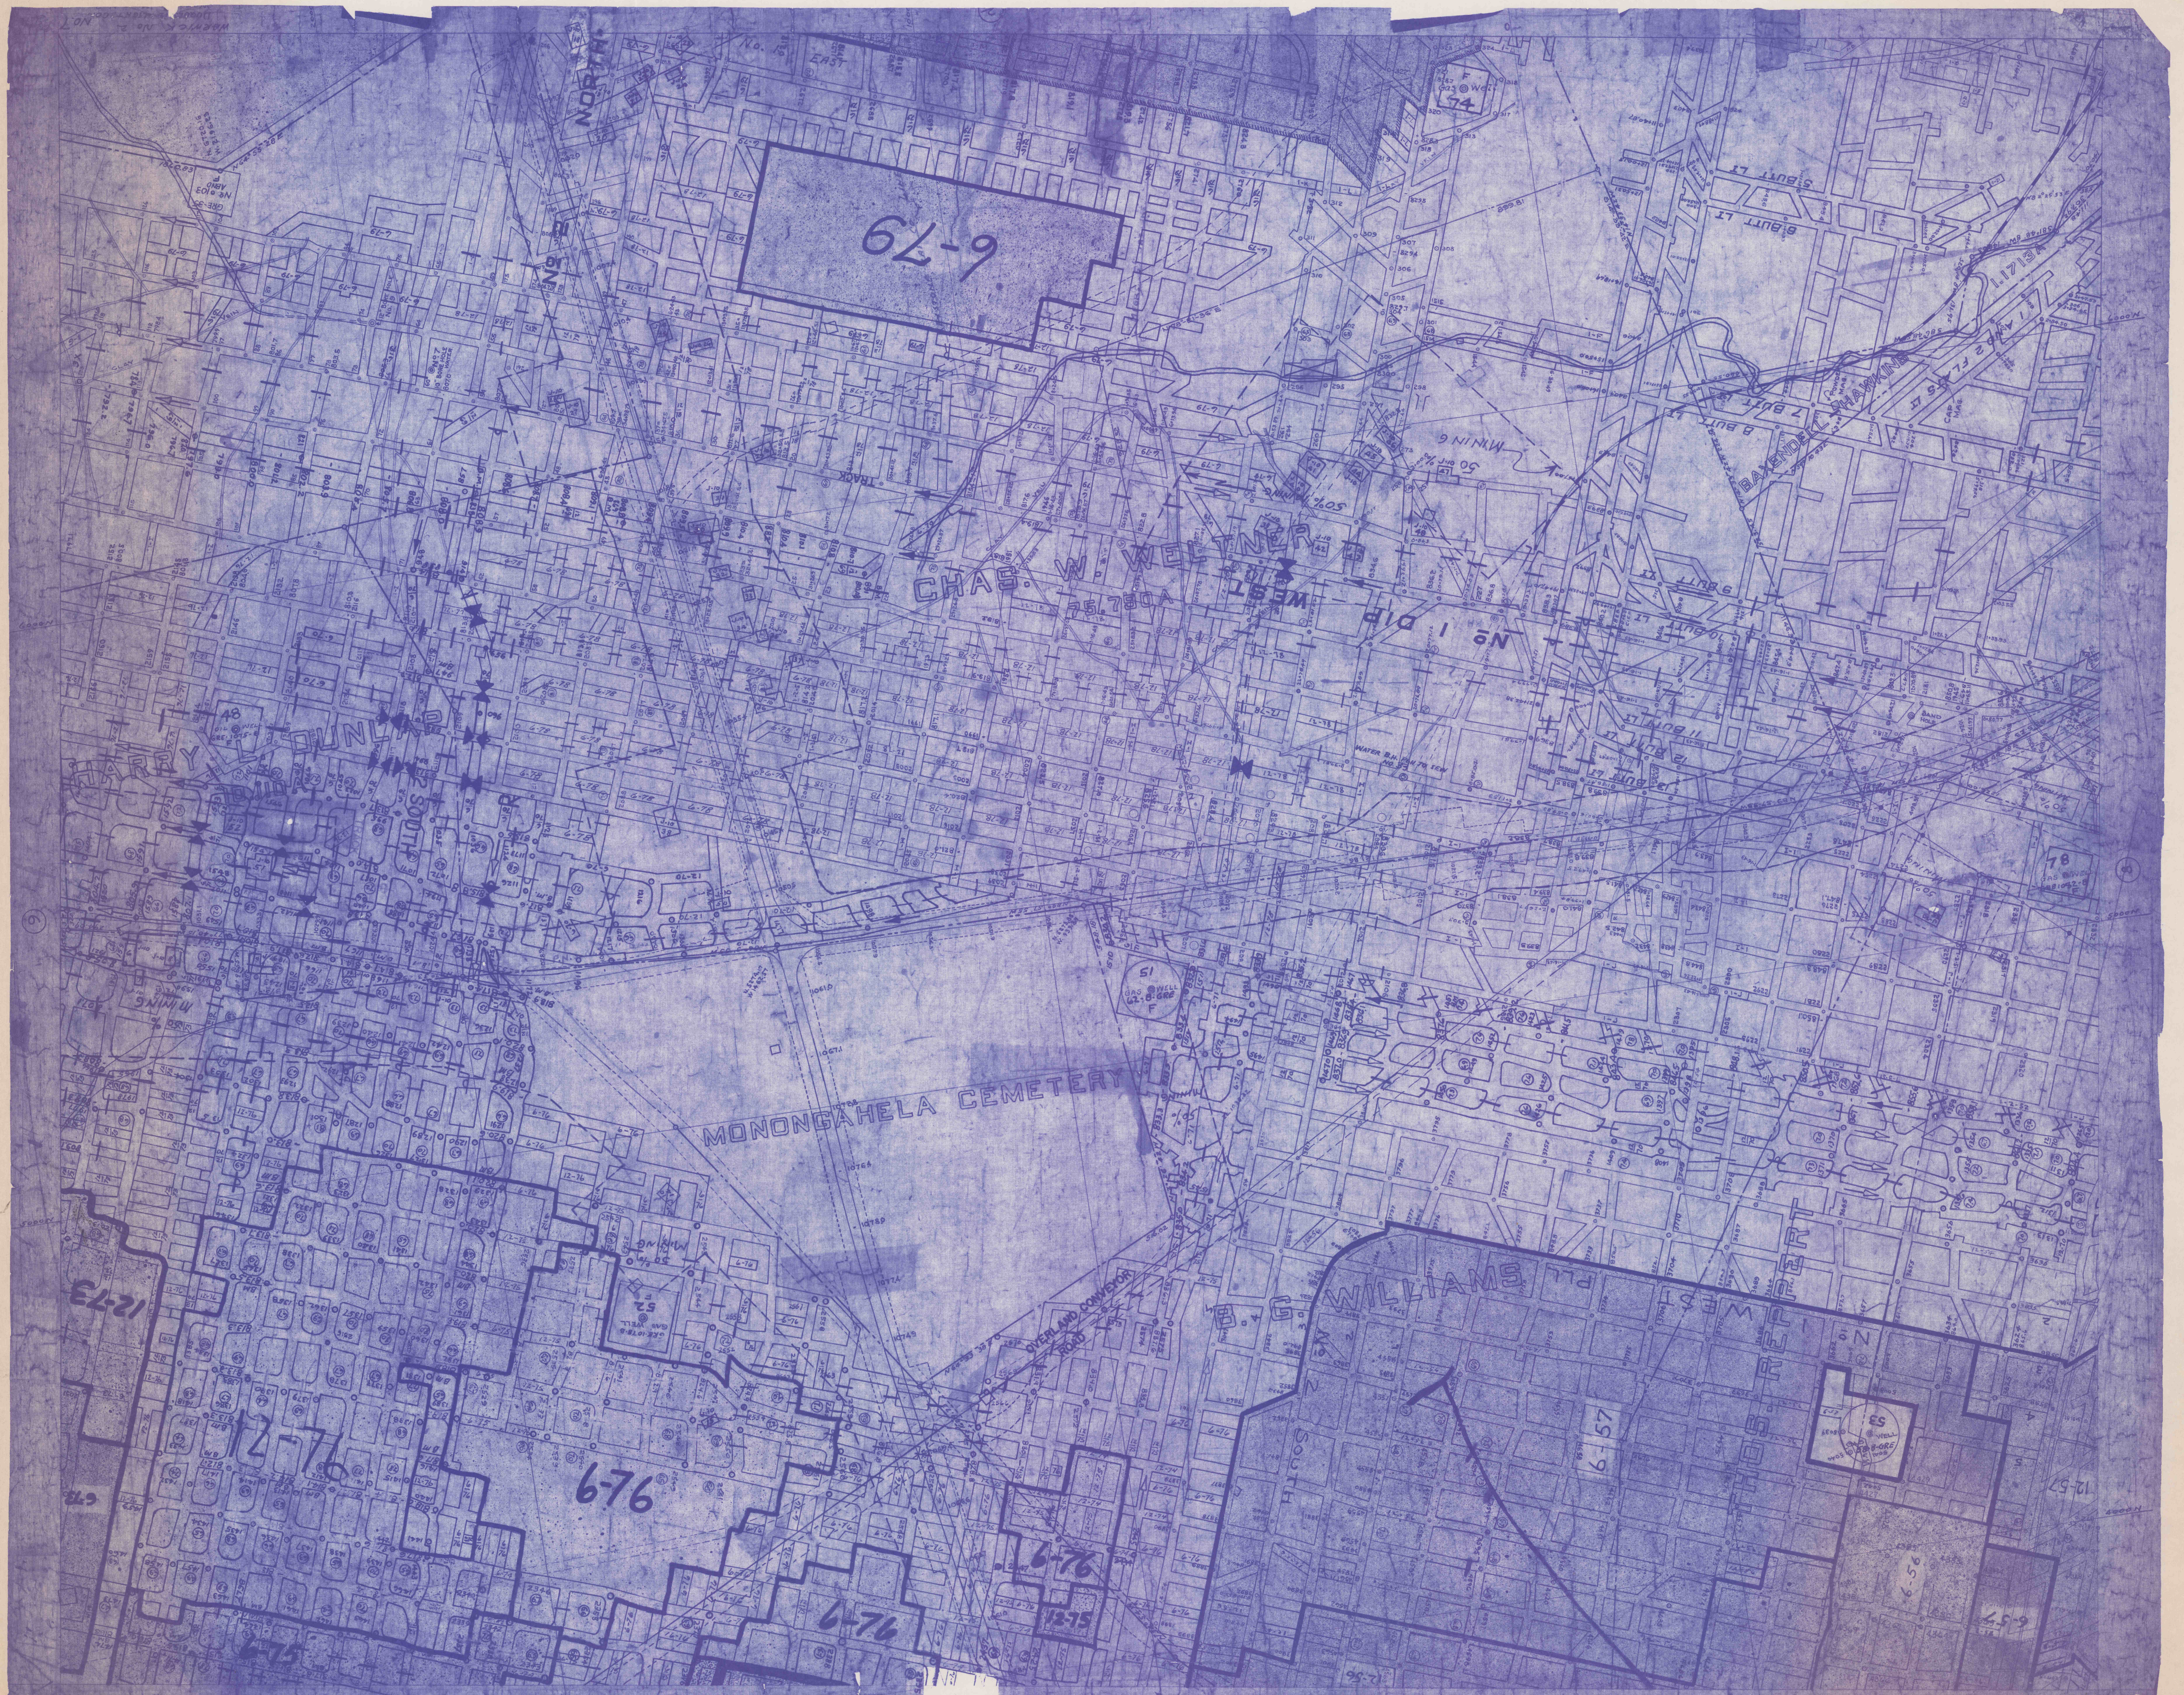
6-79
CHAS. W. WELTNER
75.780 A
WEST
No 1 DIP
MINING 6
50%
HARRY DUNLAP
SOUTH
MONONGAHELA CEMETERY
OVERLAND CONVEYOR ROAD
B. G. WILLIAMS
No 1 WEST
SOUTH
6-57
12-57
6-56
12-73
12-76
6-76
6-75
12-75
NORTH
TRACK
48
10