
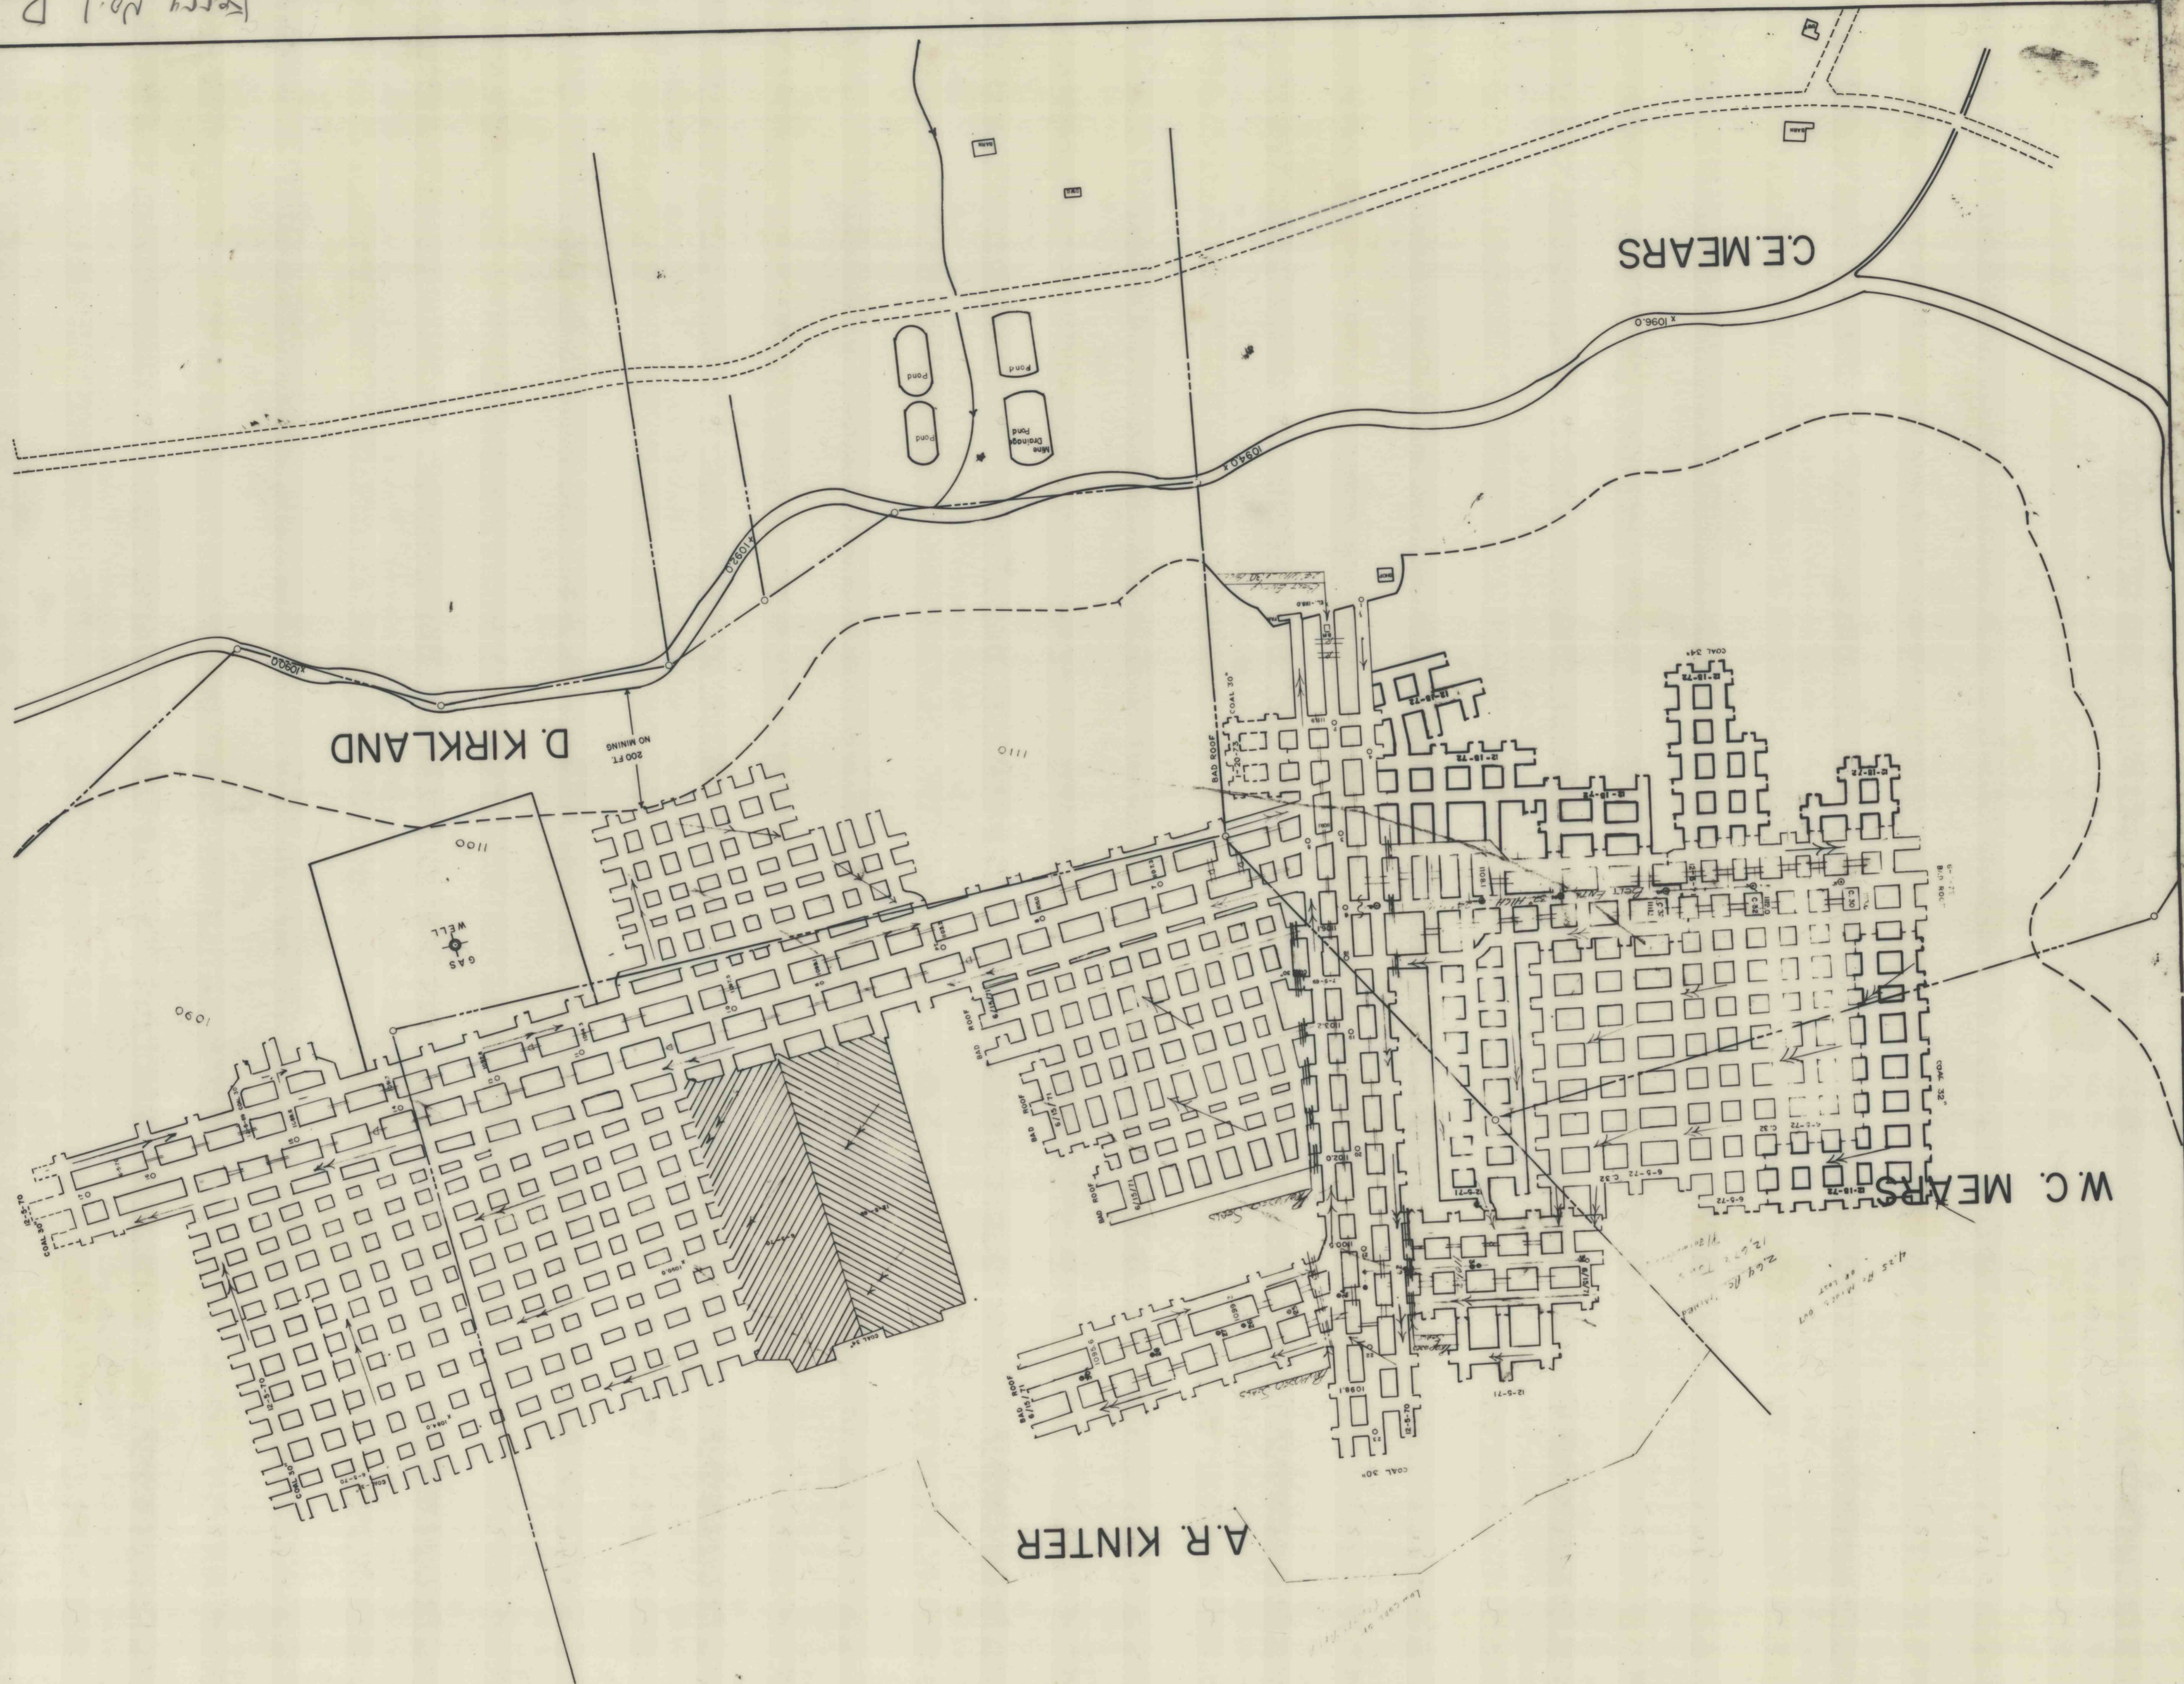


15200  
Rec. 2/21/73  
Kerry No. 1 D  
Final Map  
D-226

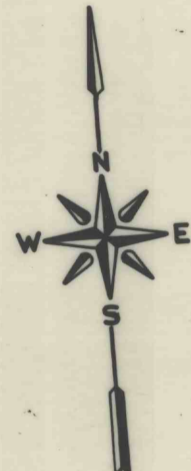

A.R. KINTER

W.C. MEARS

C.E. MEARS

D. KIRKLAND

GAS WELL

200 FT. NO. MINING

COAL 30'

COAL 20'

COAL 24'

COAL 30'

COAL 30'

