


PROPERTY LINE BARRIER

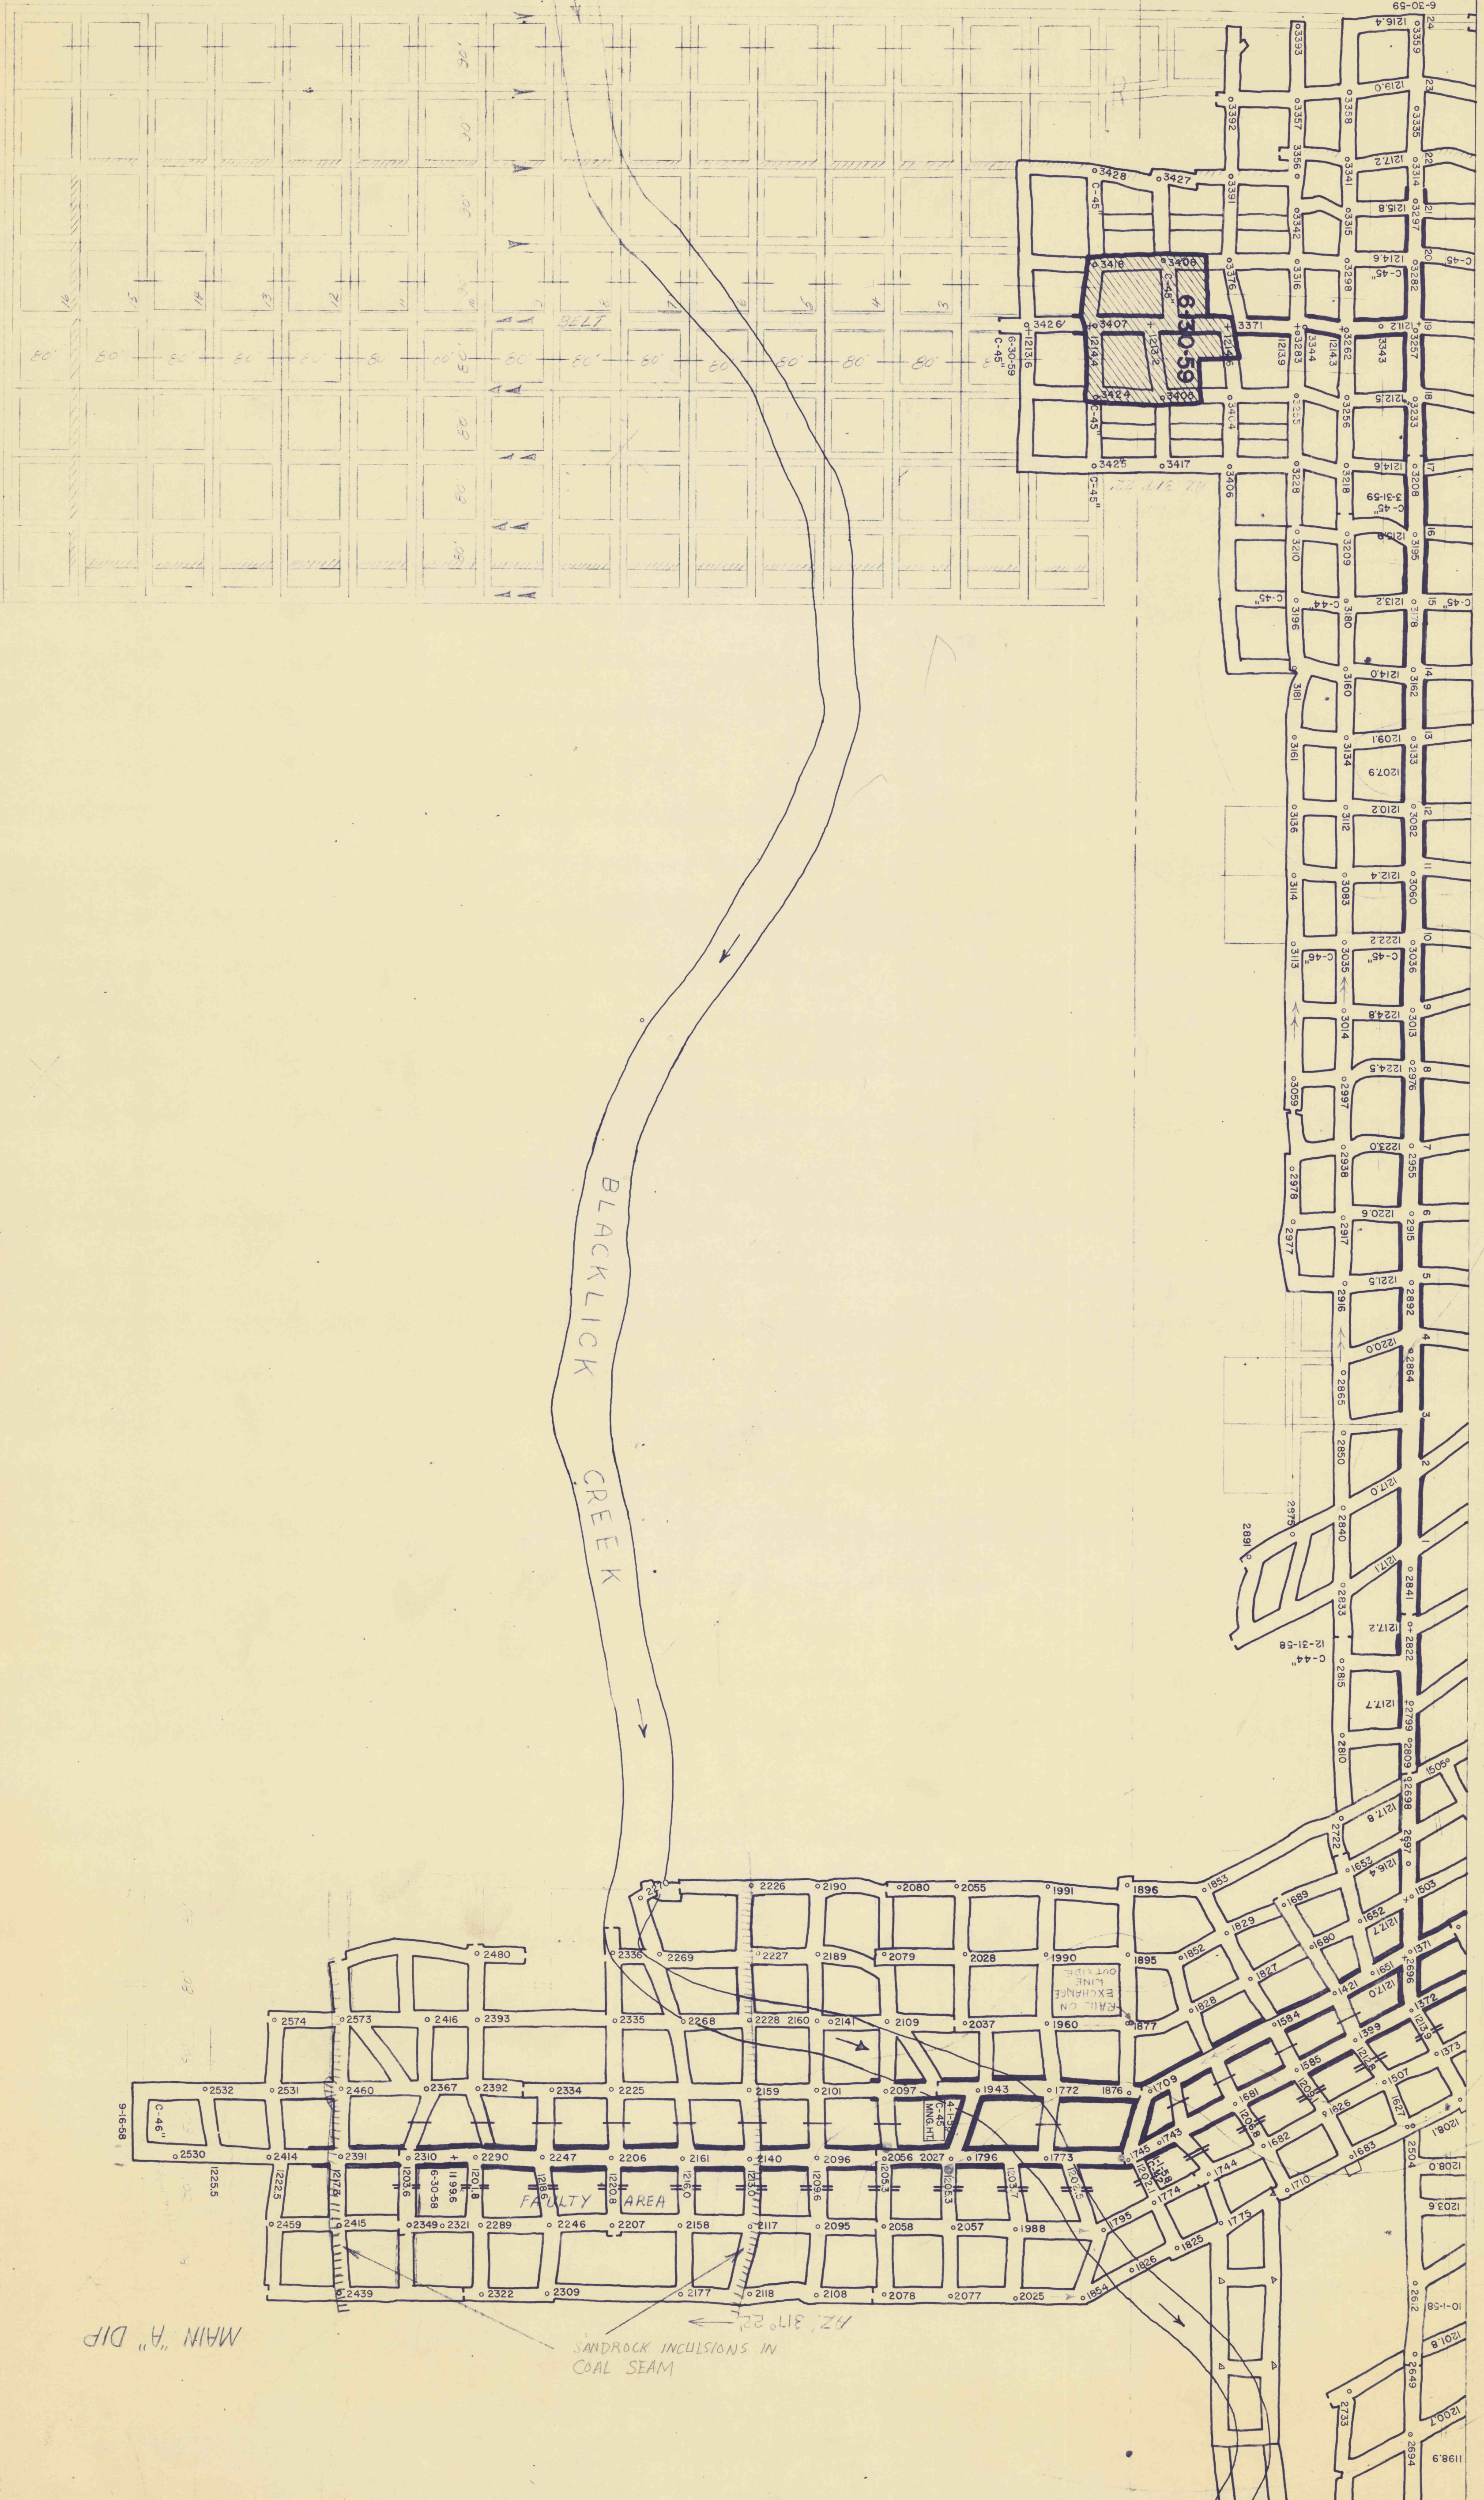

MAIN "A" DIP


COLVER MINE SHEET N° 0-77