


COLVER MINE
SHEET 057

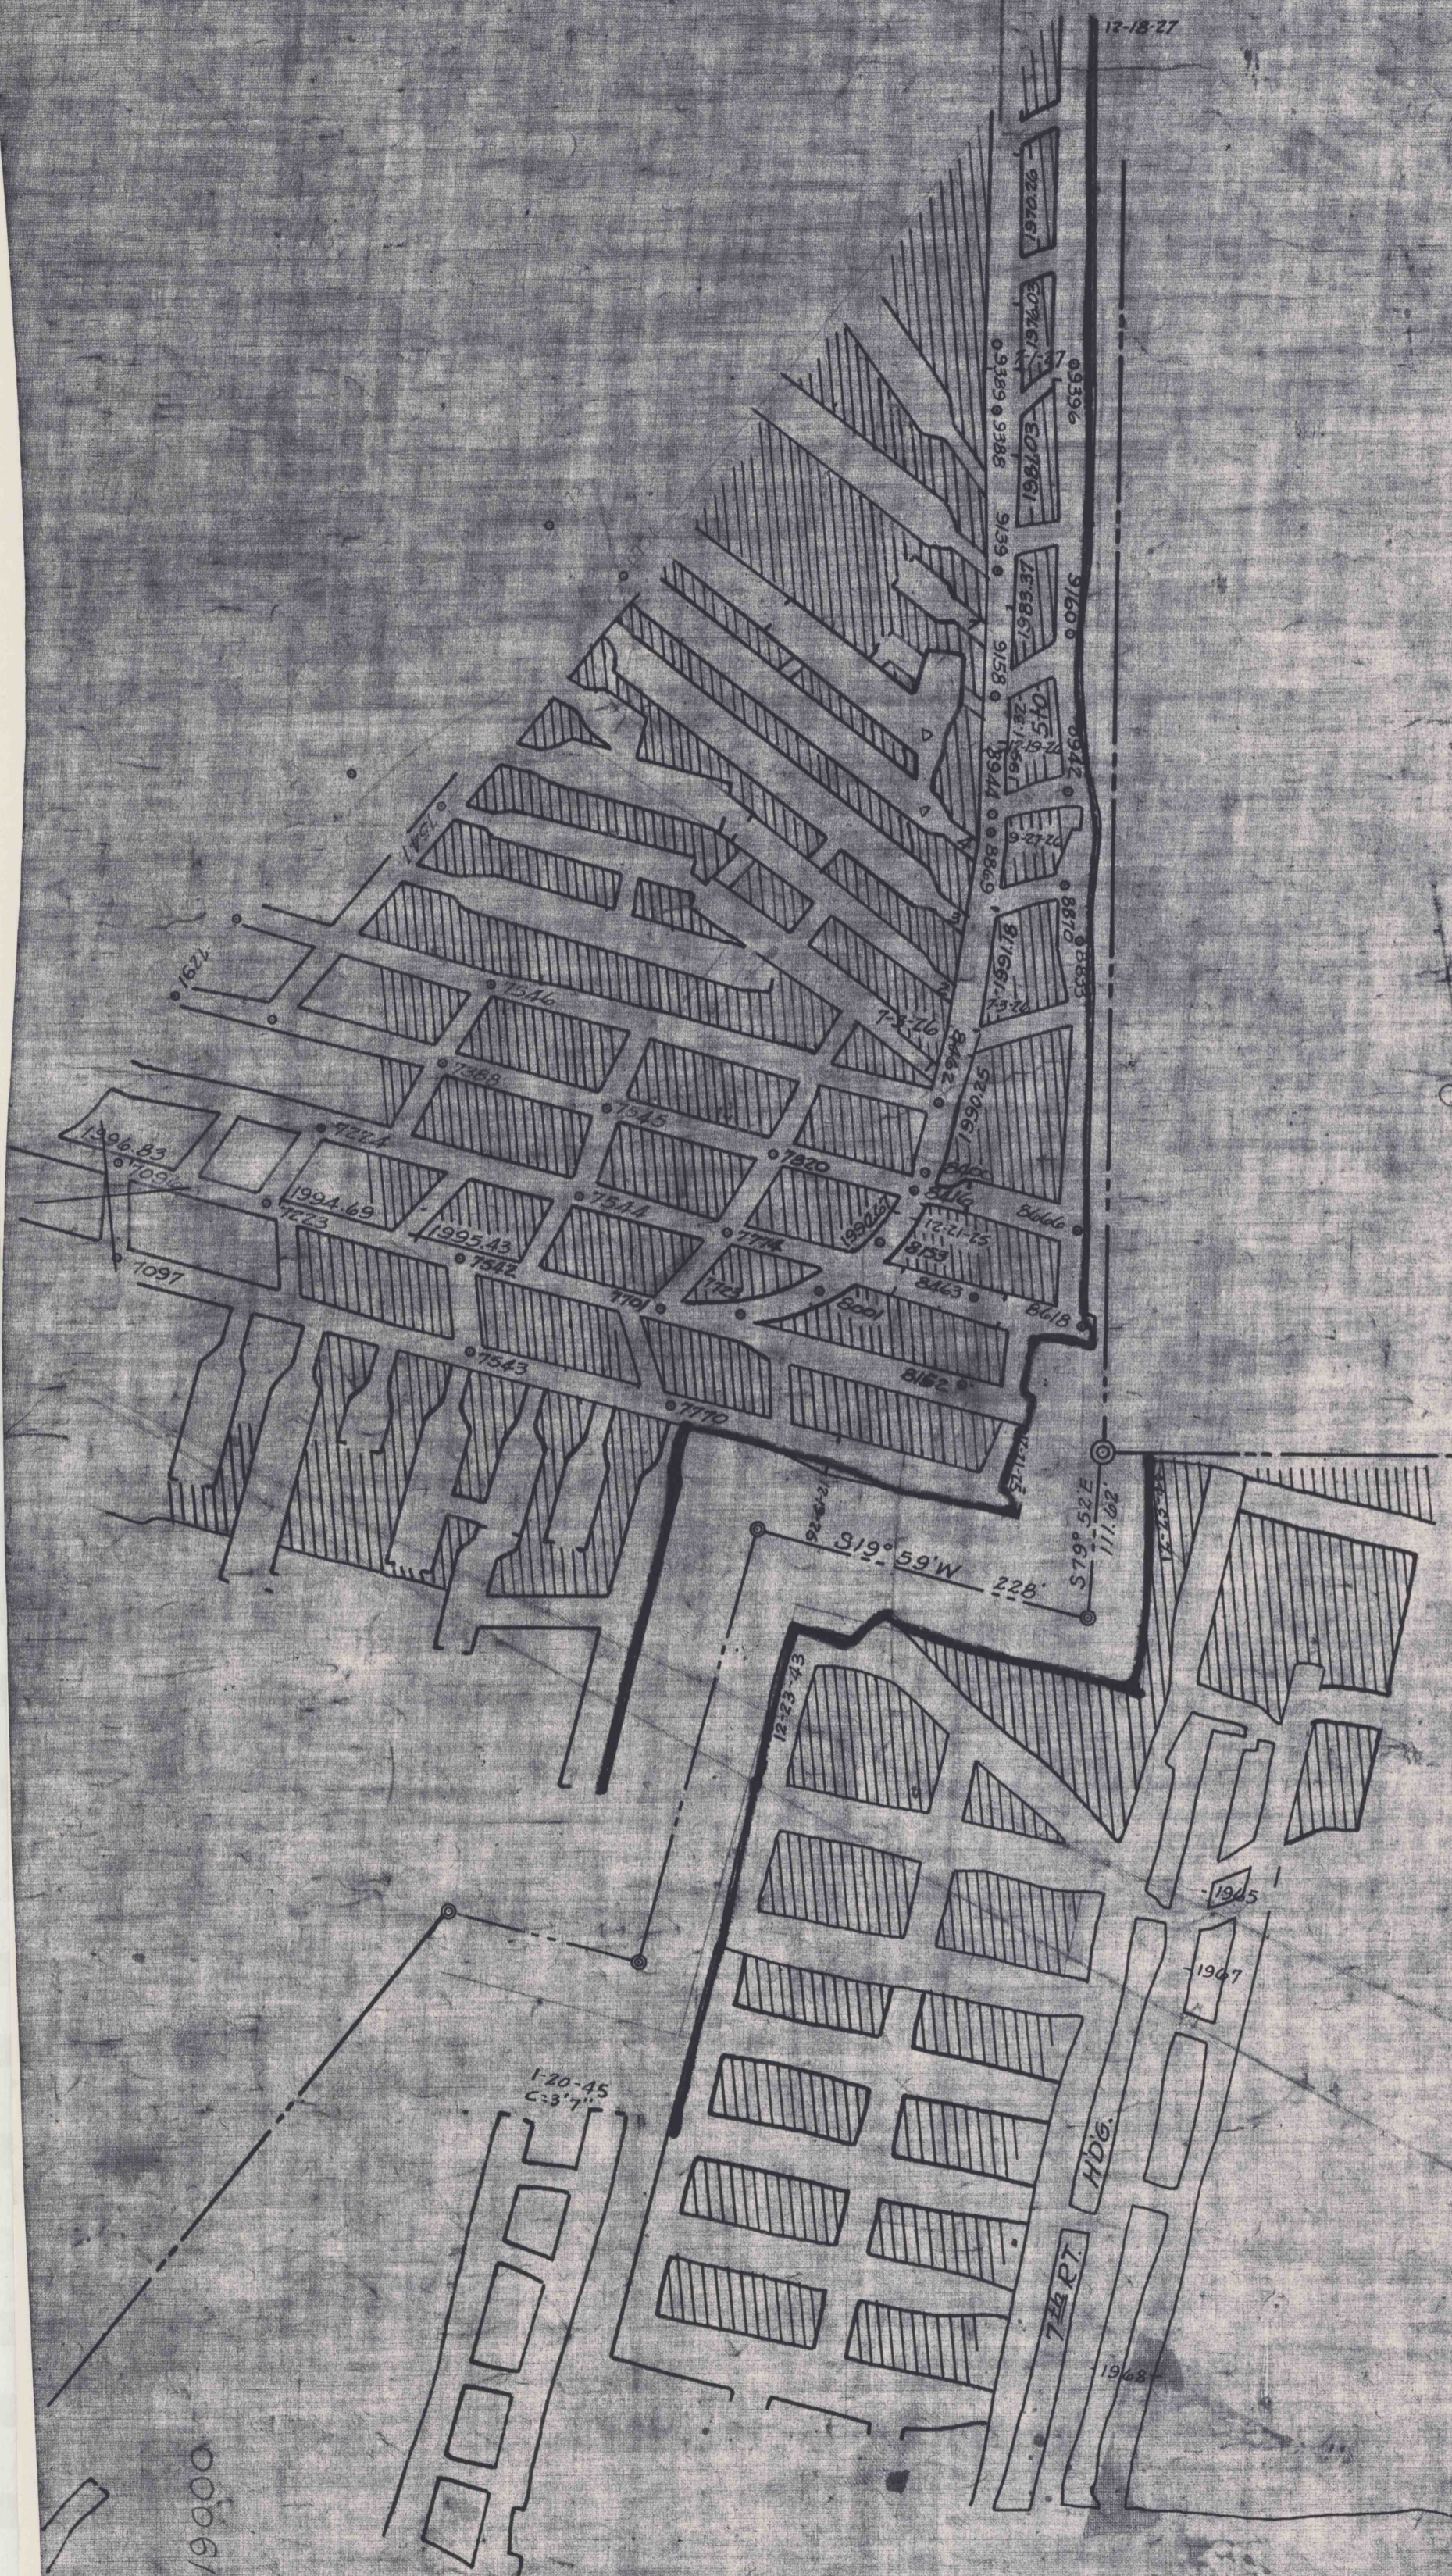

N 19000
W 32000

N 18000
W 31000

12-18-27

S19°59'W 228'

S79°52'E 111.02'

1.20-45
C:3.7'

7th RT.

Hdg.