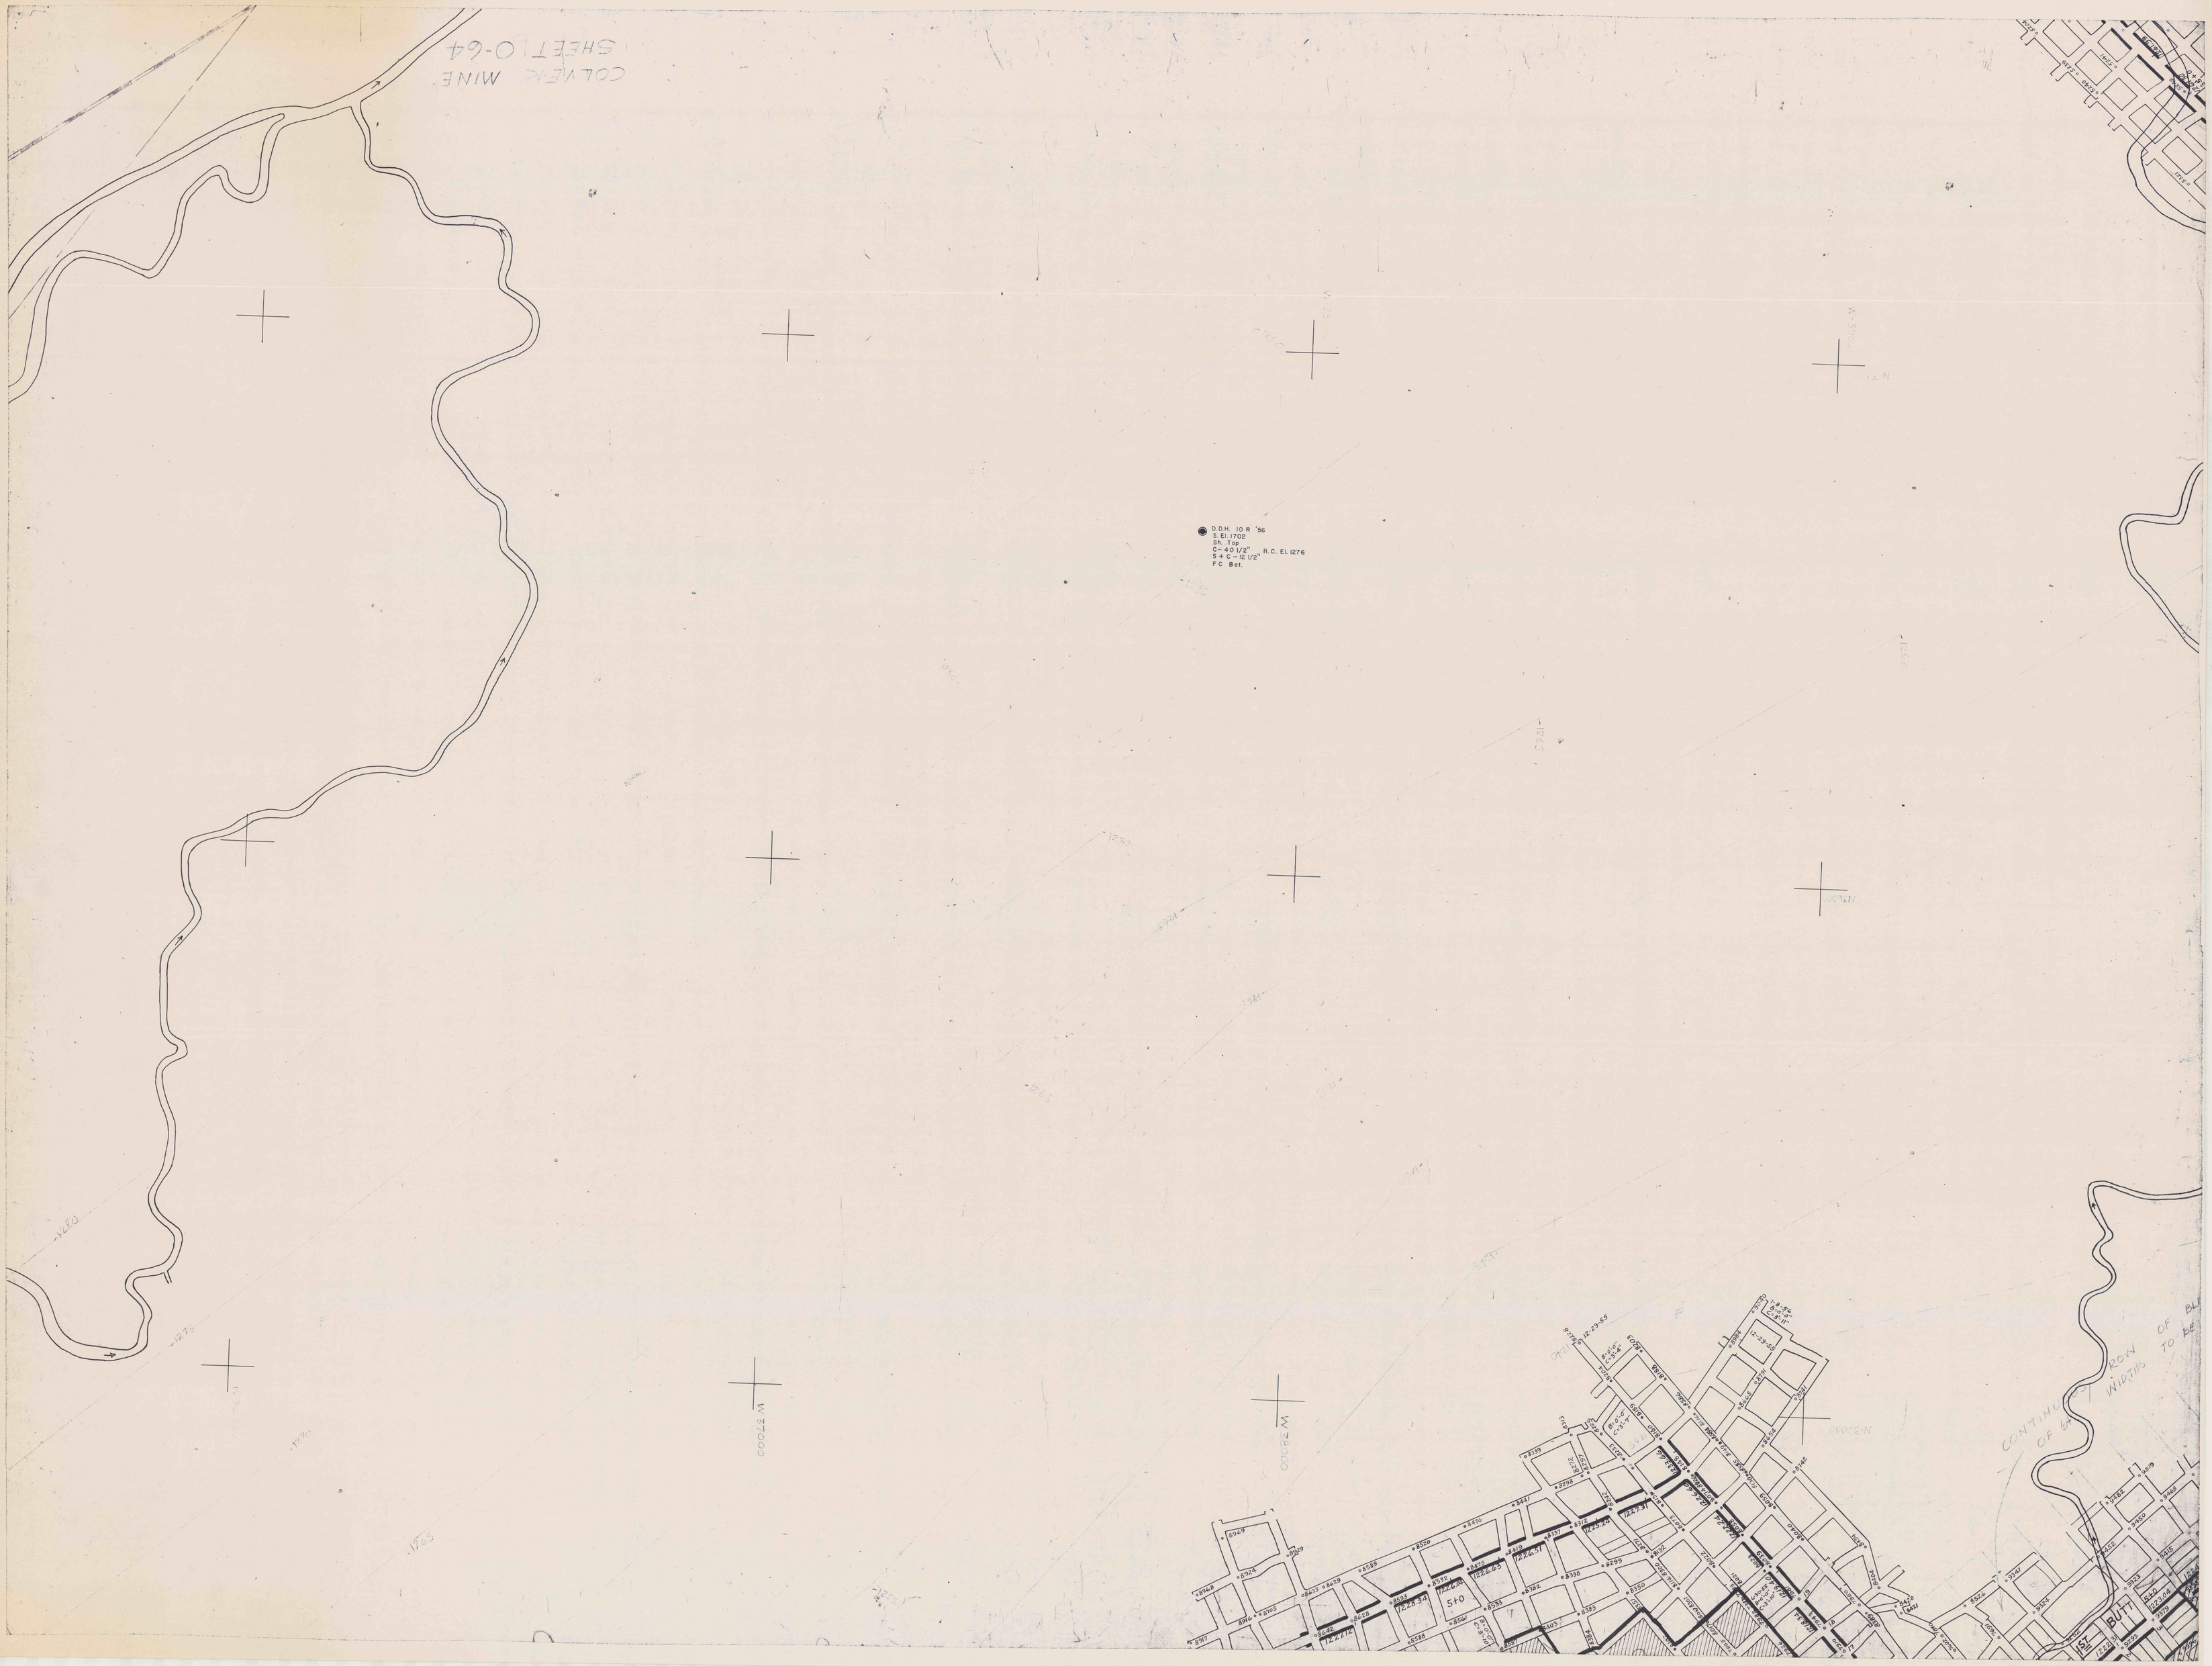
COLVER MINE
SHEET O-64
D.D.H. 10 R '56
S. El. 1702
Sh. Top
C- 40 1/2"
S + C - 12 1/2"
FC Bot.
B.C. El. 1276
W 37000
W 38000
CONTINUOUS ROW OF BL
OF 64 WIDTHS TO BE
1ST BUTT