


GOLVER MINE SHEET 0-65

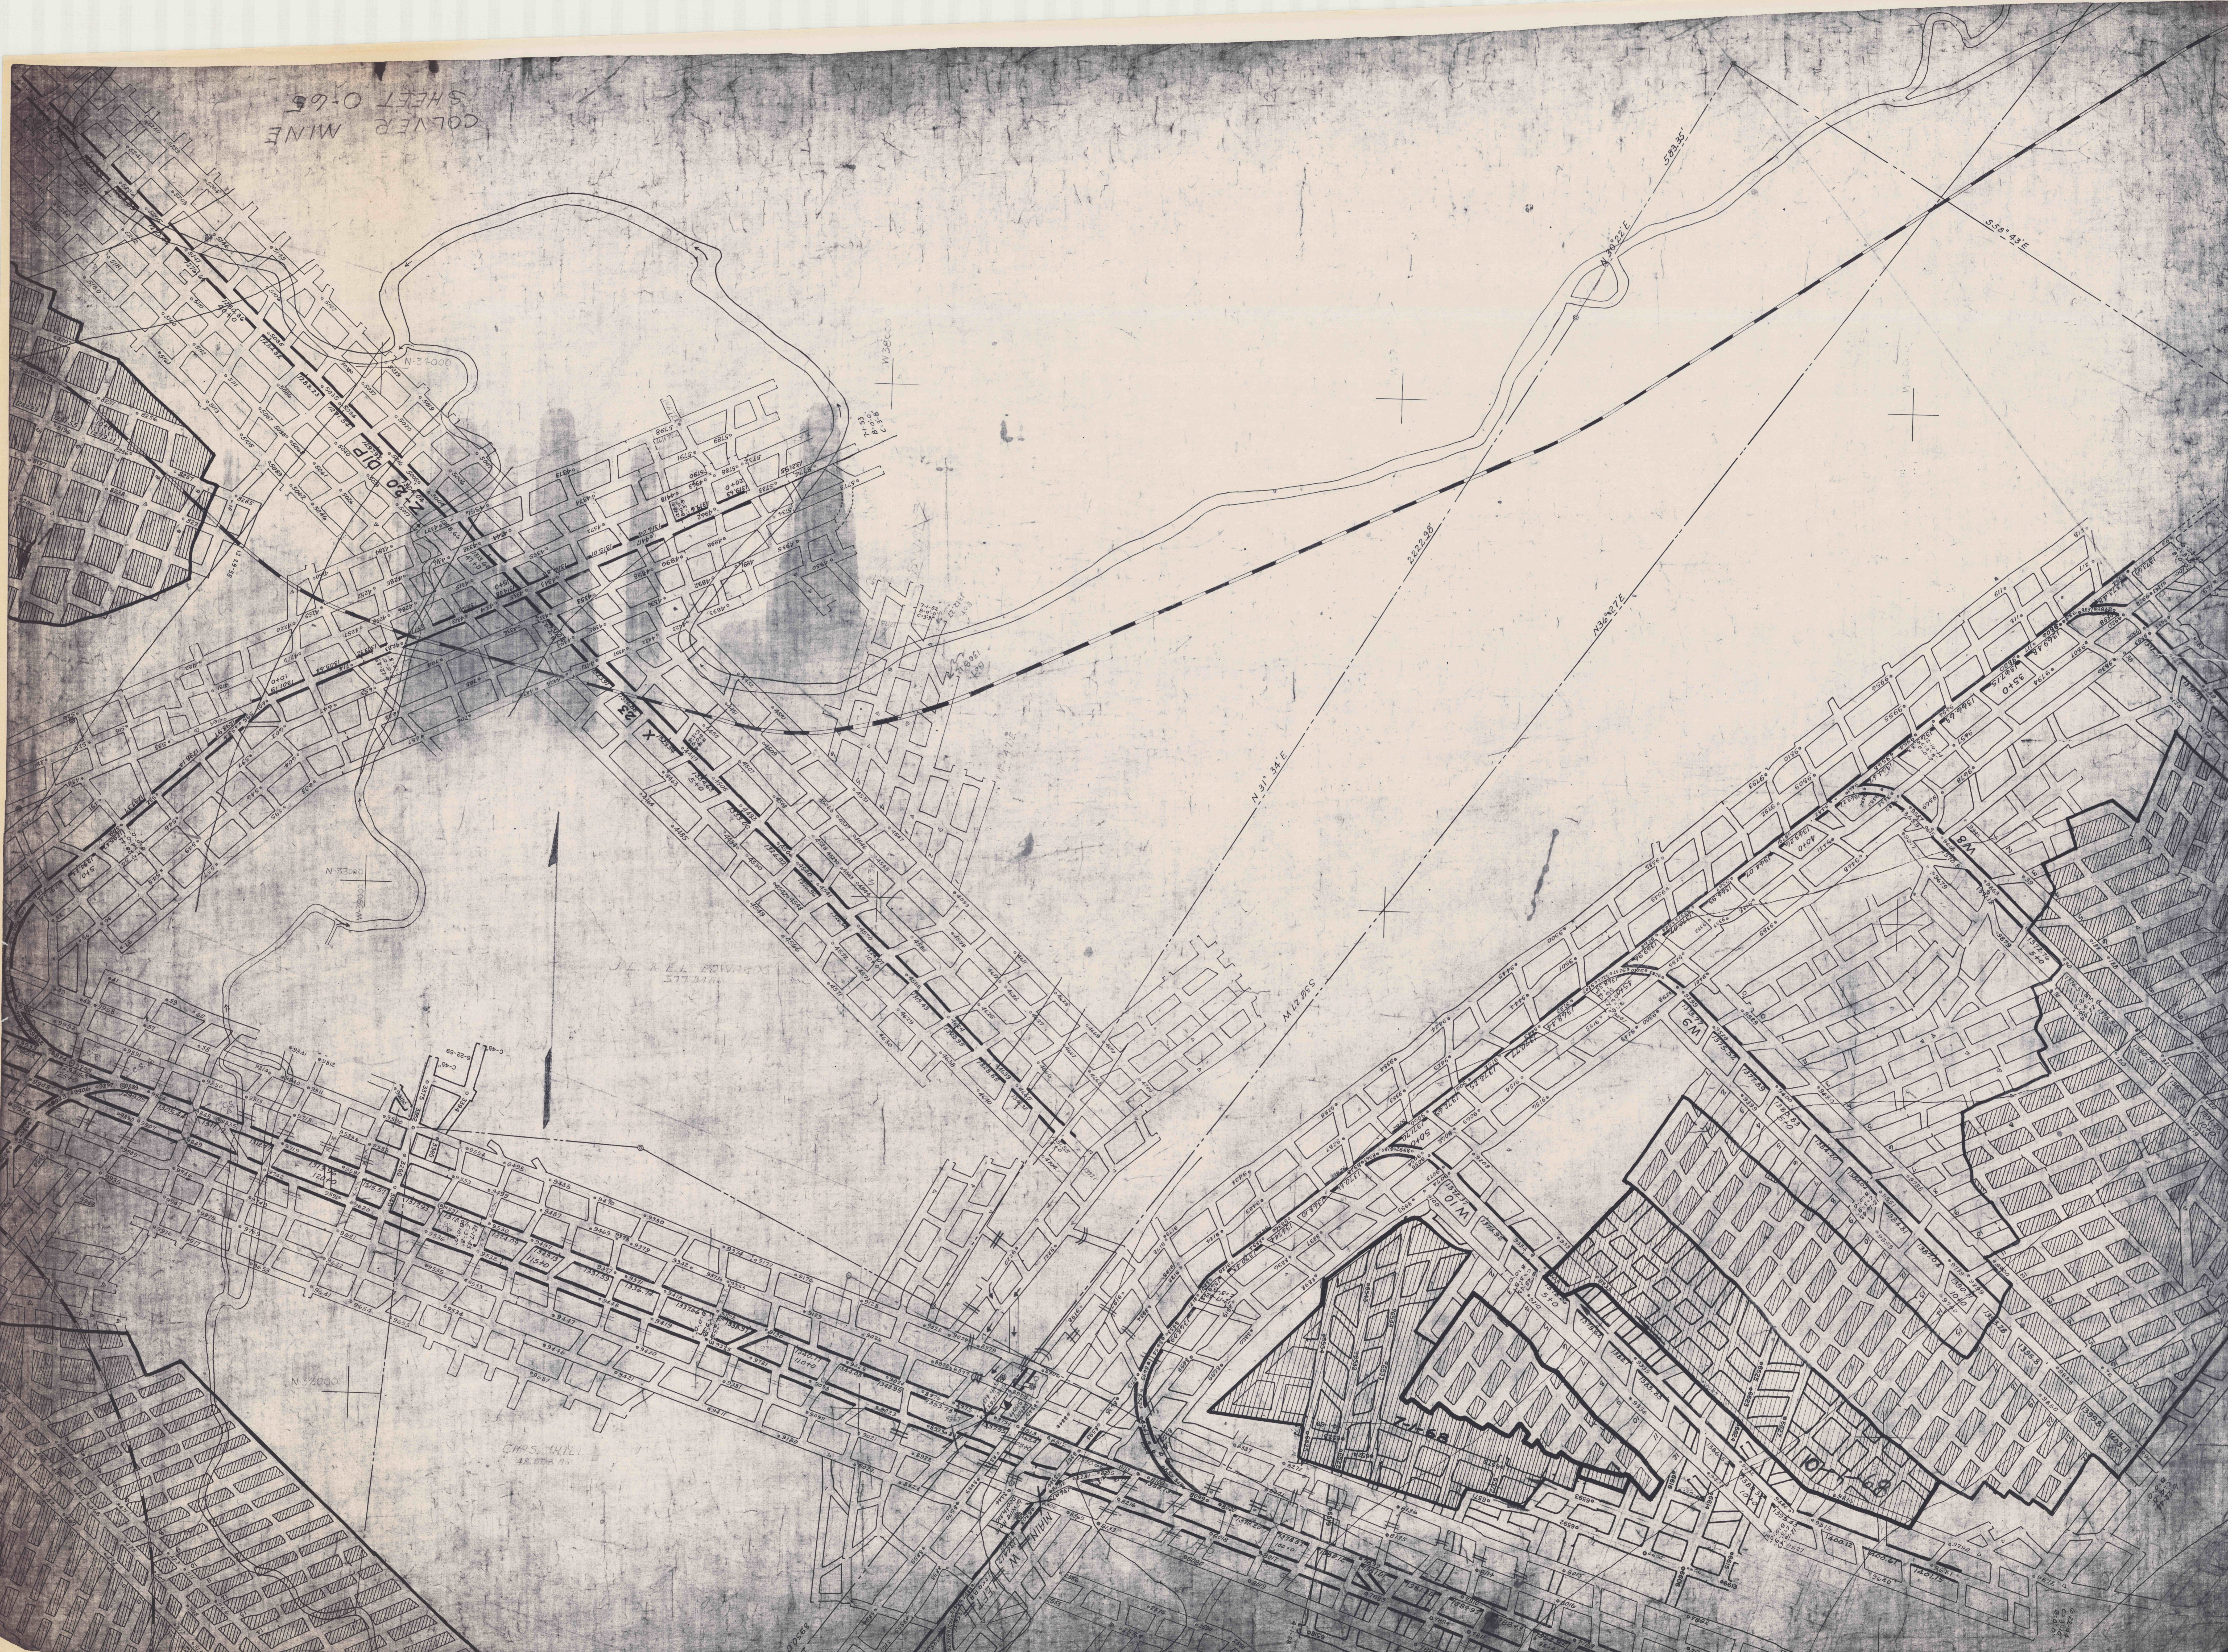

J.L. & E.A. EDWARDS
577 3111

CHAS. WILL
18 674 11

N 37 00 0

N 31 34 1

M 12 85 5

N 36 47 2

S 29 35

S 50 45 1

