


SHEET 0-72

N 79° 58' W

2179.44

N 70° 40' W

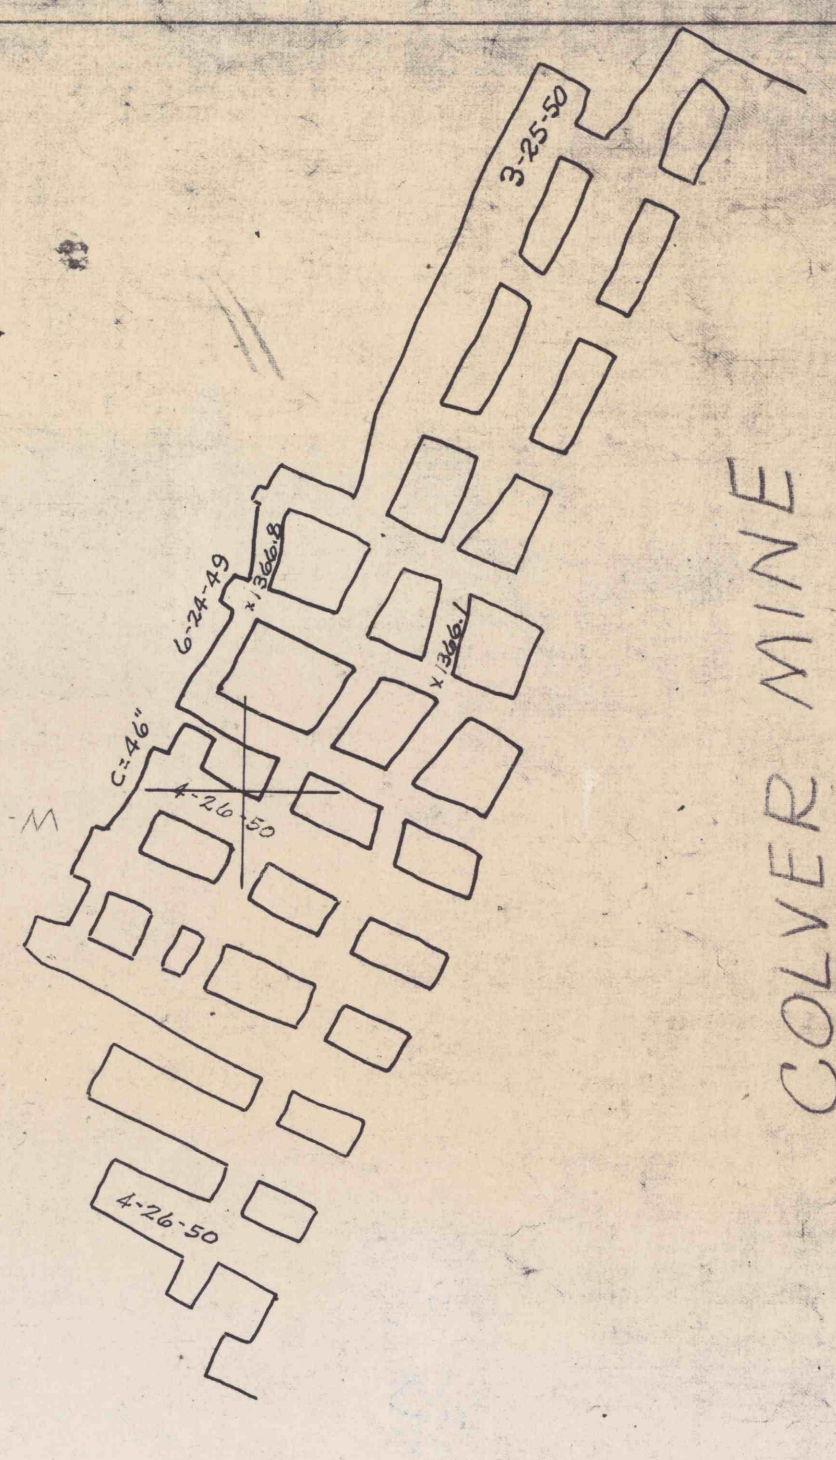

COLVER MINE
SHEET 0-72

W 41000

W 42000

W 50000

W 43000

N 23000